
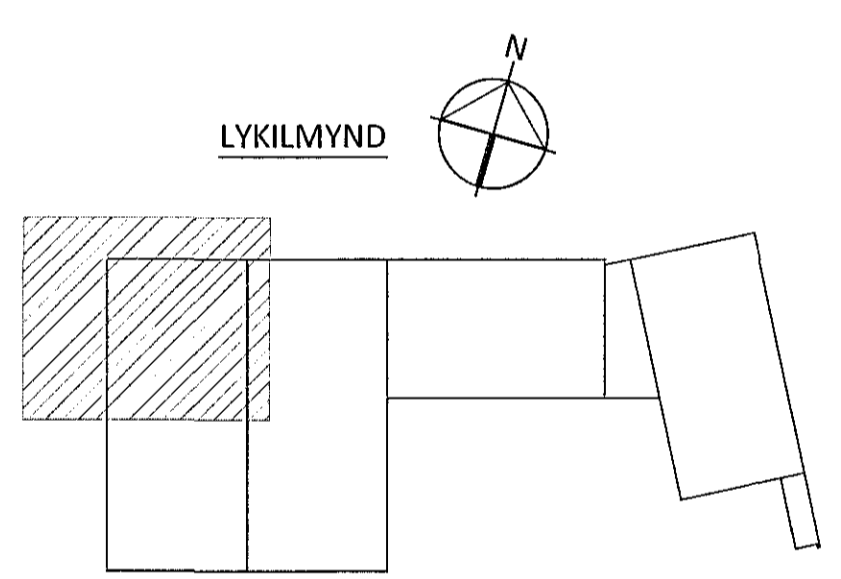


1. HÆÐ - GRUNNMYND M1:50

ÁRITUN BYGGINGARFULTRÚA

Sambýkkt þann  
13. mars 2018  
Byggingarfulltrúin *[Signature]*

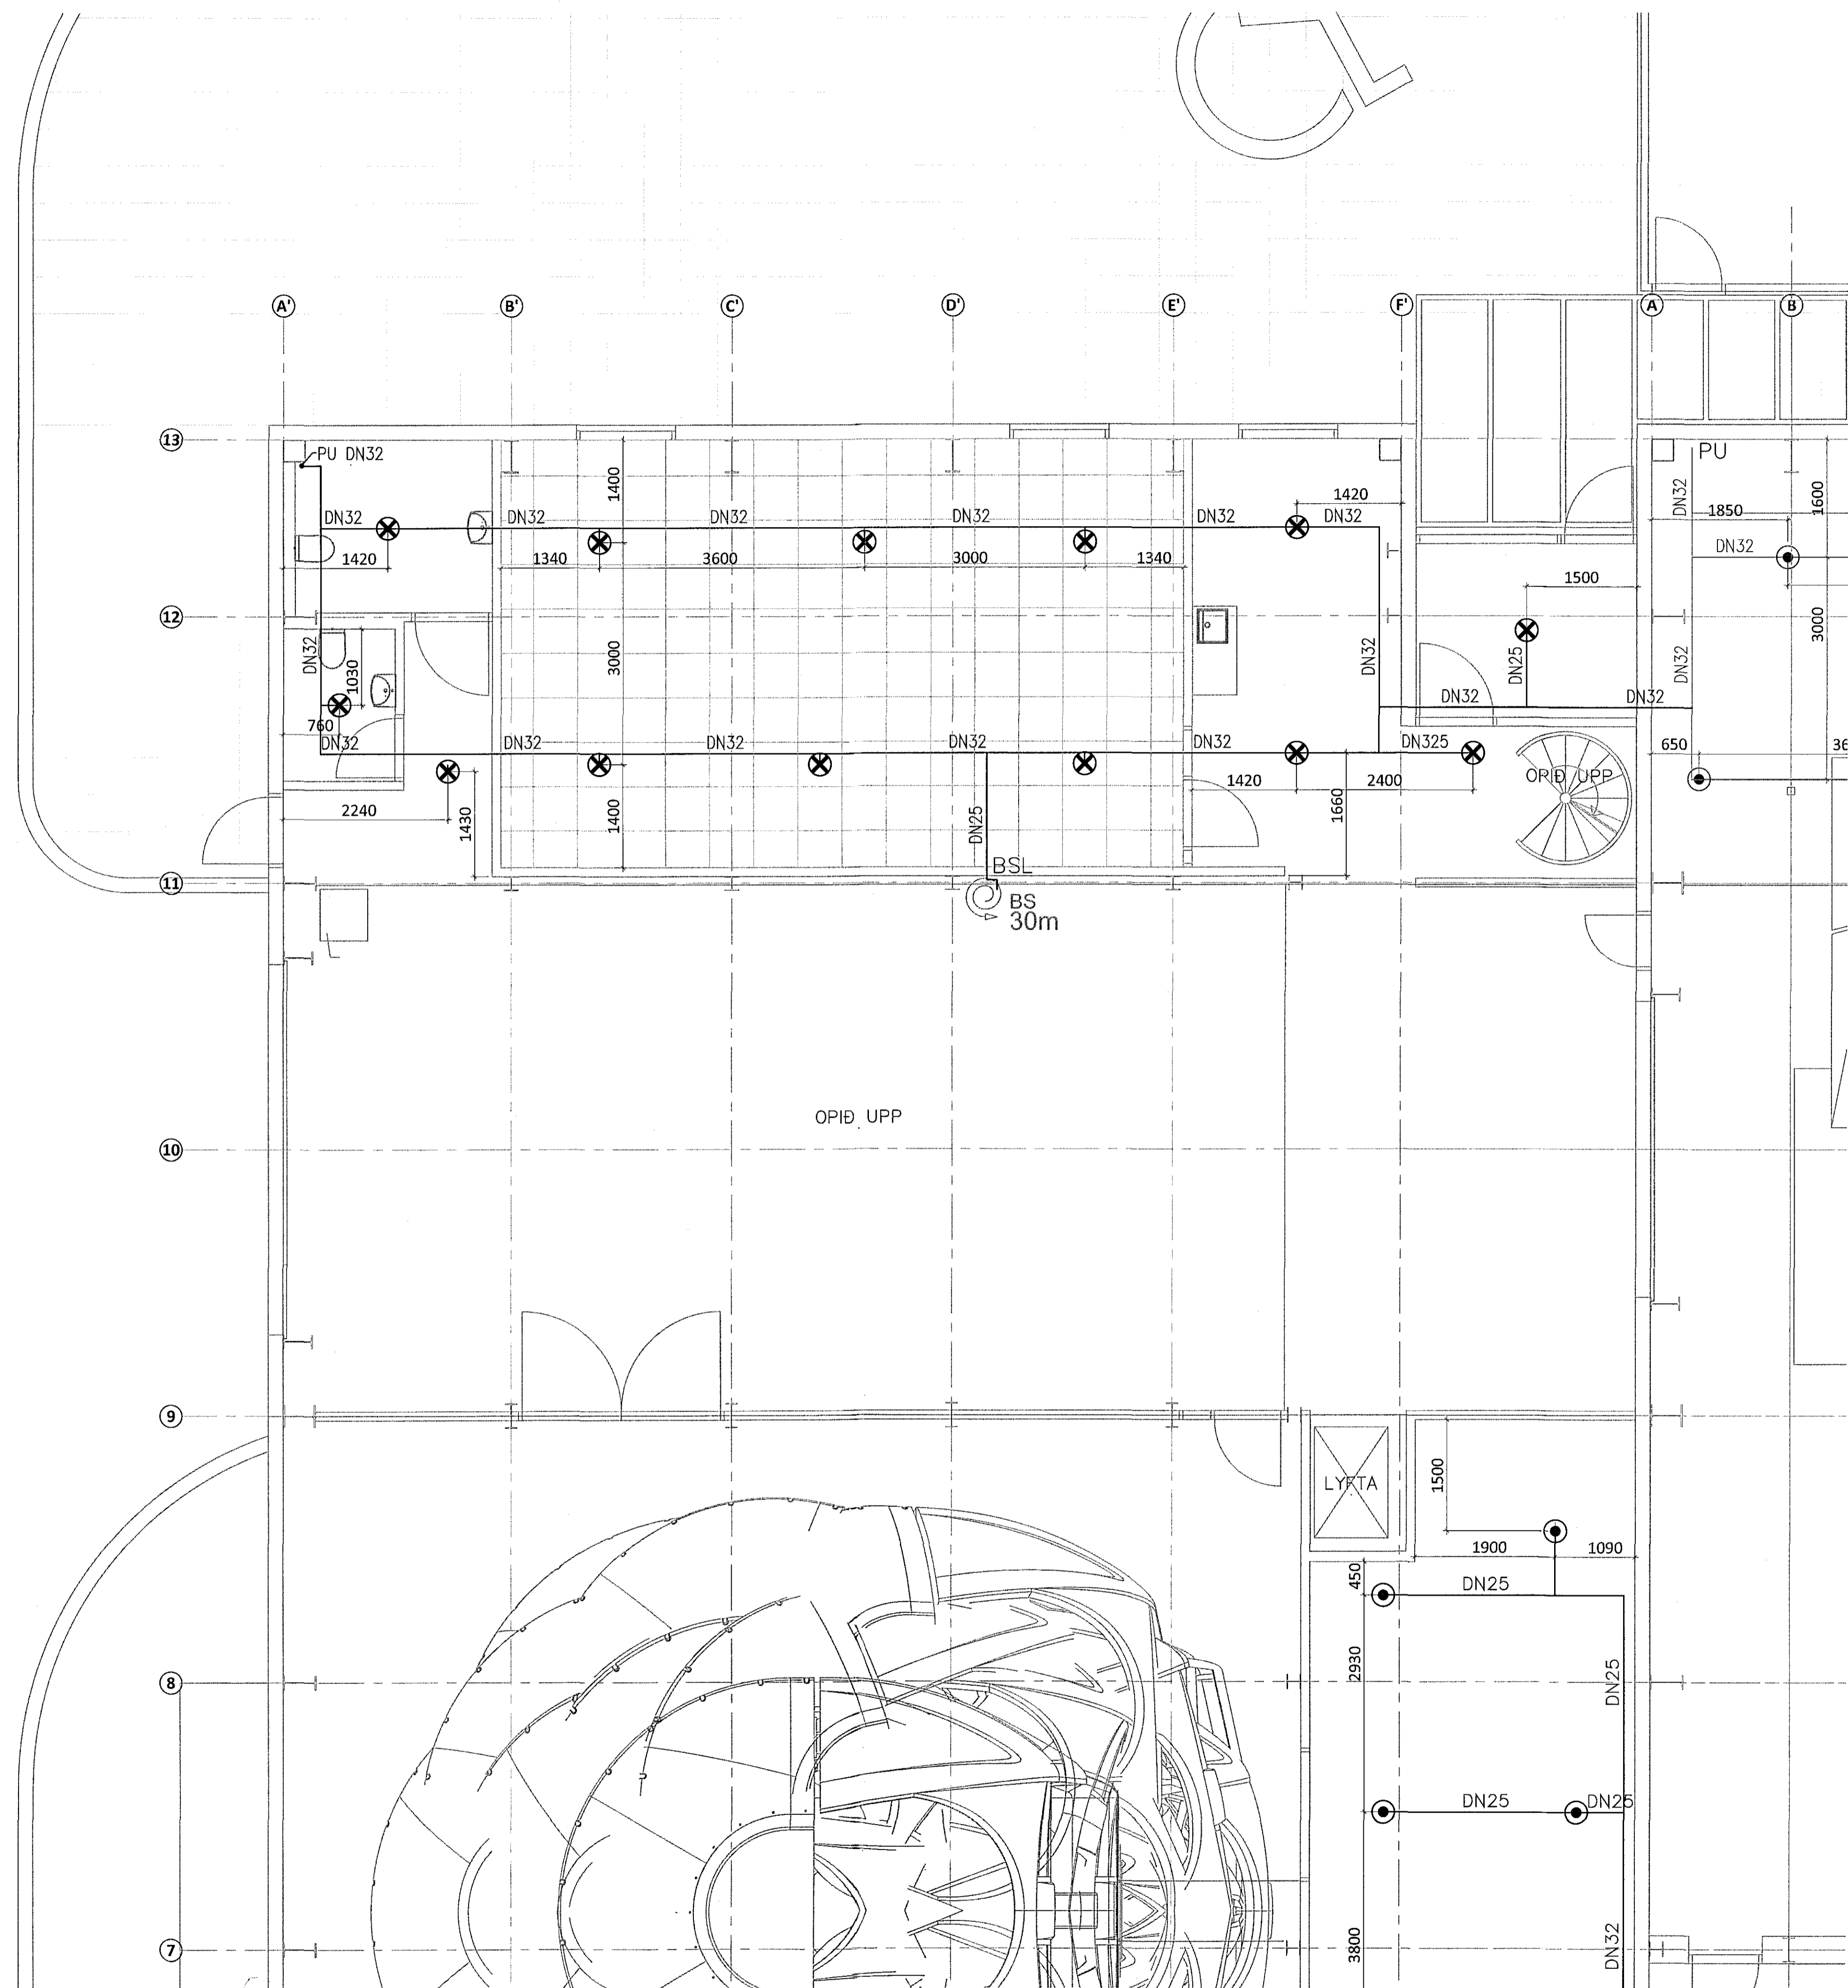

ÁRITUN AÐALHÖNDLUNAR: *[Signature]* KT. *[Signature]*

BR.	DAGS.	BREYTING	SAMP.
A 28.02.18 REYNDARTEIKNING			<i>[Signature]</i>



**FLUGVELLIR 1** HAFNARFIRDI  
NÝBYGGING  
VATNSÚÐAKERFI  
1. HÆÐ  
GRUNNMYND

SAMPYKKT:	KT. <i>[Signature]</i>		
HÖNNUNUR:	YFIRFARIÐ	DAGS. ÚTG.	DAGS. BREYT.
HBV	DAG	22.11.17	28.02.18
MKV.	VERKNR.	TEKN. NR.	BREYT.
1:50	14014	7-1106	A