
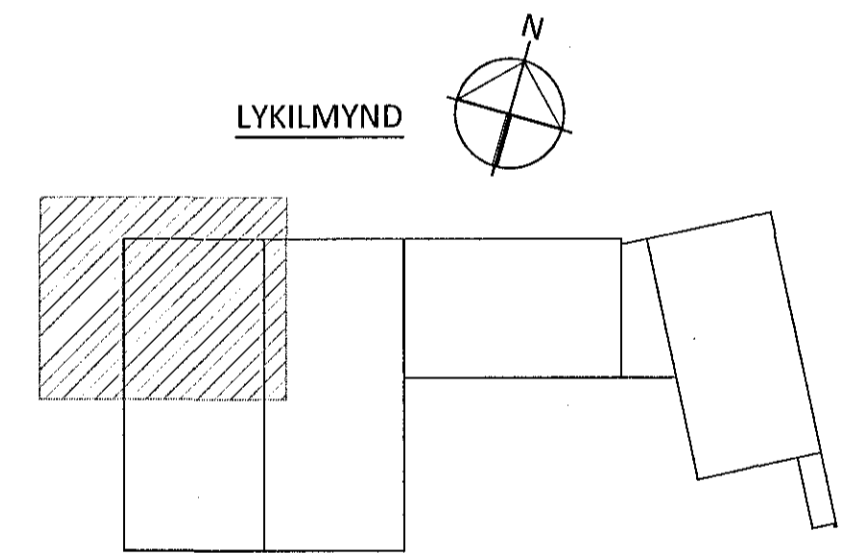


ÁRITUN BYGGINGARFULLTRÚA

Samþykkt þann  
13. mars 2018  
Byggingaformálinn í Hafnarfirði

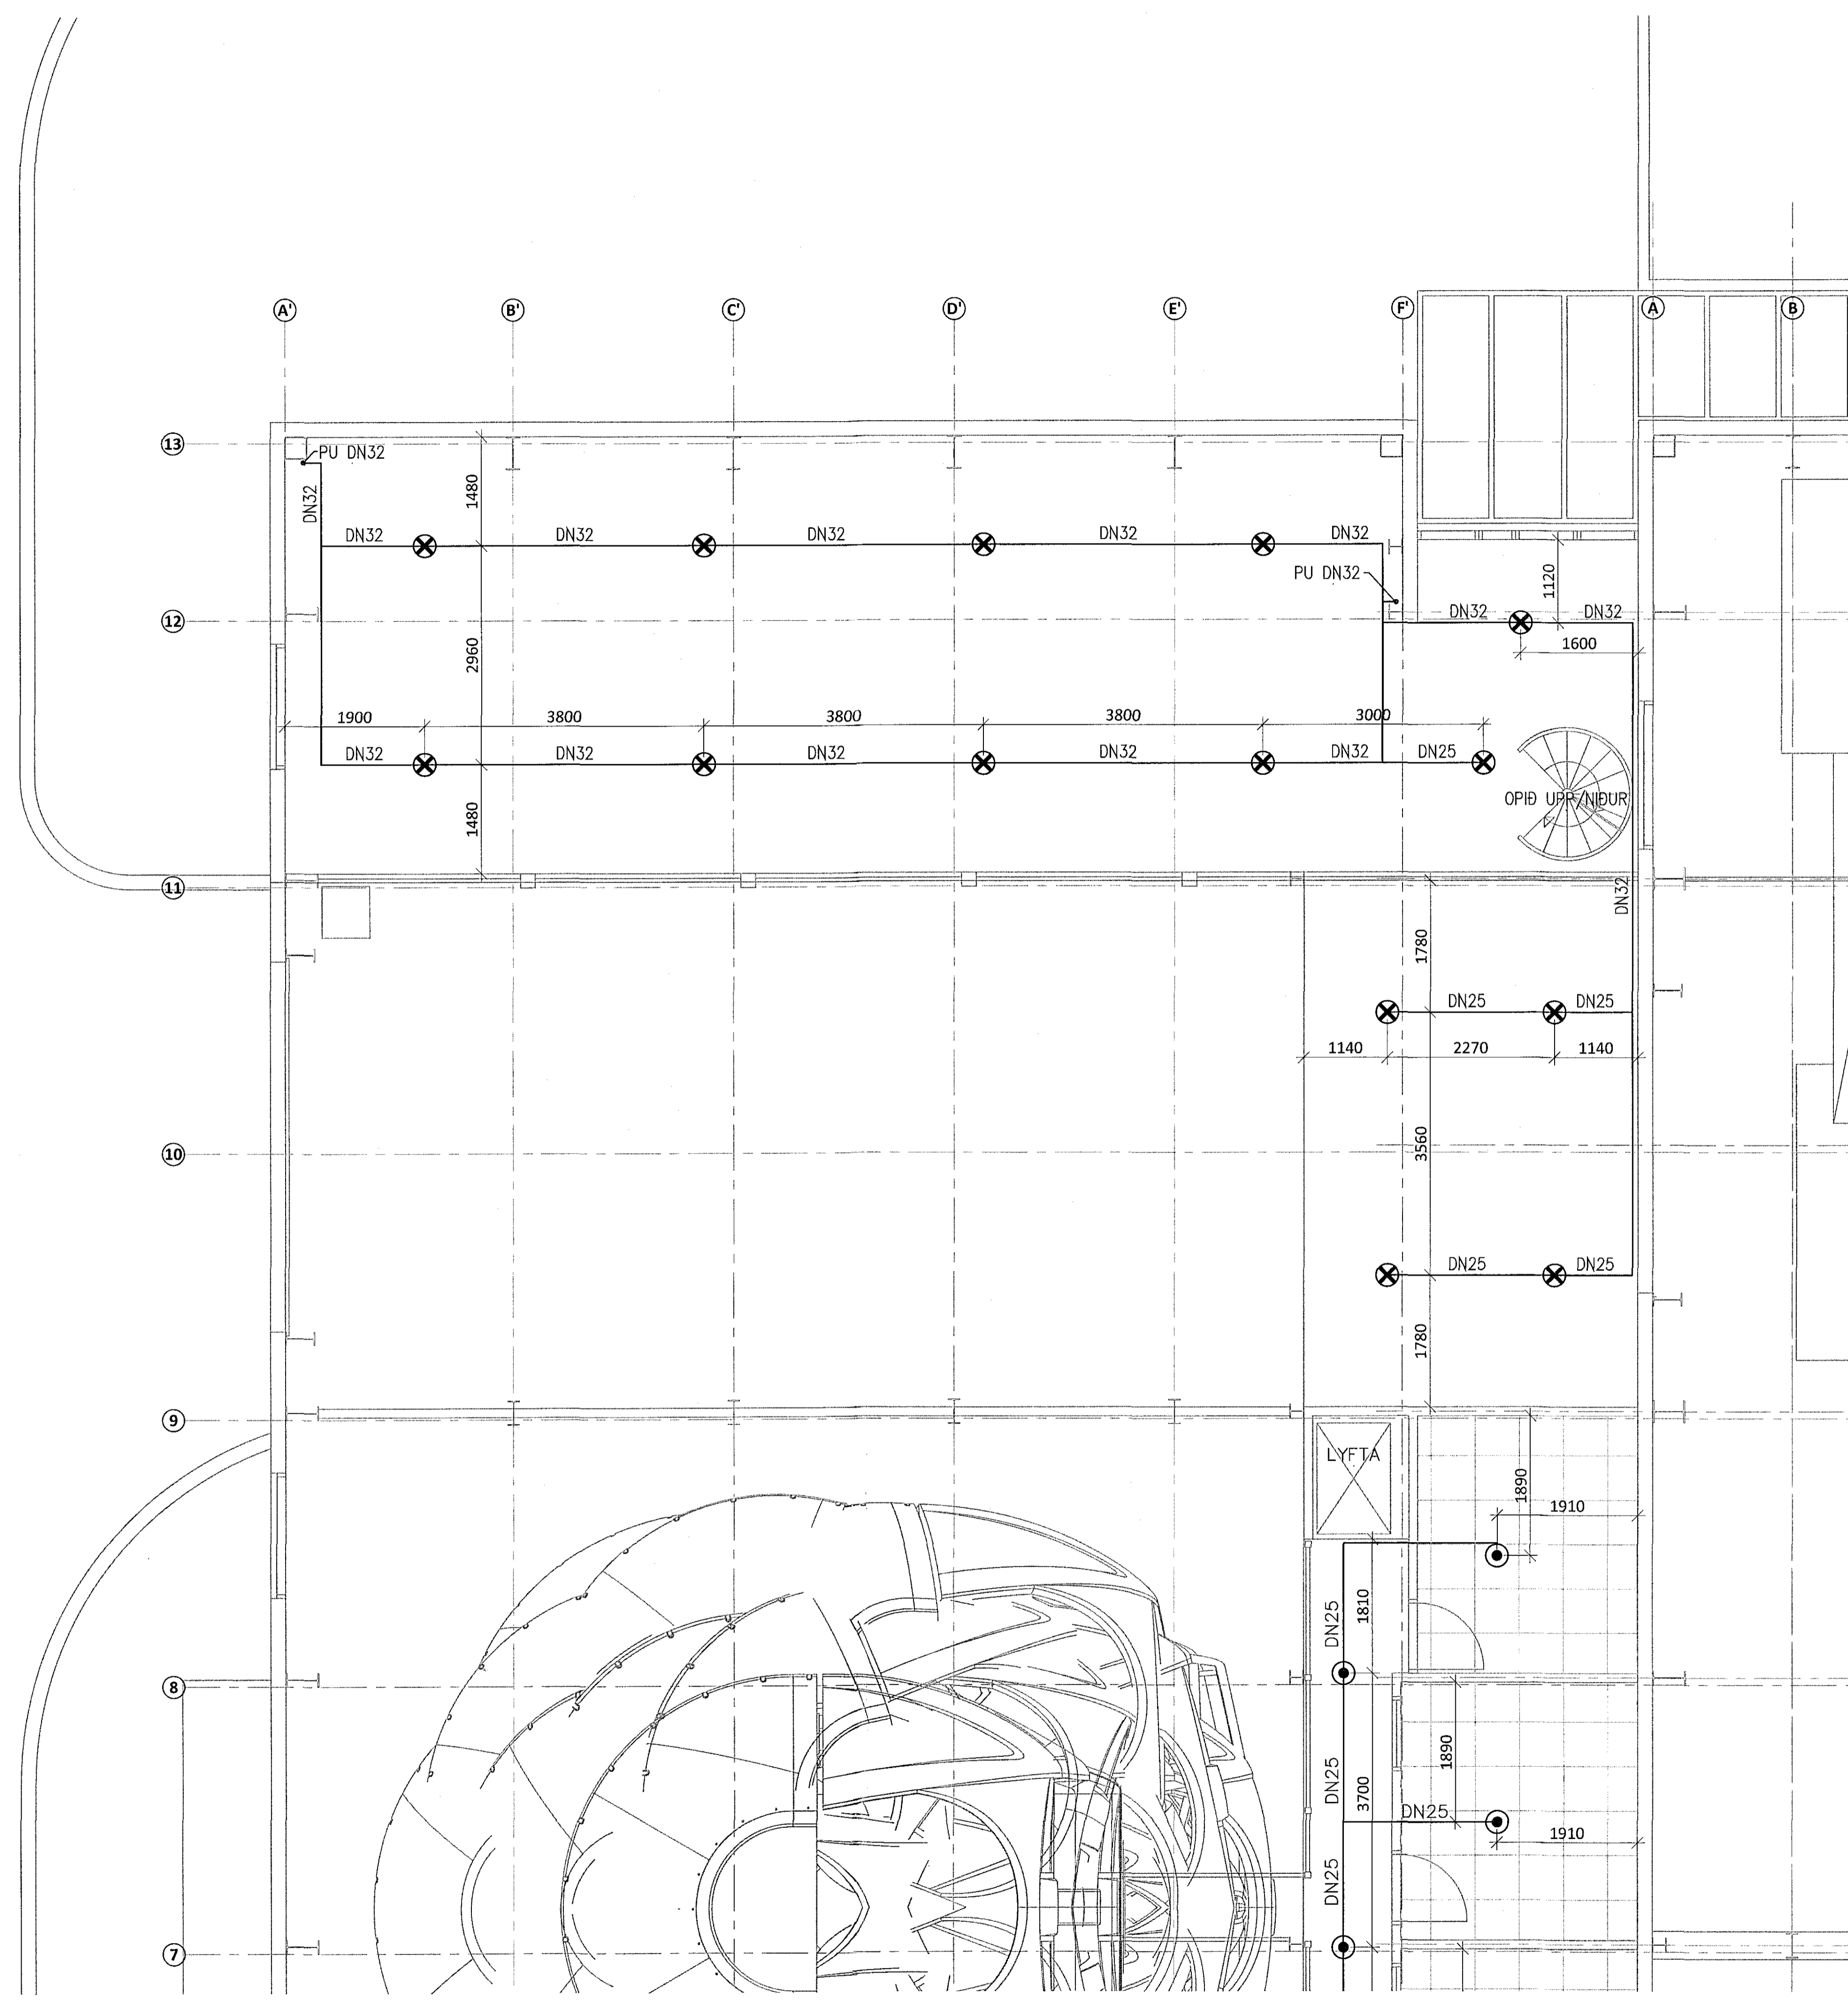

ÁRITUN AÐALHÖNNUNAR KT. 21.02.2019

A 28.02.18 REYNDARTEIKNING			
BR.	DAGS.	BREYTING	SAMP.

**ferill**  
VERKFRÆÐISTOFA

**FLUGVELLIR 1** HAFNARFIRÐI  
NÝBYGGING

VATNSÚÐAKERFI  
2. HÆÐ  
GRUNNMYND

SAMÞYKKT: *Ólafur Gunnarsson* KT. 270760-4229

HÖNNUNUR	YFIRFARIR	DAGS. ÚTGF.	DAGS. BREYT.
HDV hjalti@ferill.is	DAG	22.11.17	28.02.18
MKV.	VERKNR.	TEKNI. NR.	BREYT.
1:50	14014	7 - 1206	A

Ferill ehf. Mörkin 1 108 Reykjavík Sími: 575 1600 Fax: 575 1601 www.ferill.is