
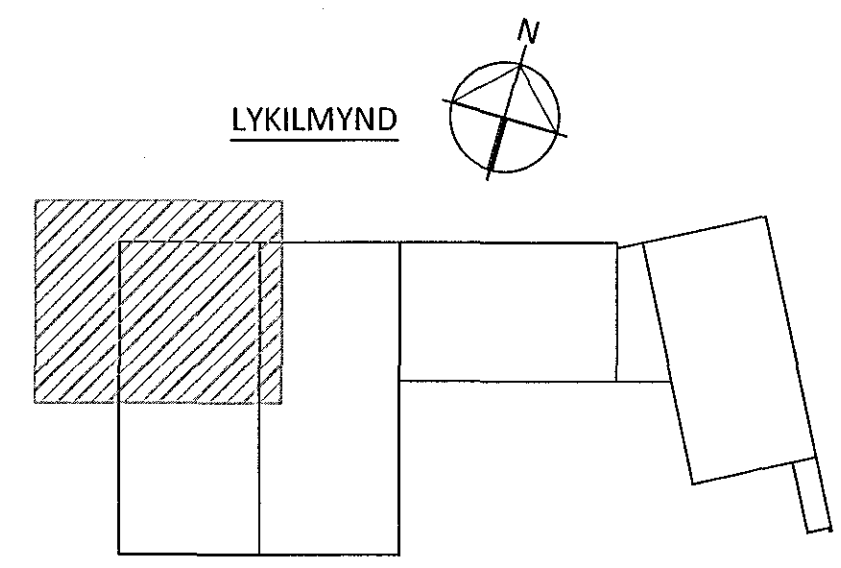


3. HÆÐ - GRUNNMYND M1:50

ÁRITUN BYGGINGARFULLTRÖA
 Samþykkt þann
 13. Mars 2018
 Byggingarfulltrúi / Hl. Gunnars

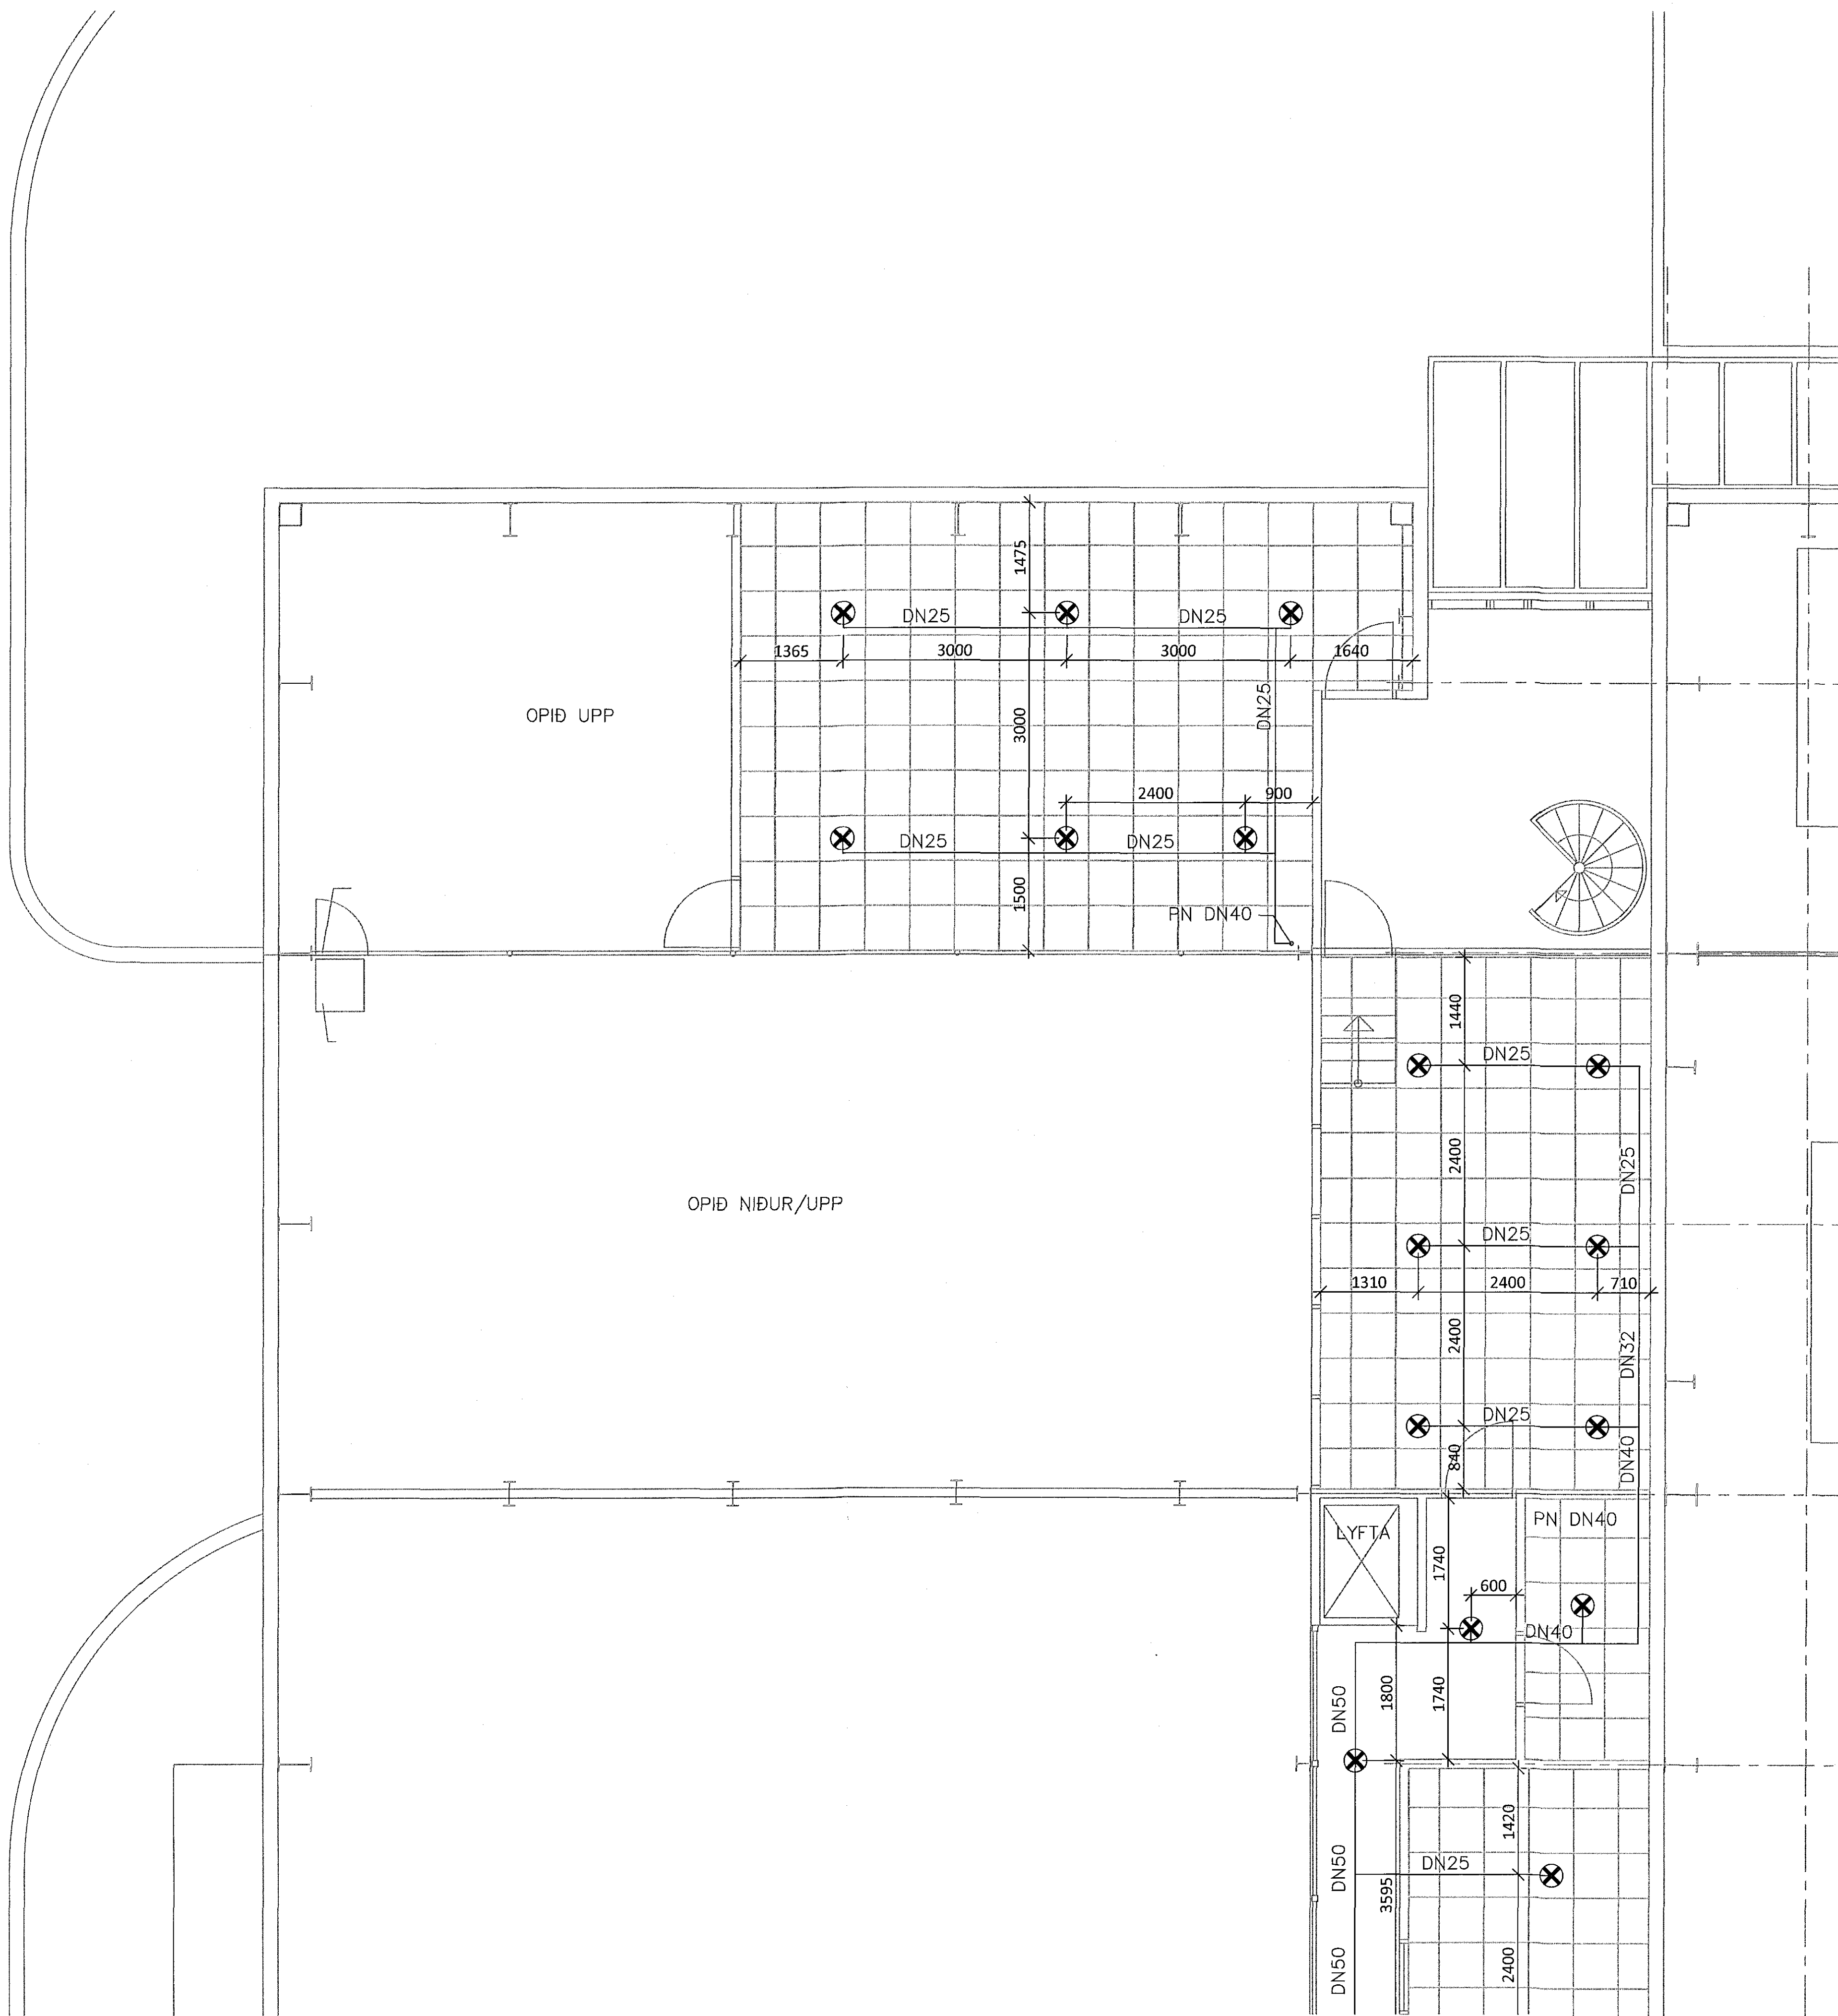

ÁRITUN AÐALHÖNNUNÐAR: KT. Gunnars 2017

A 28.02.18 REYNDARTEIKNING			HPV
BR.	DAGS.	BREYTING	SAMP.



FLUGVELLIR 1 HAFNARFIRDI
 NÝBYGGING
 VATNSÚÐAKERFI
 3. HÆÐ
 GRUNNMYND

SAMPYKKT: KT. Gunnars 270760-4229 HPV

HÖNNUNUR	YFIRFARIÐ	DAGS. ÚTG.	DAGS. BREYT.
HPV	hjatn@ferill.is	22.11.17	28.02.18
MKV.	VERKNR.	TEKNI. NR.	BREYTI.
1:50	14014	7 - 1306	A