
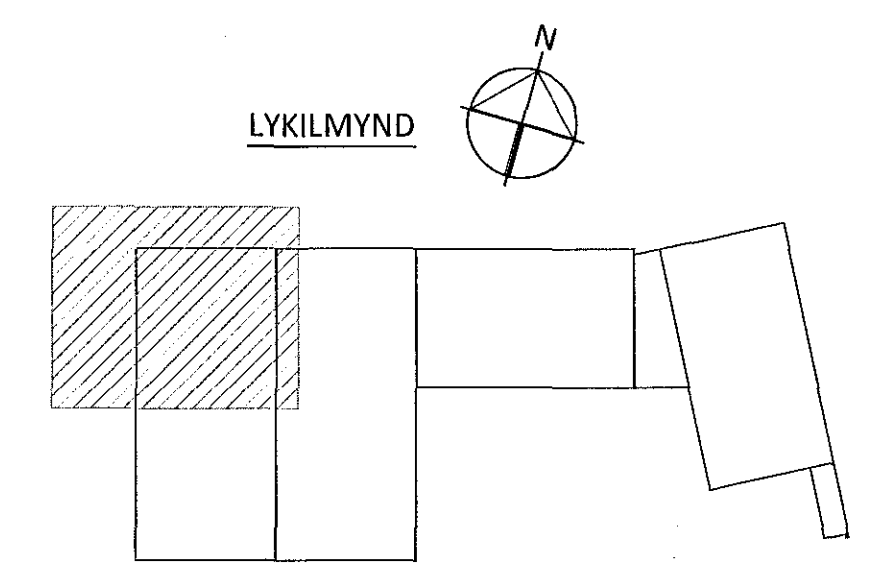


Samþykkt þann  
13. mars 2018  
Byggingarfulltrúinn *[Signature]*

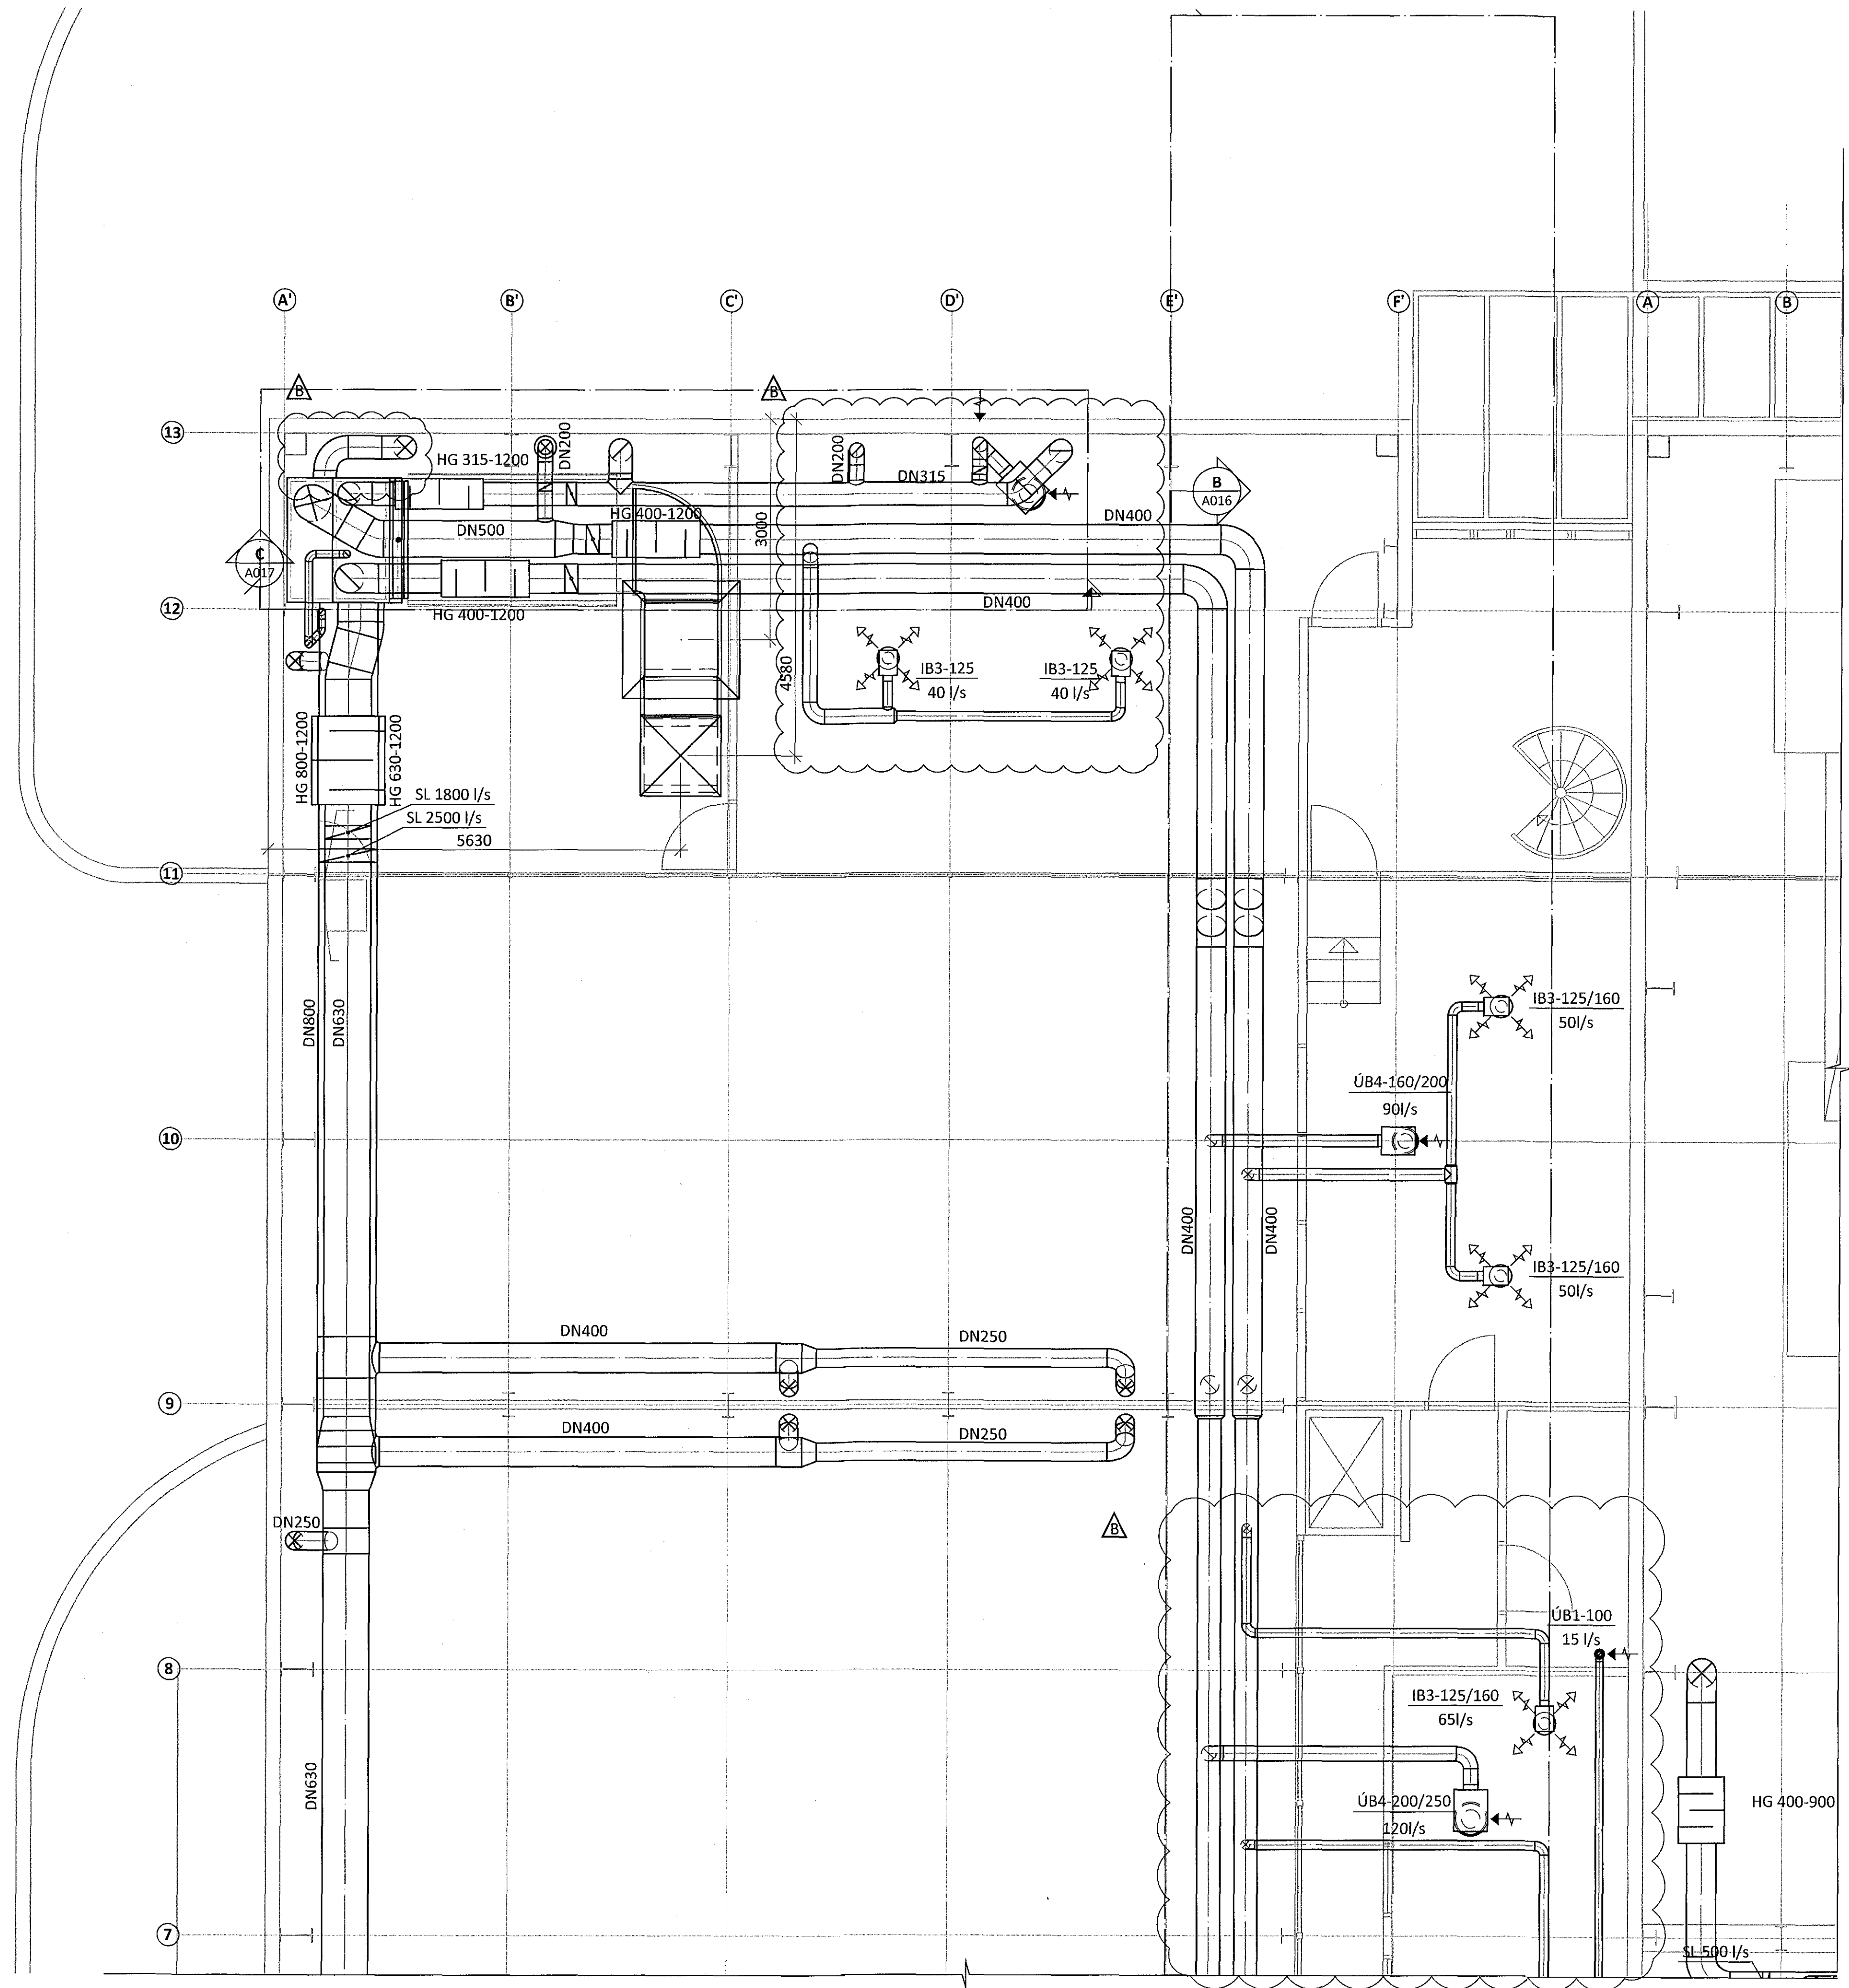

ÁRITUN AFALHÖNNUSAR KT. *[Signature]* 04/05/2019  
SJÁ ALMENNAR SKÝRINGAR Á TEIKNINGU 14014-5-A000

B 05.03.18 BREYTT SKIPULAG				AKG
A 08.11.17 BREYTINGAR Á LEGU LAGNA				
BR.	DAGS.	BREYTING		SAMP.
<b>ferill</b> VERKFRÆÐISTOFA				
<b>FLUGVELLIR 1</b>		HAFNARFIRÐI		
NÝBYGGING				
LOFTRÆSIKERFI				
3.HÆÐ				
GRUNNMYND				
SAMÞYKKT <i>[Signature]</i> KT. 270760-4229		AKG		
HÖNNUÐUR	YRIRFARID	DAGS. UTG.	DAGS. BREYT.	
ASF	PAG	26.09.17	05.03.18	
MKV.	VERKNR.	TEIKN. NÚL.	BREYT.	
1:50	14014	5 - 1306	B	
Ferill ehf. Mörkin 1 108 Reykjavík Sími: 575 1600 Fax: 575 1601 www.ferill.is				