
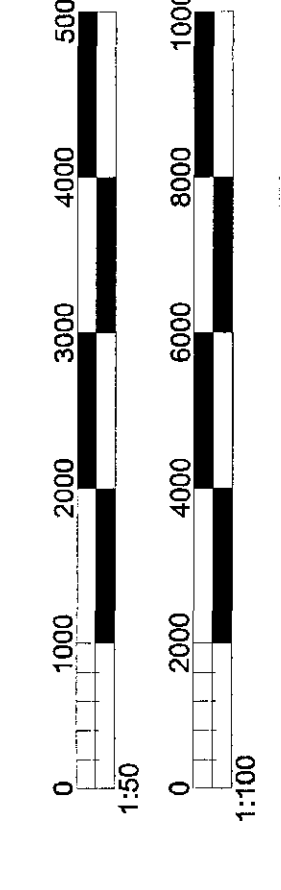
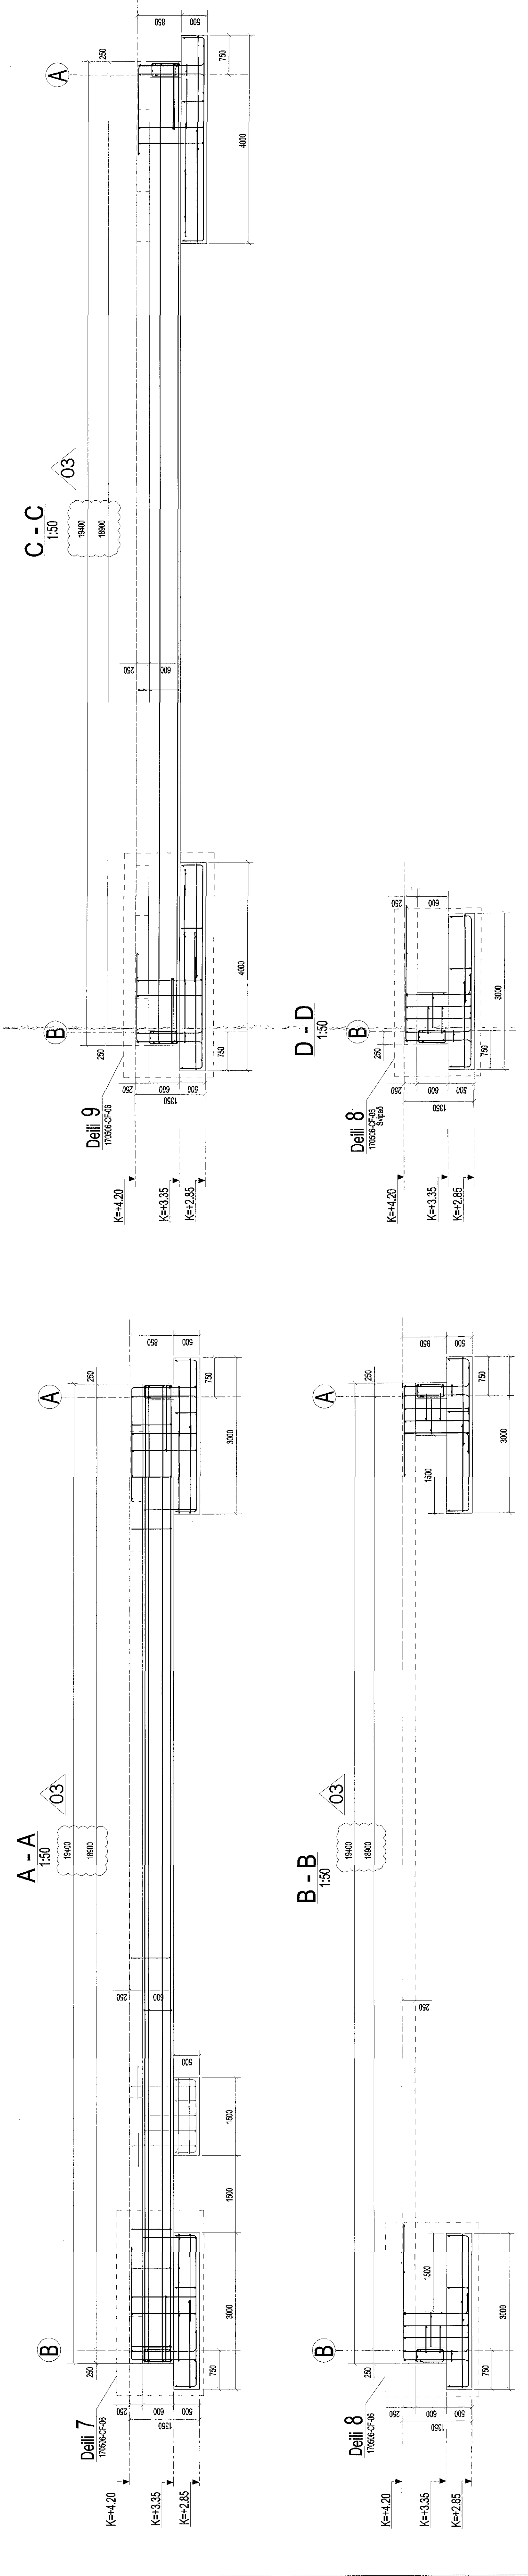


Grunnmynd  
Alengur 1,2,3, Krafur 1:50

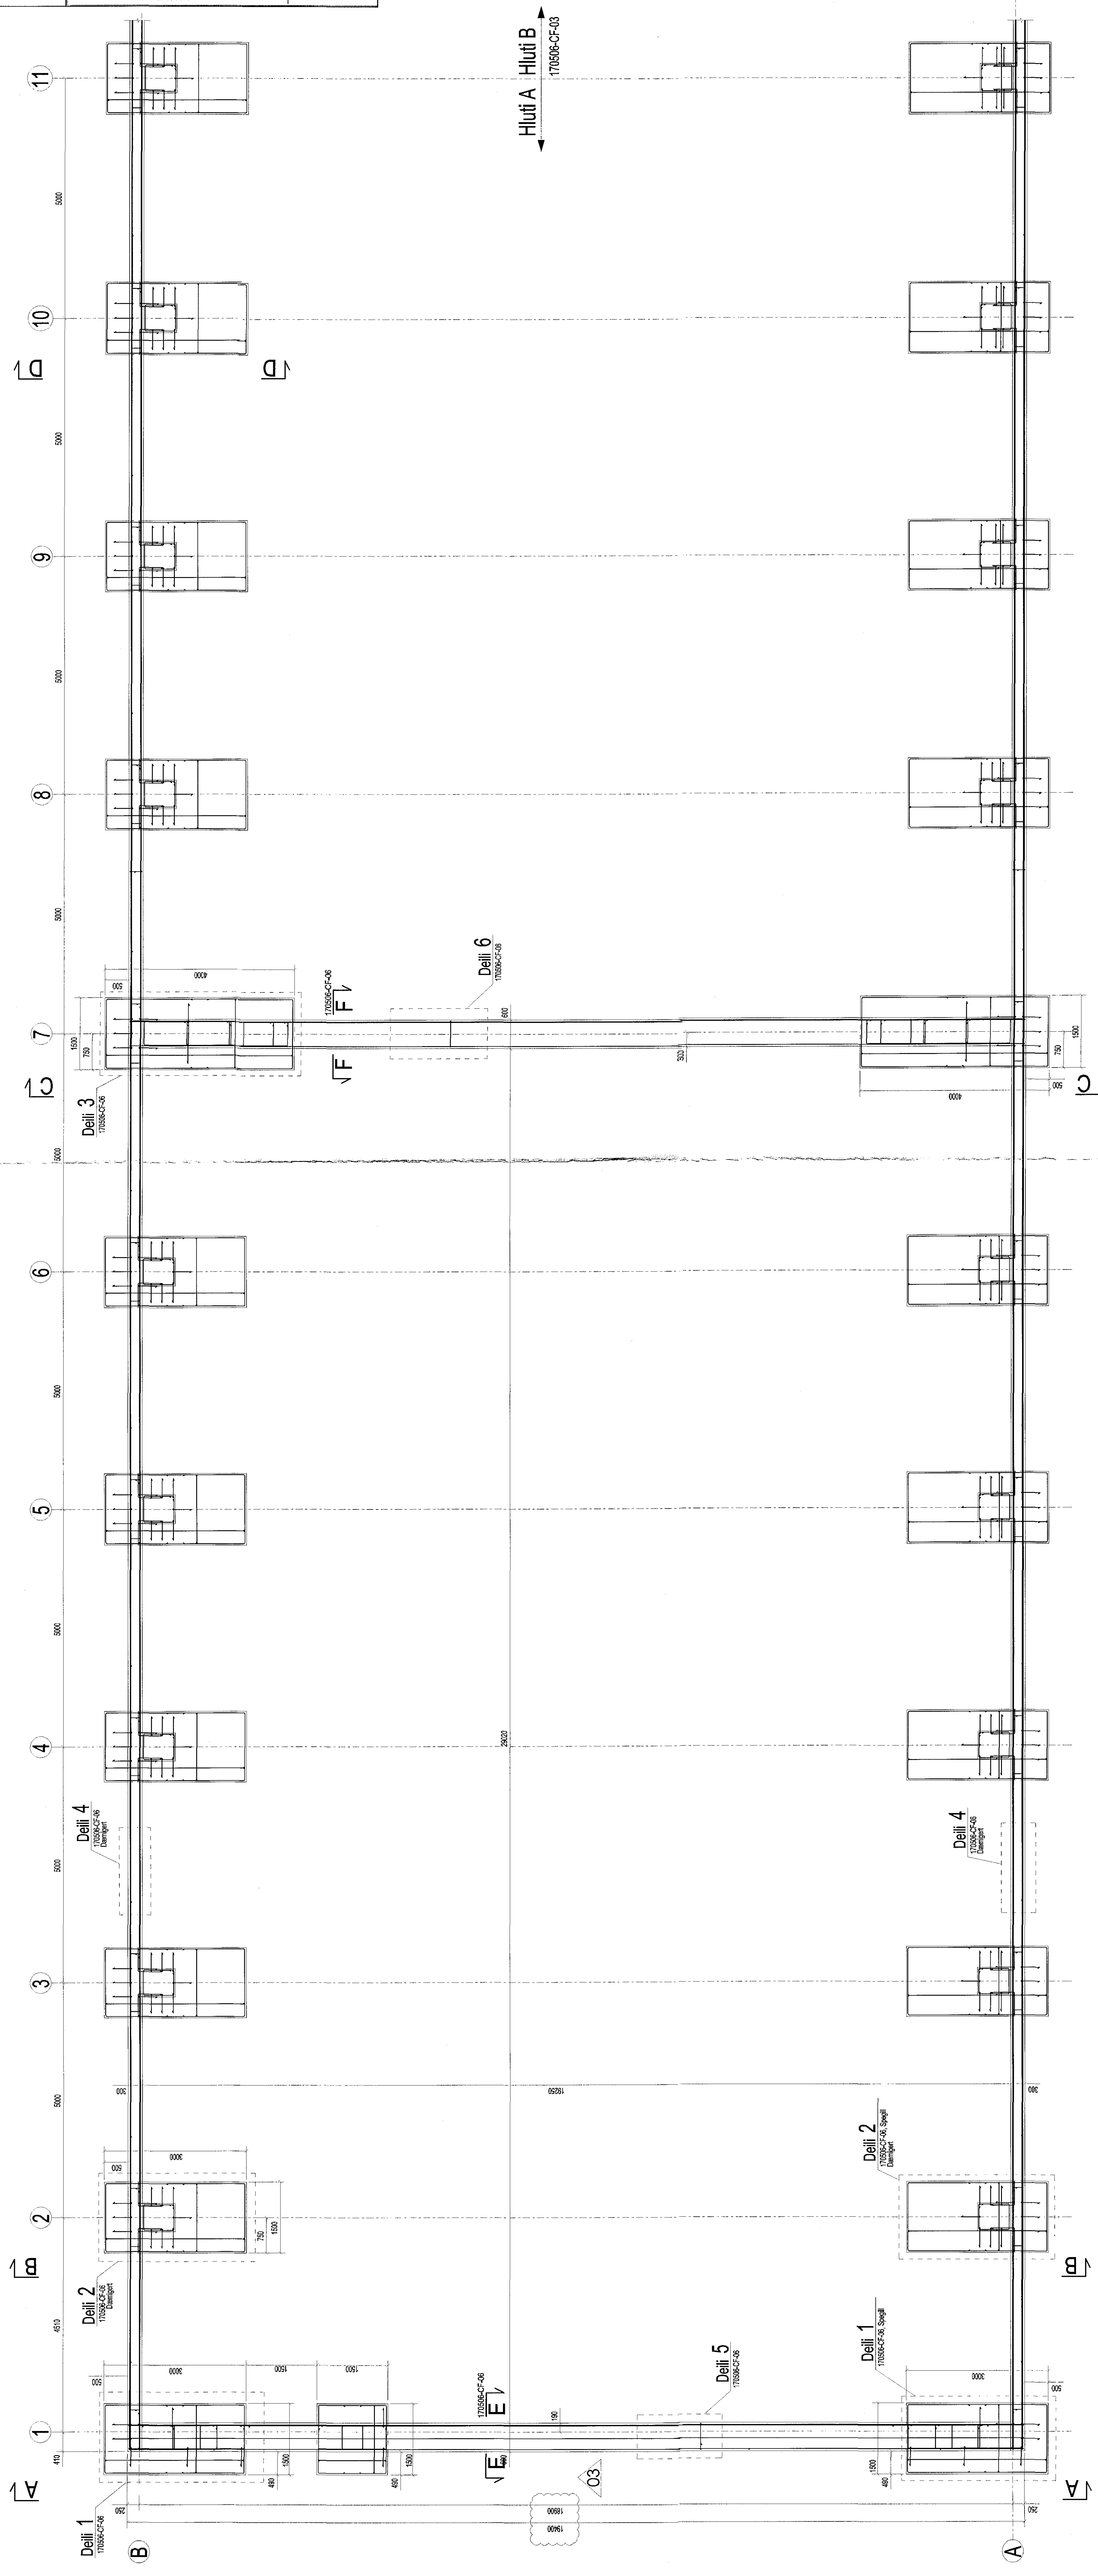

1. ÖLL MÁL ERSU (Tegul)
2. MALAR MÆRIR ERU (Tegul)
3. SKYRIRNGAR, K-KÖTL, c/c-MBJA I MBJU
4. STENSTEIPLA B30

Brögur	Stig	Staðfesting	Lýsing	Tilhamm




Verki  
OSEYRARBRAUT 20, MHL02  
Oseyrarsævi 20, 220 Hafnarfjörður, Ísland

Netið  
UNDRISTÖÐIR - HLUTI A  
GRUNNMYND SÍÐ SERMINDR

Öskun  
AARÞORR  
Sýsluábyrging  
