


Samþykkt þann
25. maí 2018
Byggingaálfuráráðgjafi

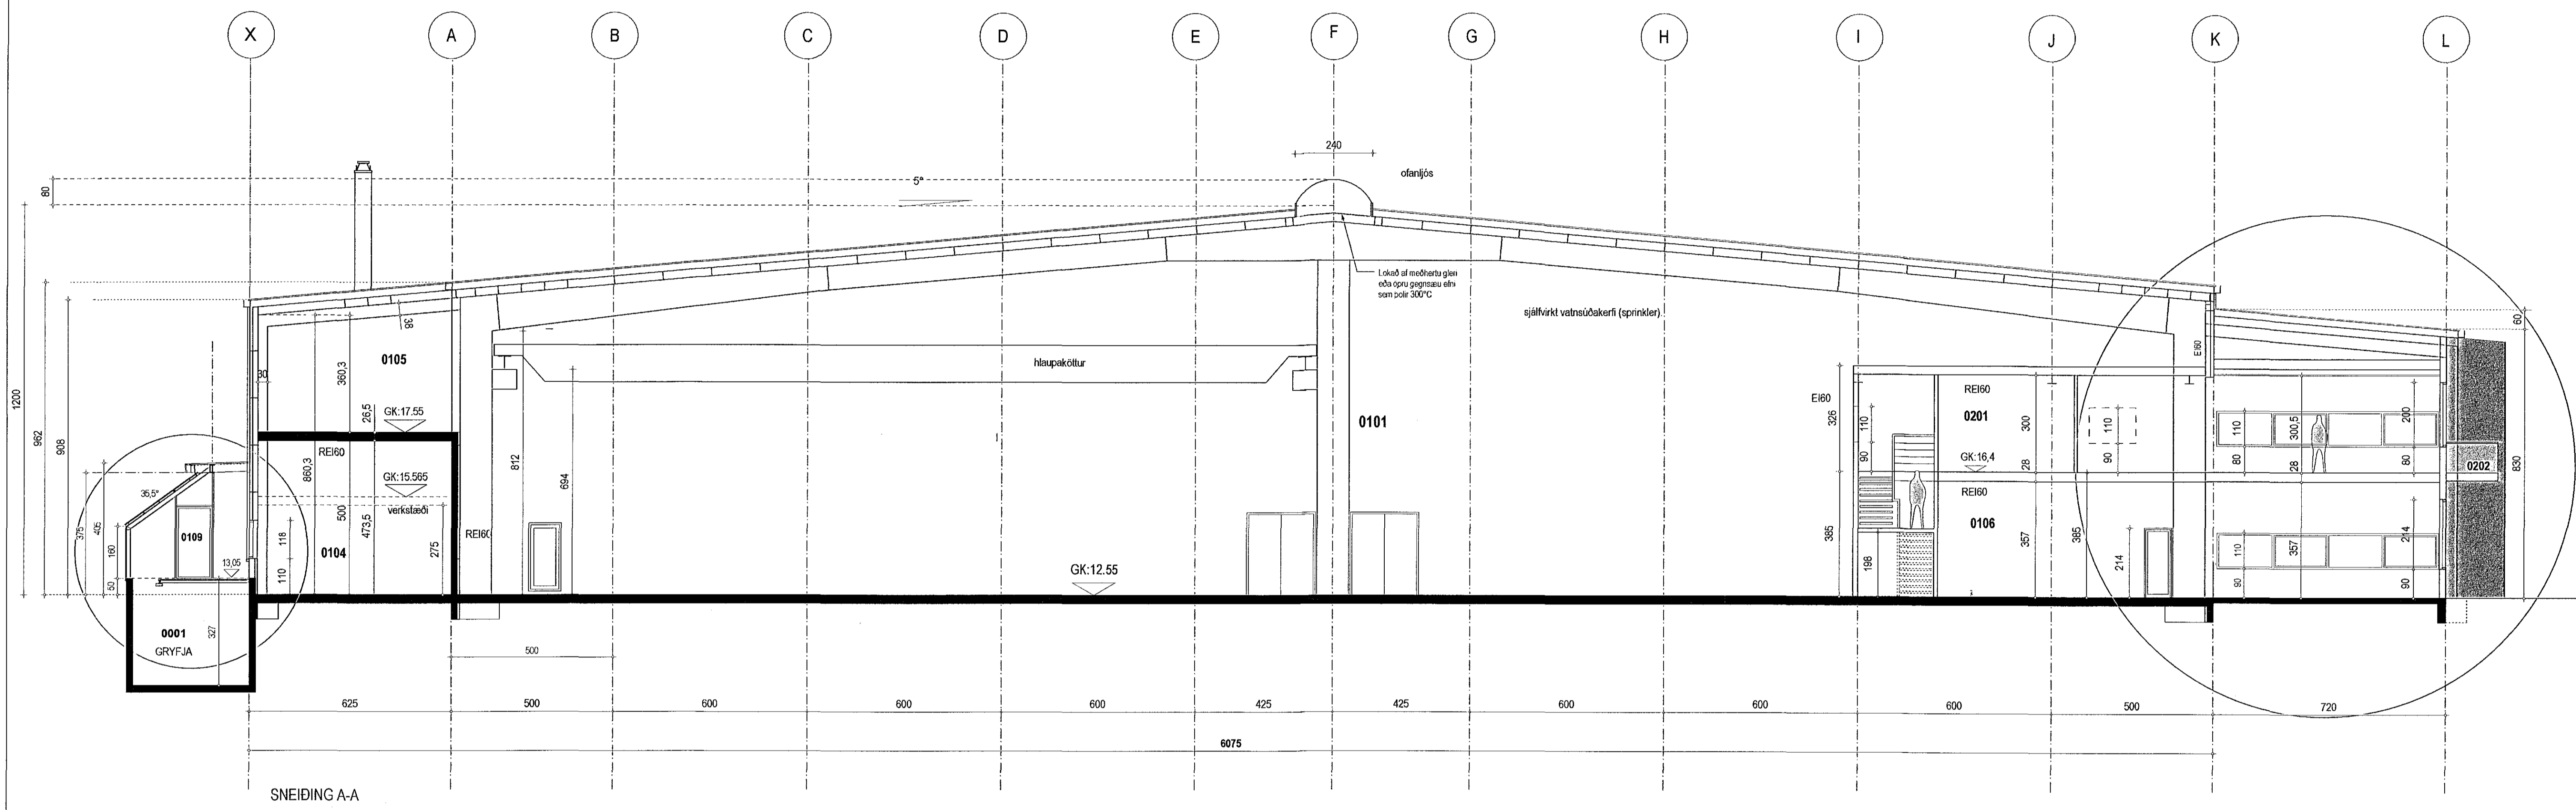

SNEIDING A-A

TEMPRA		ISHELLA 8, 220 HAFNARFIRÐI	
sneiðing A-A		no	1.9
		skali	1:100
dags.	25. maí 2017	breytt:	11.02.2018 skilyrði gryfu
teiknistofa	GINGI	Mólin 1, 450 Táknaþundur	gingi11@simnet.is
arkitektar tali	Gunnlaugur Þorgeirsson	hl. 110254-3349	sími: 6978864

Gunnlaugur Þorgeirsson