



Snjóbræðslurör cc250

Snjóbræðslurör cc250

Snjóbræðslurör cc250

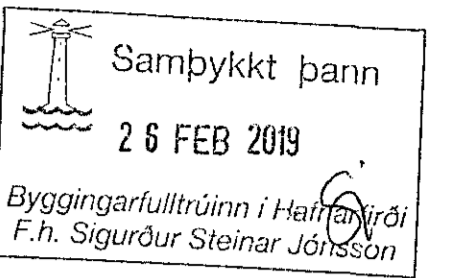

Skýringar:
 1. Sjá skýringar á teikningu L-07.

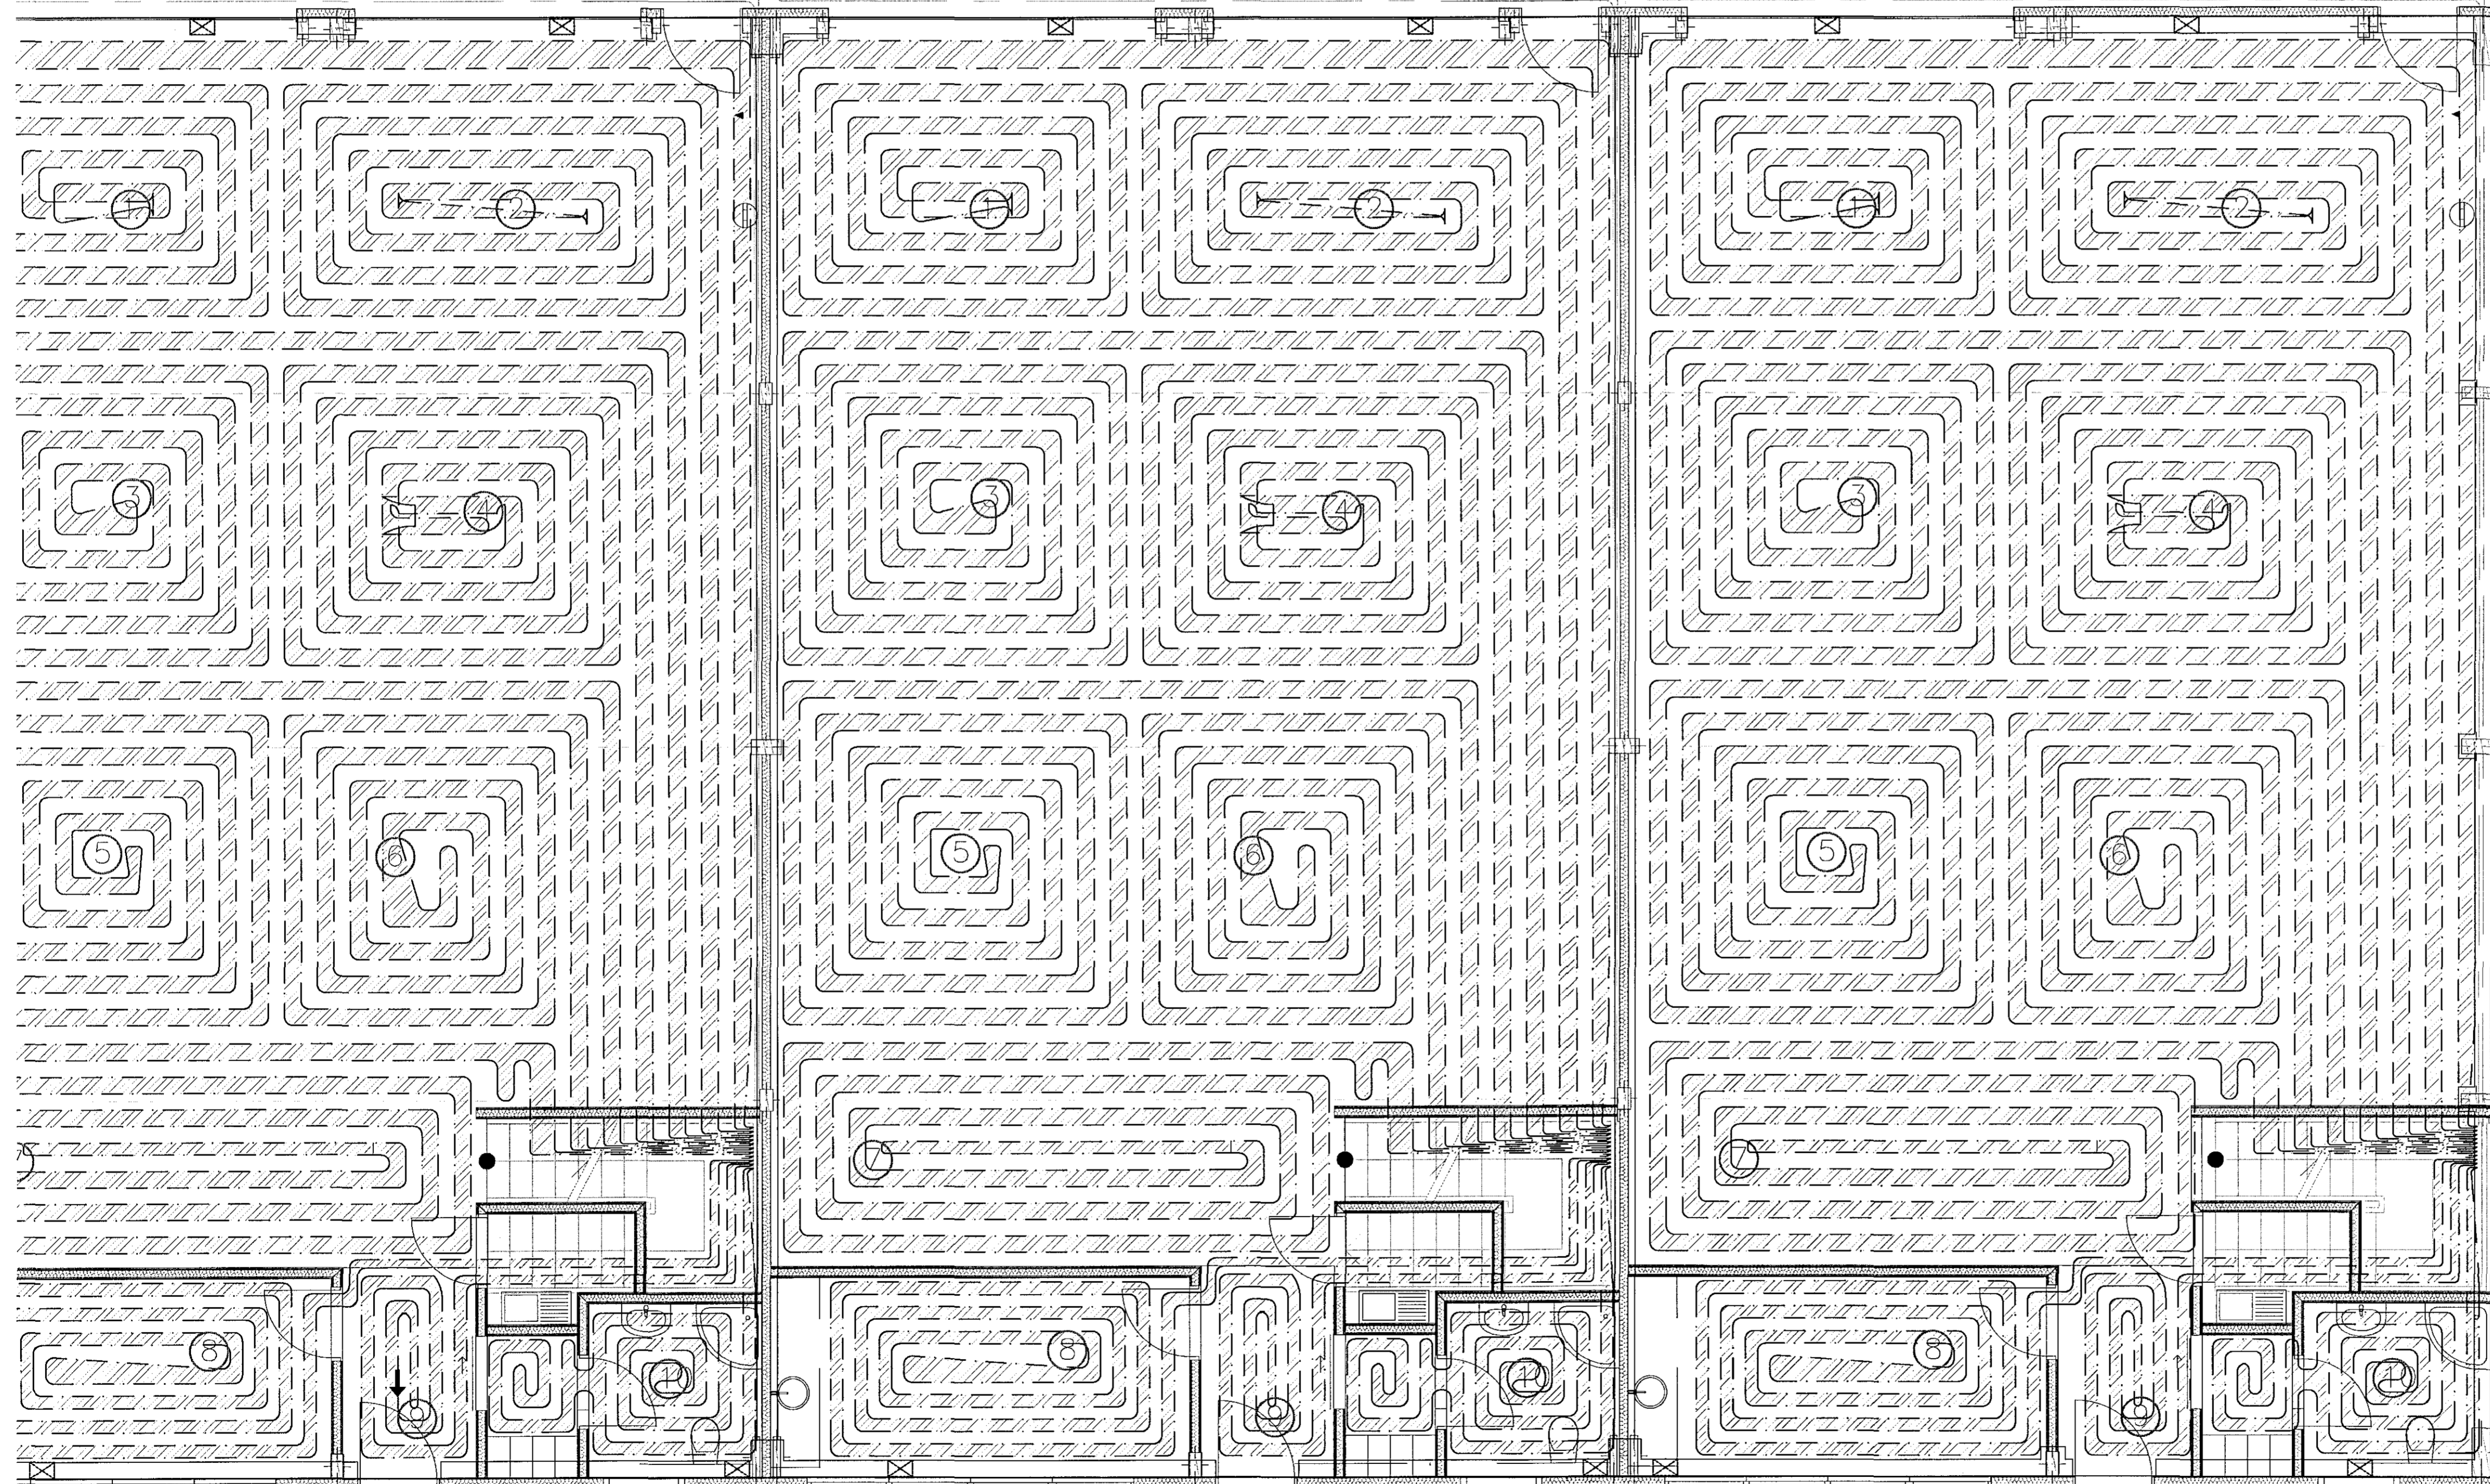

NR. DAGS. SKÝRING GERT
 I. 15.01.2019 Reyndarteikn KA
 SAMRÆMINGARHÖNDUR:

Birgir Leó Ólafsson
 SAMÞYKKT: 2002705179

Birgir Leó Ólafsson, Stangarлак 1
 E-mail: torfabaer@gmail.com, Sími: 8998180

VERK
Einhella 5
 Hafnarfjörður
 TEIKNING
 Lagnir
 Gólfhitri, grunnmynd, 3/3

KVARDI
 1:50
 DAGS TEIKNAD TEIKNING NR.
 15.04.2018 KA L-9
 VERKNR. REIKNAD ÚTGÁFA
 1

