
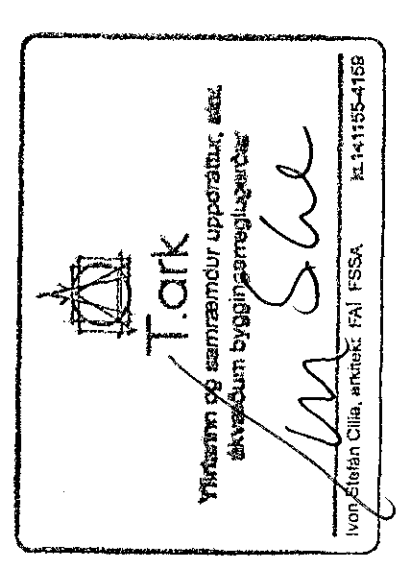
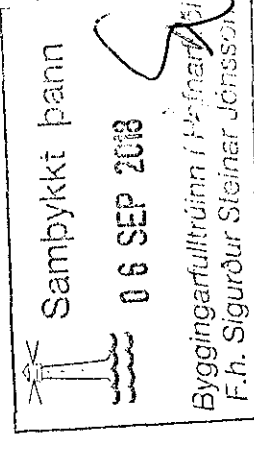


10

2

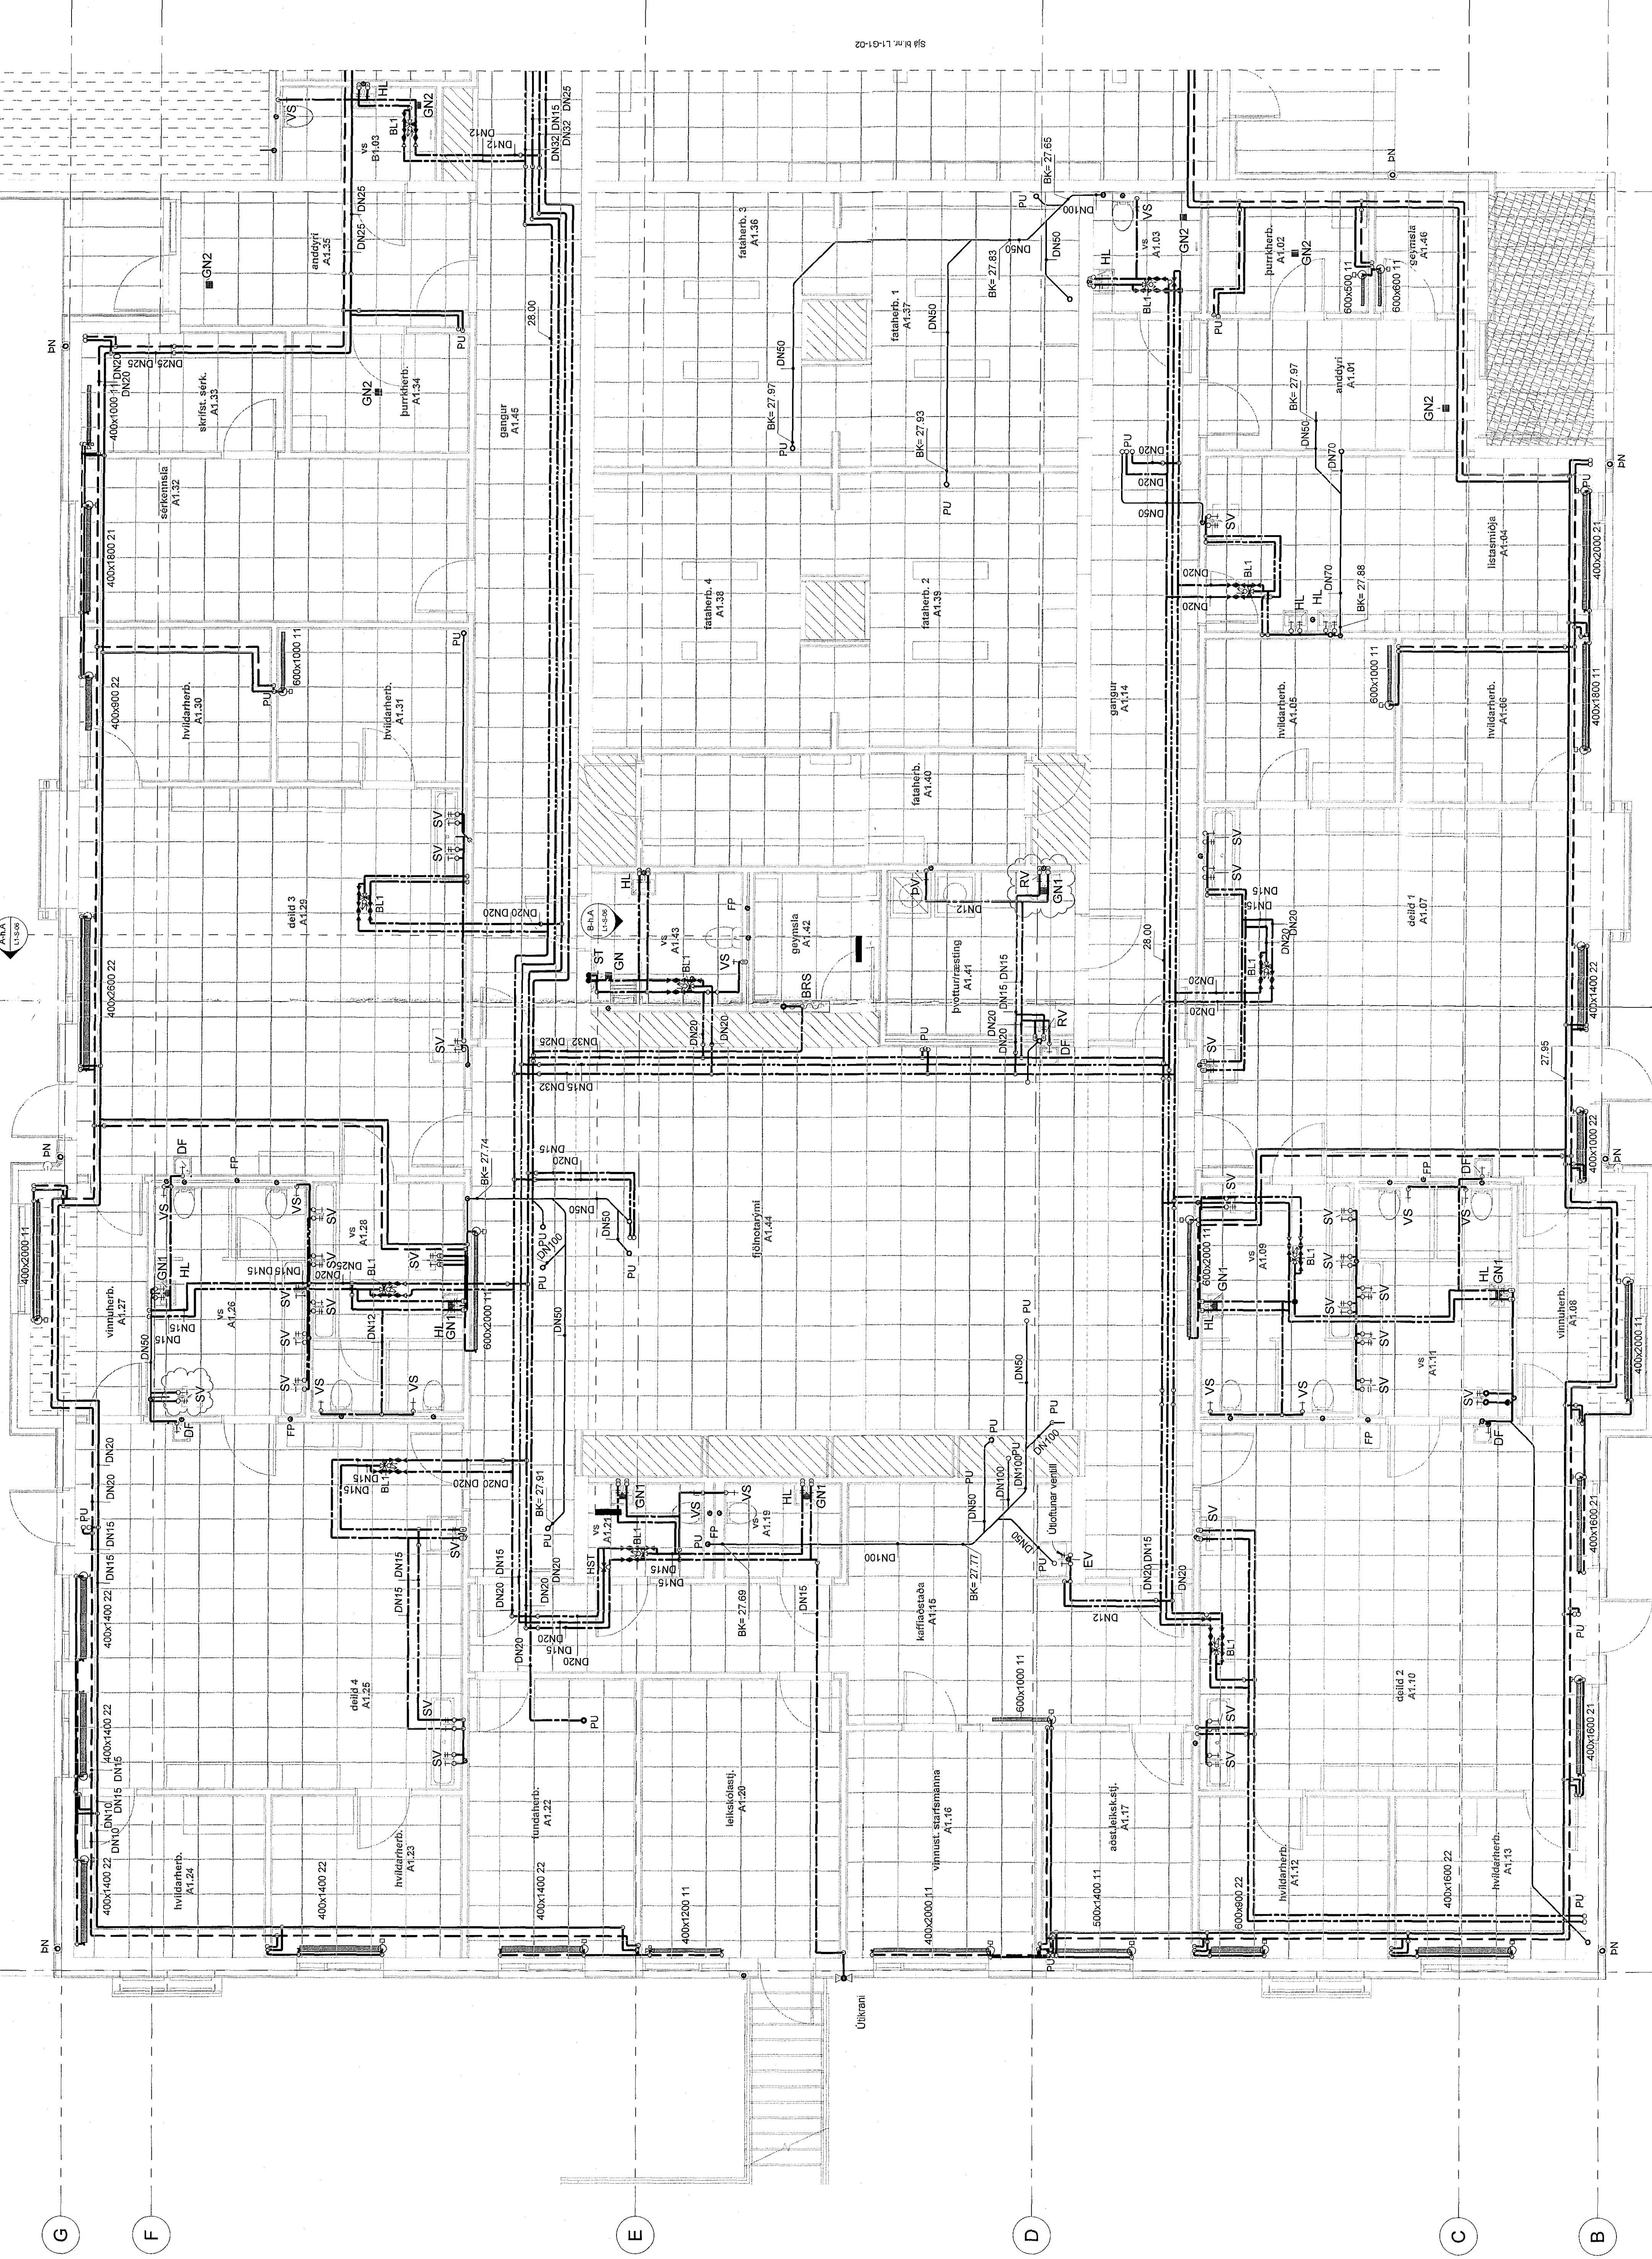



