



PRENTAD: þriðjudagur, 27. ágúst 2019 15:39:12

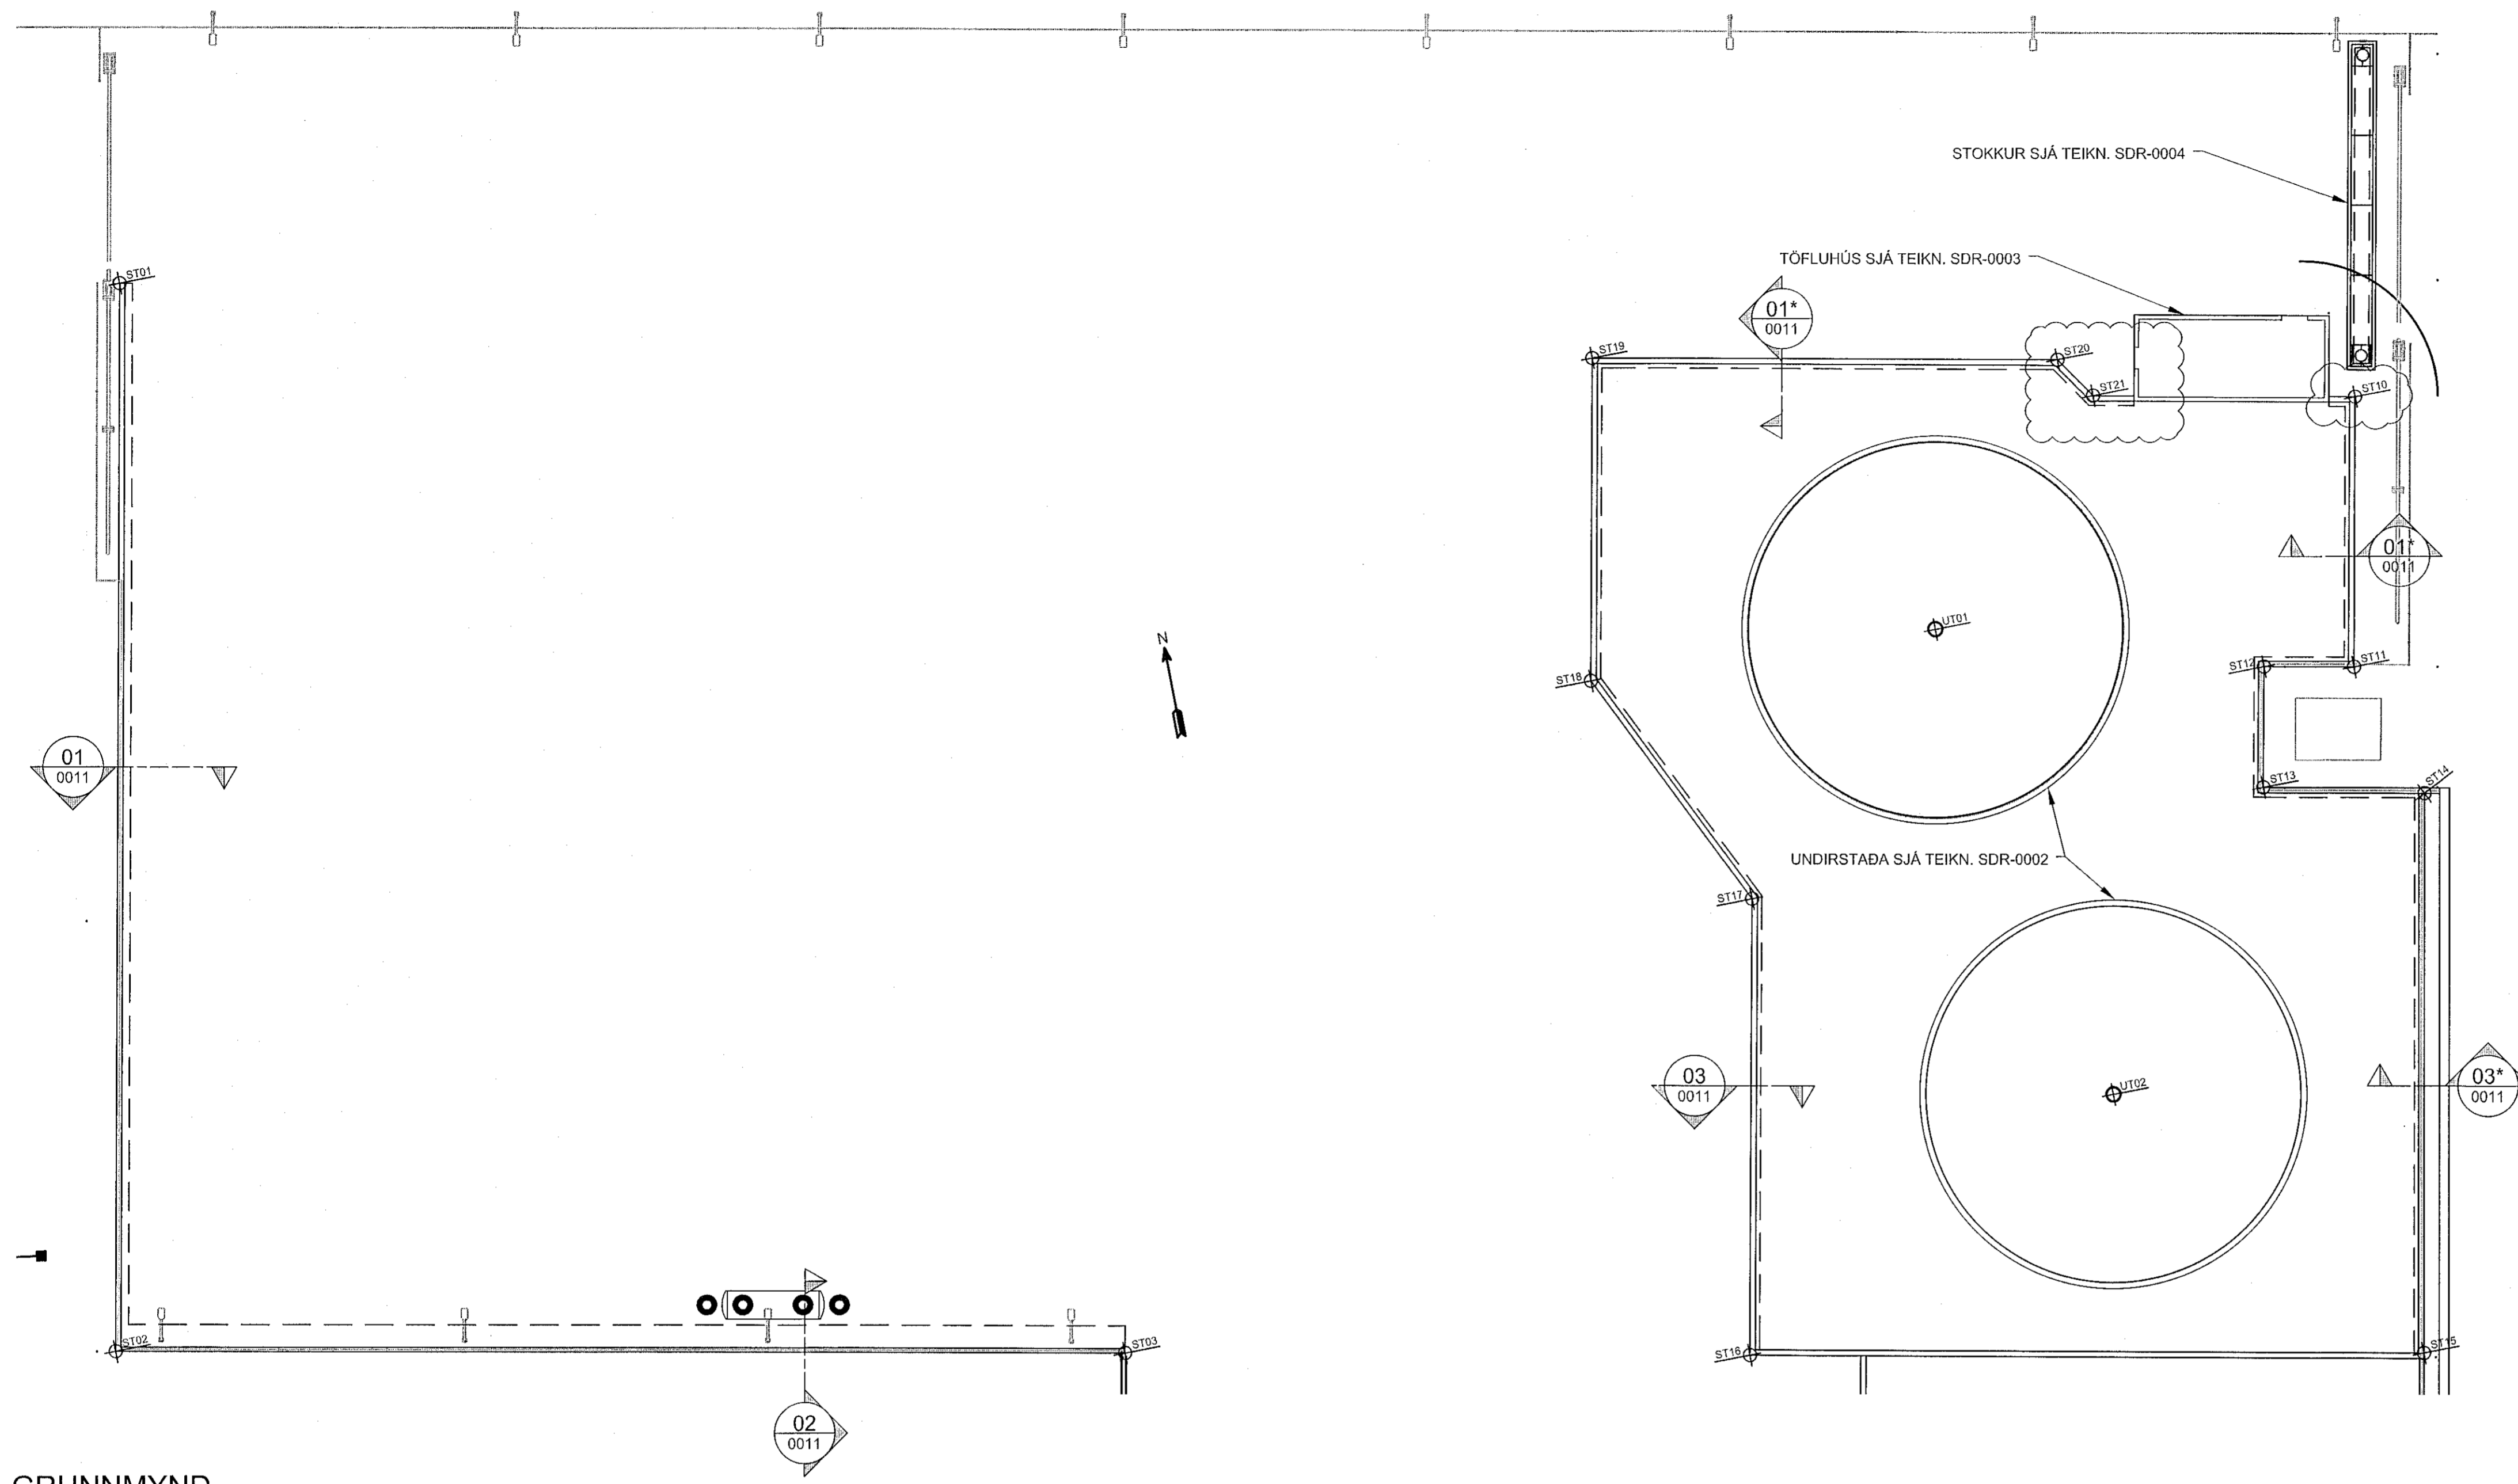


GRUNNMYND
1:100

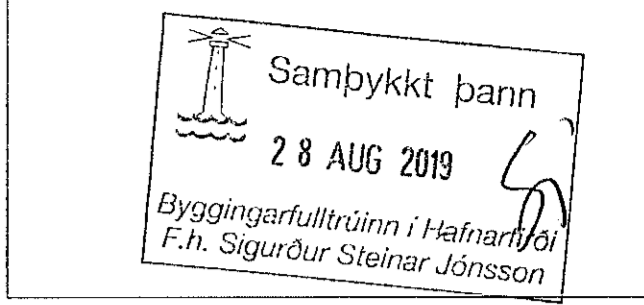

SKÝRINGAR:
ALMENNAR SKÝRINGAR SJÁ TEIKNINGU SDR-0X01

HNITASKRÁ:

	X	Y
ST01	354792,140	399170,793
ST02	354782,567	399122,537
ST03	354828,257	399113,473
ST10	354892,434	399146,025
ST11	354885,977	399133,632
ST12	354885,906	399134,439
ST13	354884,828	399129,005
ST14	354892,077	399127,313
ST15	354887,182	399102,046
ST16	354856,594	399107,857
ST17	354860,675	399128,436
ST18	354855,263	399139,703
ST19	354859,466	399159,339
ST20	354879,238	399150,159
ST21	354880,410	399148,409
UT01	354871,339	399138,997
UT02	354875,360	399116,456

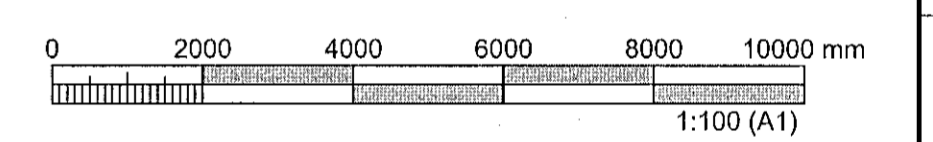

ÚTGÁFUFRILL					
ÚTG.	DAGS.	SKÝRINGAR	HANNAÐ	YFIRF.	SAMB.
01	11.07.2019	BYGGINGARTEIKNING	SMV	AMS	SMV
02	27.08.2019	STODVEGG BREYTT UPPFÆRD HNITASKRÁ	SMV	AMS	SMV

DAGS. UNDIRSKRIFTAR
27.08.2019
ADALHÖNNUR F.H. MANNVIT (NAFN OG KT.)
MANNVIT hf.
Kt. 230488-2589

DAGS. UNDIRSKRIFTAR
27.08.2019
SAMRÁÐGAFINGARSTJÓRNUNGLIÐ (NAFN OG KT.)
Andri M. Á. Sigurðsson
Kt. 170583-4429

BYGGT Á ADALUPPDRATTUM - DAGS.: 01.07.2019 - ÚTGÁFA: 02



HÖNNUÐUR
MANNVIT
Urðarhvarfi 6 203 Kópavogi Sími: 422 3000 Fsk: 422 3001
www.mannvil.is mannvit@mannvil.is Kt: 430572-0169

HEITI VERKS
HLAÐBÆR - COLAS
ÓSEYRARBRAUT 16
220 - HAFNARFJÖRÐUR

HEITI TEIKNINGAR			
FRUMÚTGÁFA	MKV.	VERGHLUTI	TEIKNINGAÚMÉR
11.07.2019	1:100	000	SDR-0001
VERKNÚMÉR	VERGHLUTI	TEIKNINGAÚMÉR	ÚTGÁFA
2110157	000	SDR-0001	02

TOLUSKRÁ: S:\C\NRY\10157-Hlaðbær Colas\10 - Mannvit\01 - Ramm\Búnaðarkl.þag