



Samþykkt þann
15 OCT 2019
Byggingarfulltrúinn í Hafnarfirði
F.H. Sigurður Steinar Jónsson

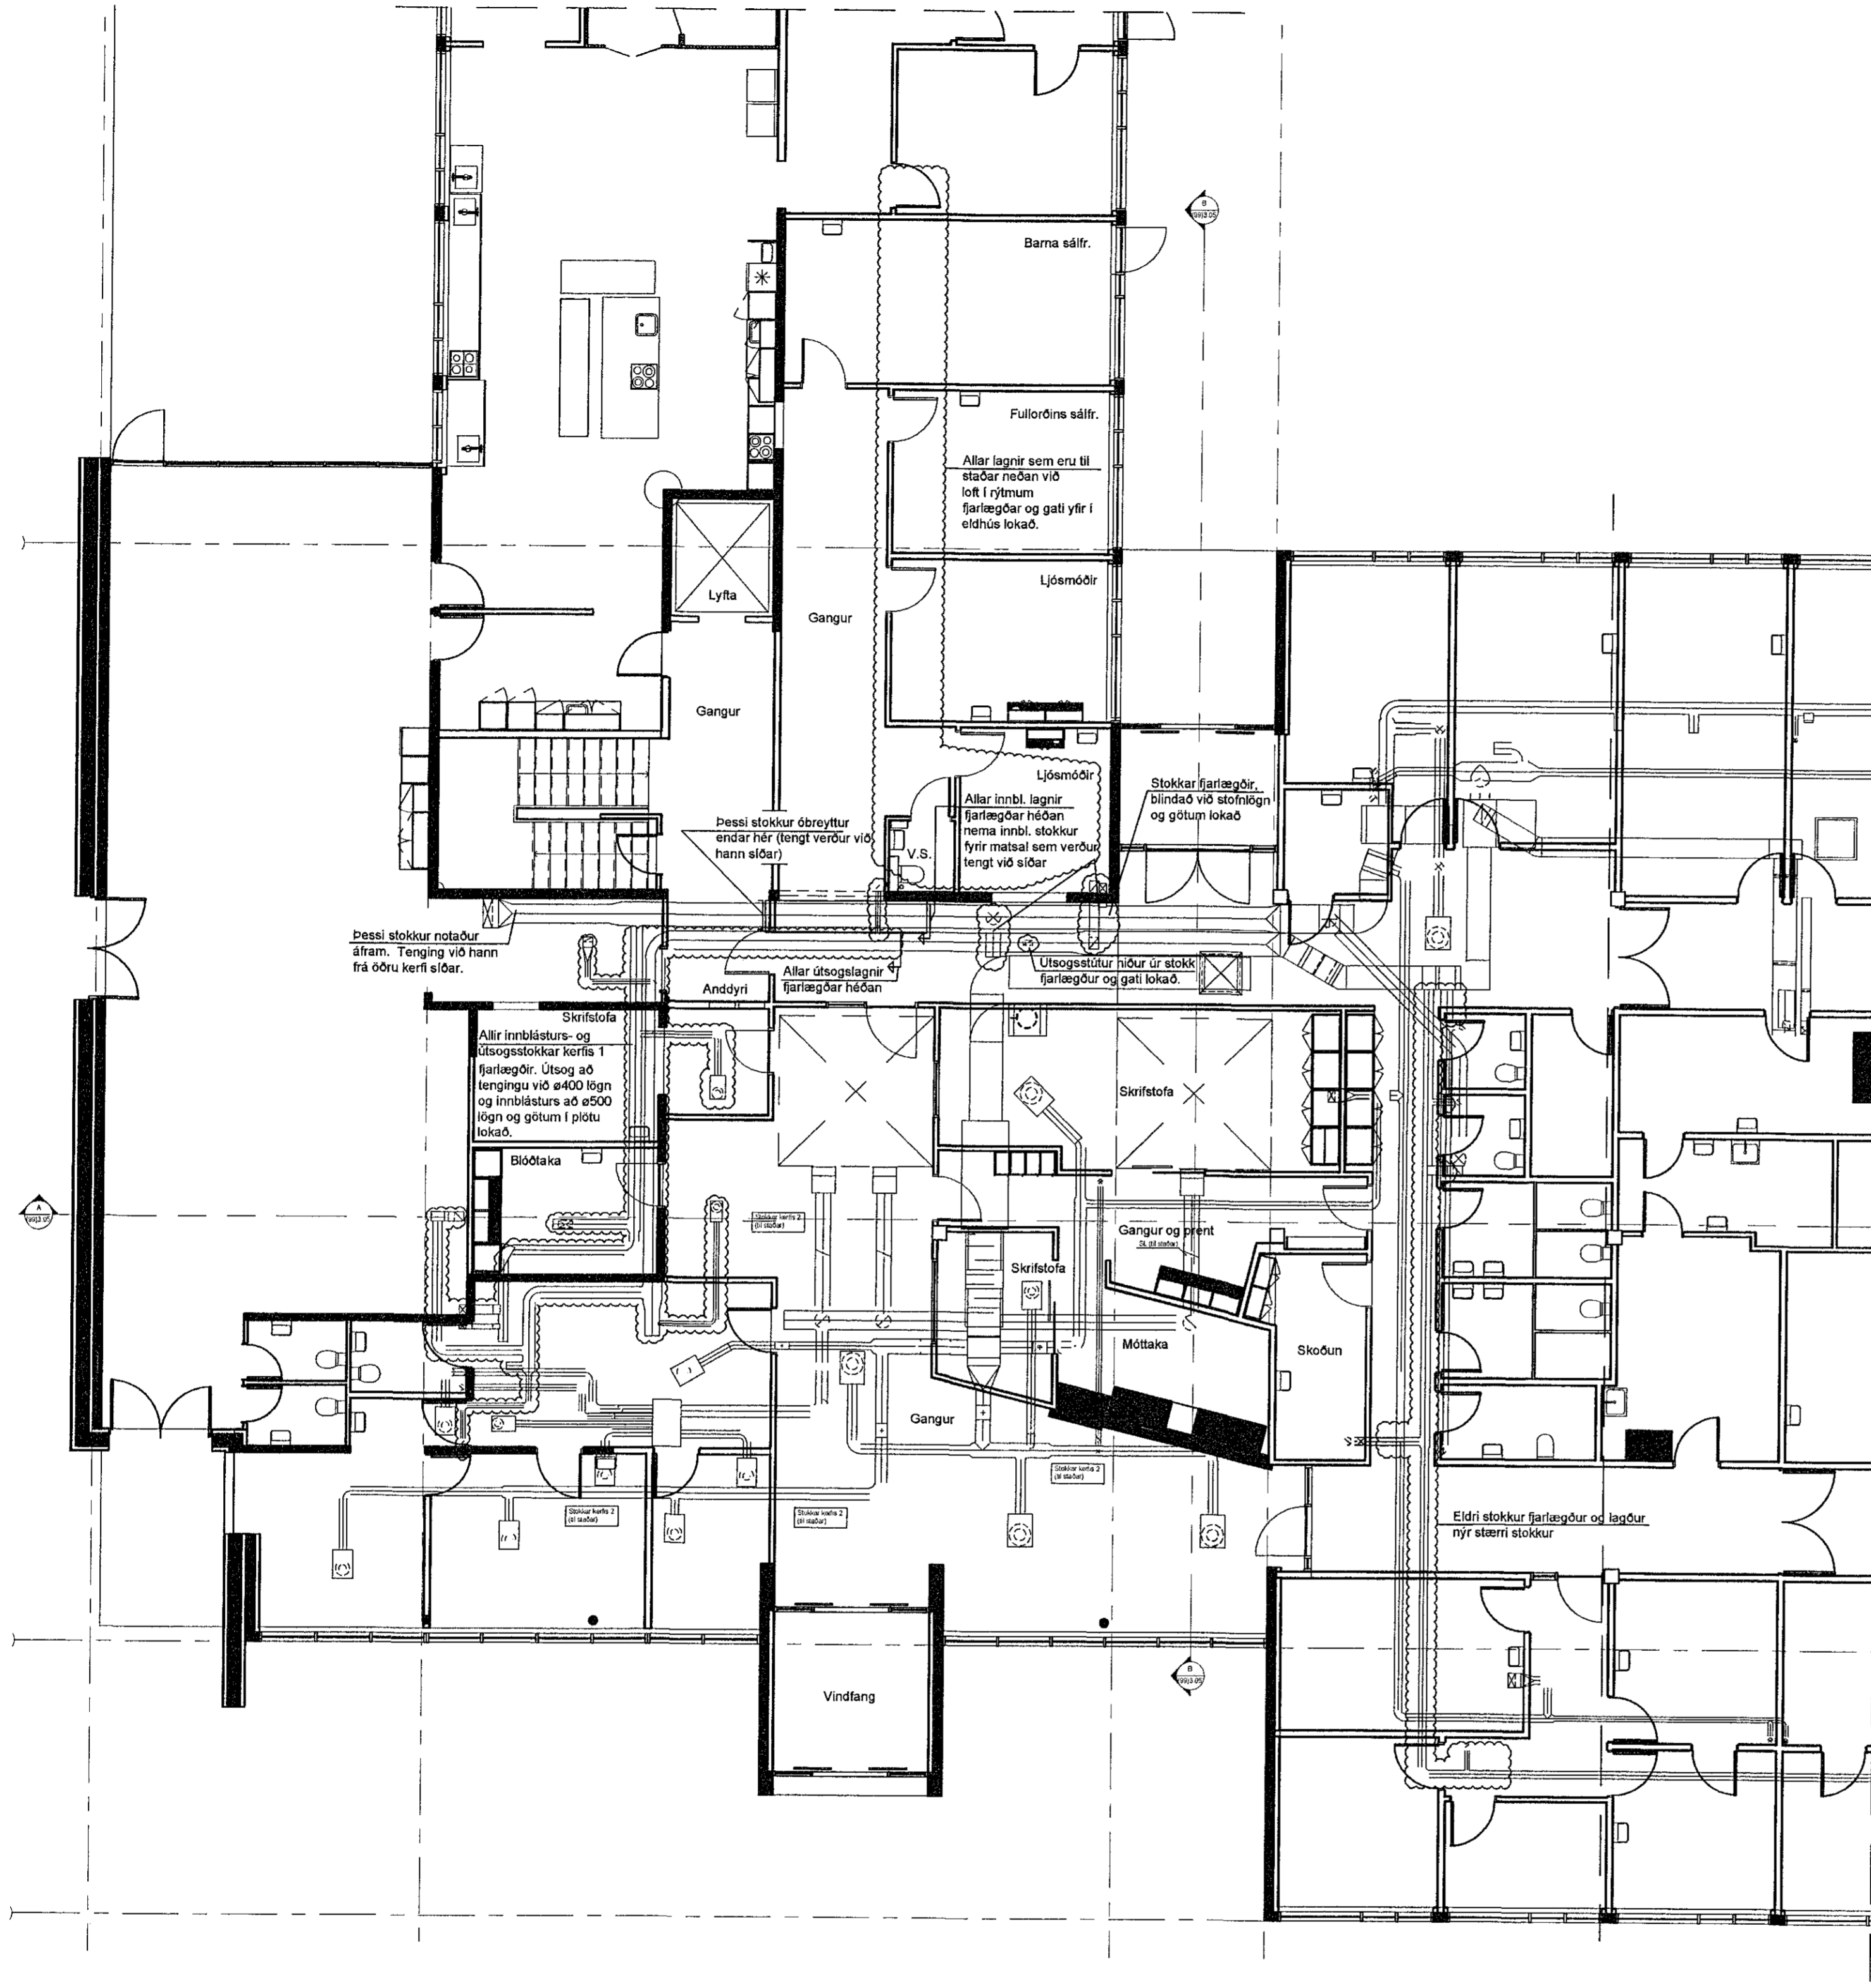

AFSTÖÐUMYND - MÆLIKVARÐI 1:500

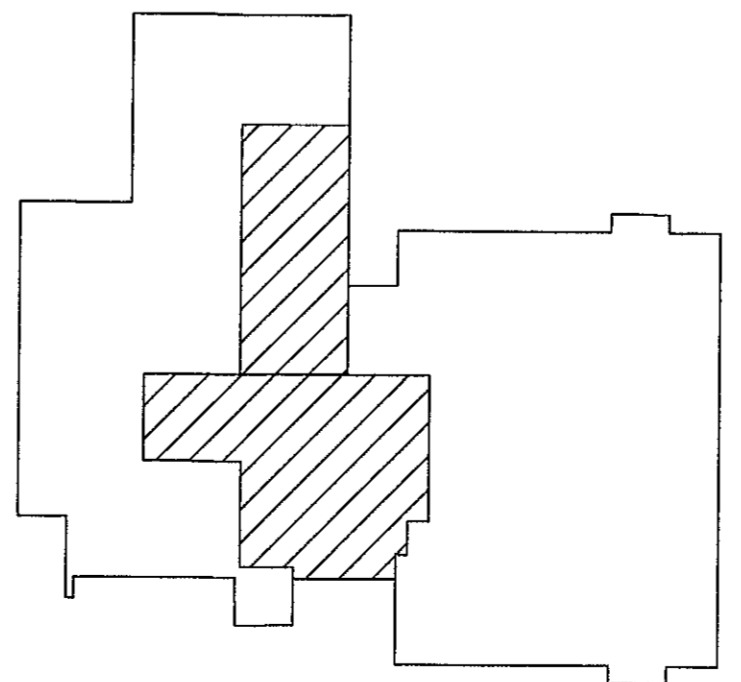

ÁRITUN AÐALHÖNNUÐAR: Egill Guðmundsson Kt. 270152-6869		TIF - TÆKNIÞJÓNUSTA JÓN K. GUNNARSSON K.T. 111149-2919 FJARÐARGÖTU 11 220 - HAFNARFIRÐI SÍMI 567 7899 NETFANG TIF@SIMNET.IS	
SÓLVANGSVEGUR 2, 220 - HAFNARFIRÐI HEILSUGÆSLAN SÓLVANGUR LOFTRÆSIKERFI - ELÐRI LOFTRÆSILAGNIR Á 1. HÆÐ GRUNNMYND 1.HÆÐ - BREYTINGAR Á ELÐRI LÖGNUM		HANNAD: Jón K. Gunnarsson TEIKNAD: Jón K. Gunnarsson	
SAMPYKKT Dag: 15. Október 2019		KVARDI: 1:100 DAGS-NÚMÉR: 229-305	

Nr.	Dags.	Breyting	Unnið af
D			
C			
B			
A			