



GRUNNMÝND 1:50

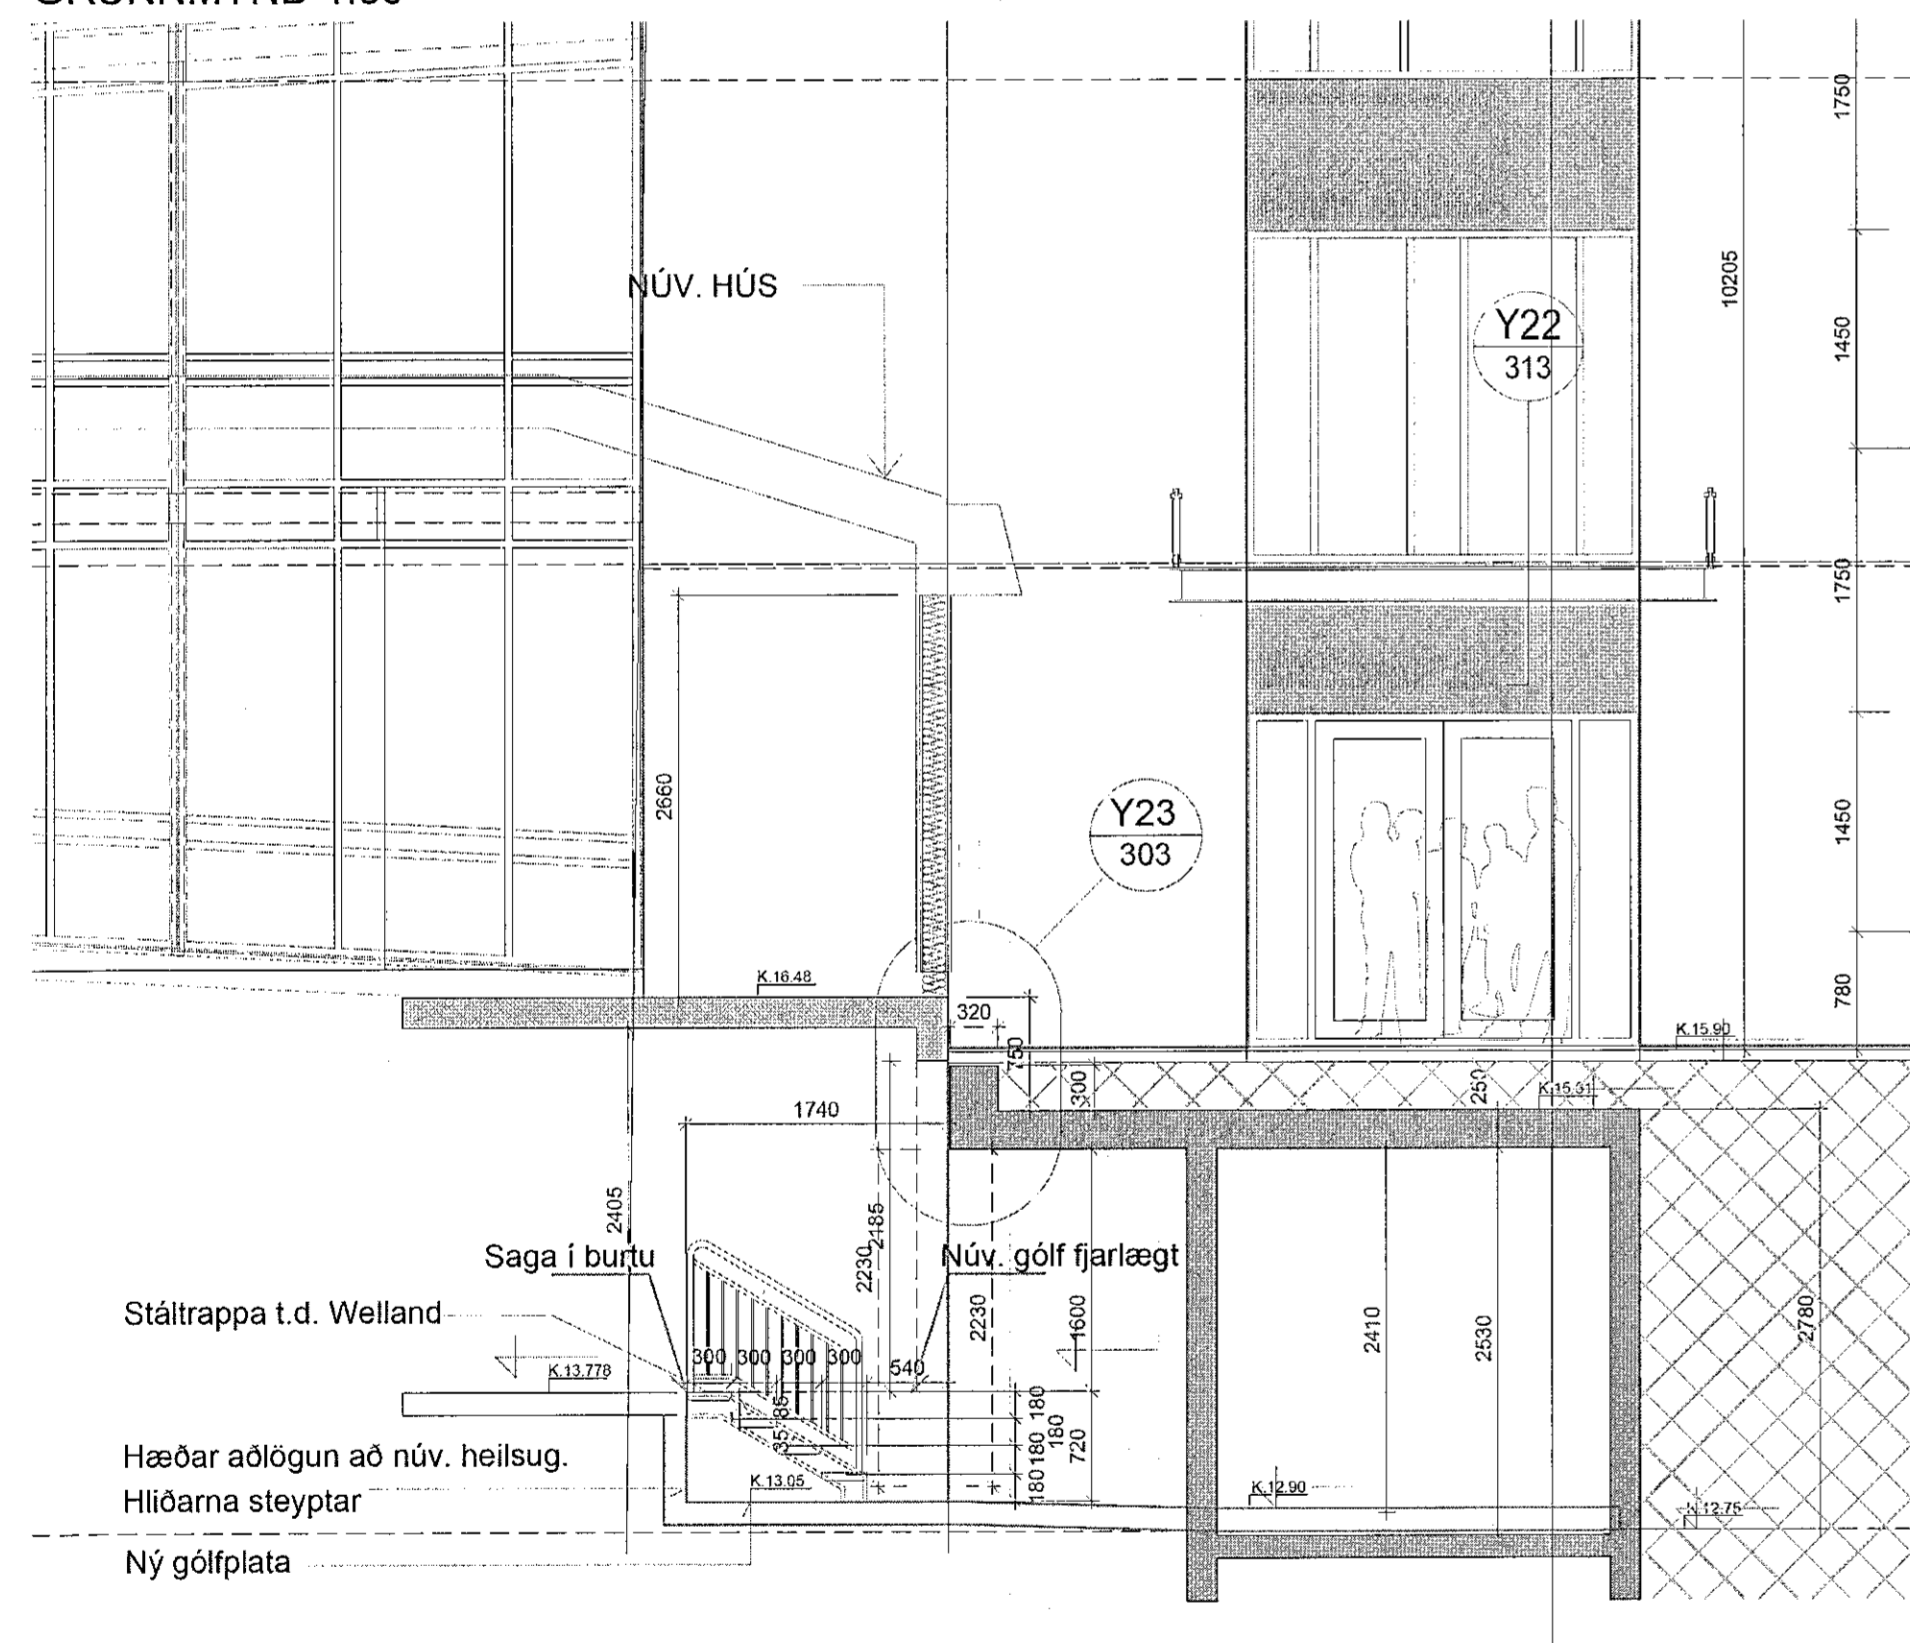

SNEIÐING 1:50

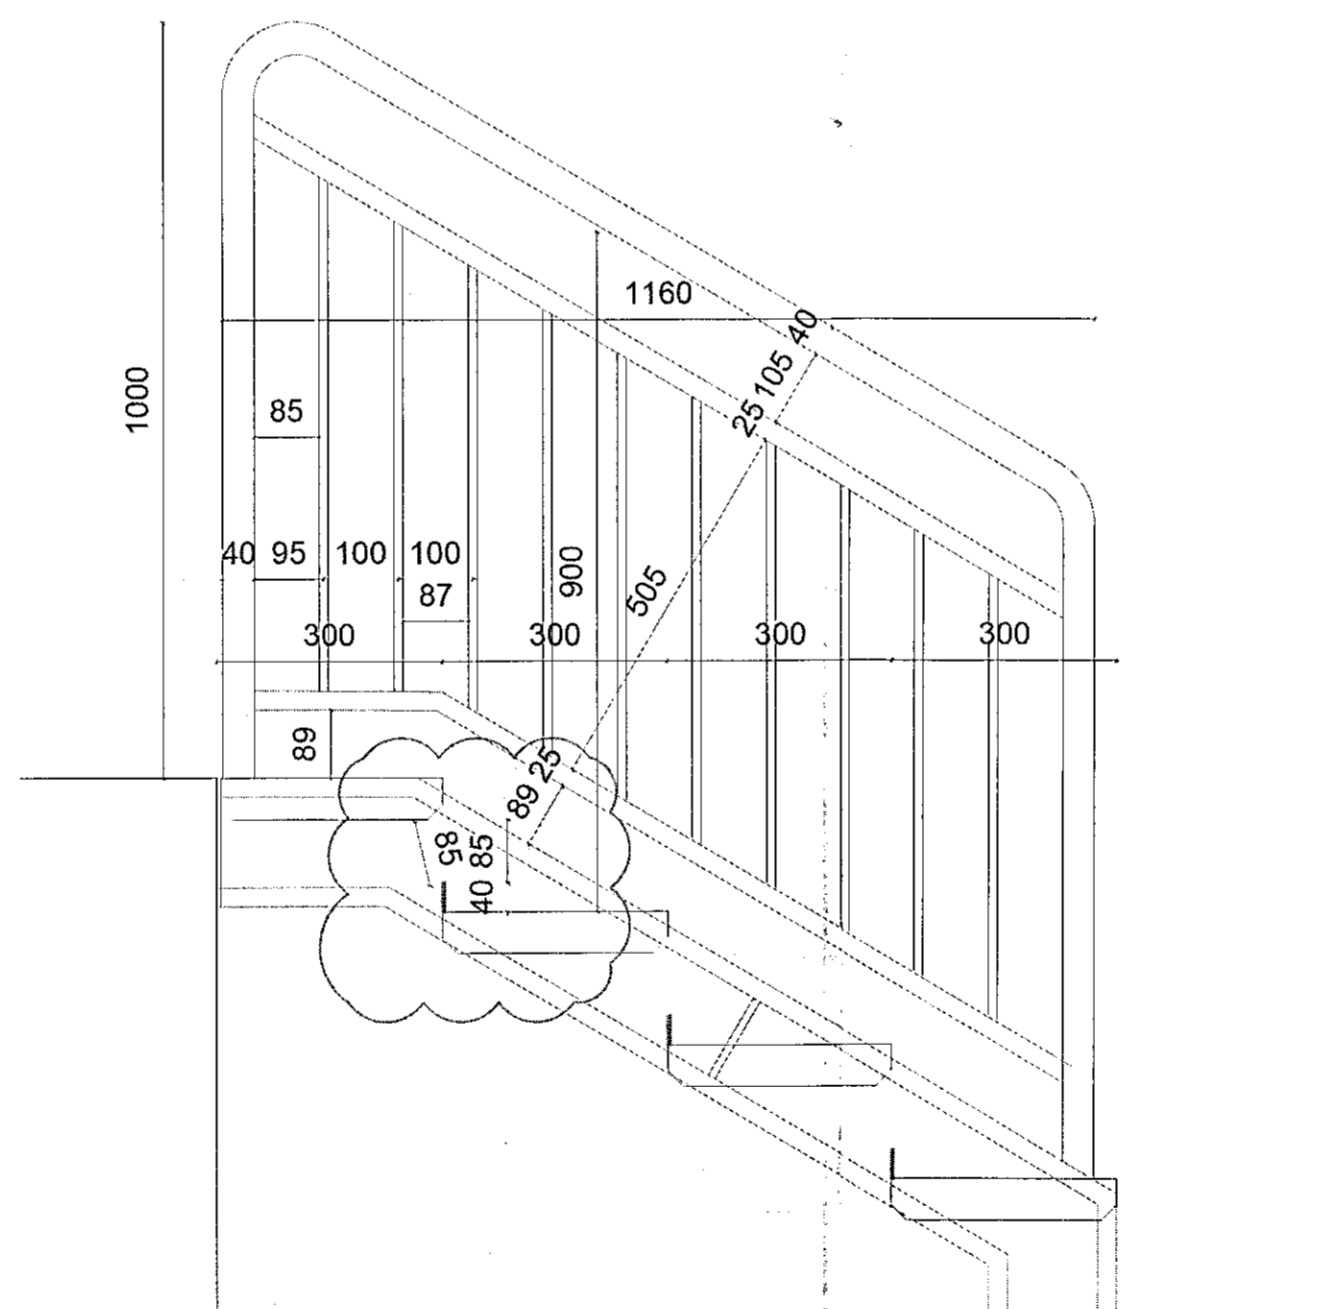


STIGI 1:10

Samþykkt þann
02 SEP 2019
Byggingarfulltrúinn í Hafnarfirði
F.h. Sigurður Steinar Jónsson

ÁRITUN HÖNNUNARSTJÓRA:

ÚTI INNI
ARKITEKTAR
BALDUR Ó. SVAVARSSON
ARKITEKTI FAI SAMMÁK
KT.: 120357-5149

D:
C:
B:
A: Málsetningar lagfærðar 24.04.2019
BREYTINGAR: DAGS:

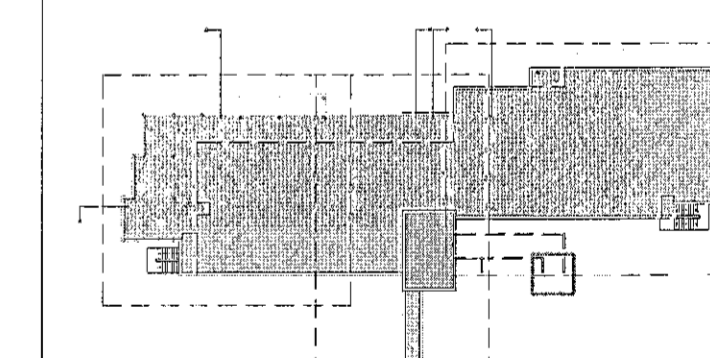

VERKTEIKNINGAR

SÖLVANGUR HJÚKRUNARHEIMILI 2016
SÖLVANGSVEGI 2 HAFNARFIRÐI
VERK: SOLV 1533
KVARDI: 1:50/1:10
DAGS: 29.03.2019
KJALLARI TEIKN: JBP
STIGI OG TENGING HEILSUG. SKRÁ: 1533-Grunnur.dwg

ÚTI INNI

ARKITEKTAR

HINGHOLTSSTRÆTI 27 101 REYKJAVÍK
SÍMAR: 5527060 & 5527060 FAX: 5527061
NETFANG: ut@in.is VEFFANG: www.uti.is

BALDUR Ó. SVAVARSSON ARKITEKTAR FAI
120357-5149
JÓN ÞÓR ÞORVALDSSON ARKITEKTAR FAI
021256-7579

A
A-251