

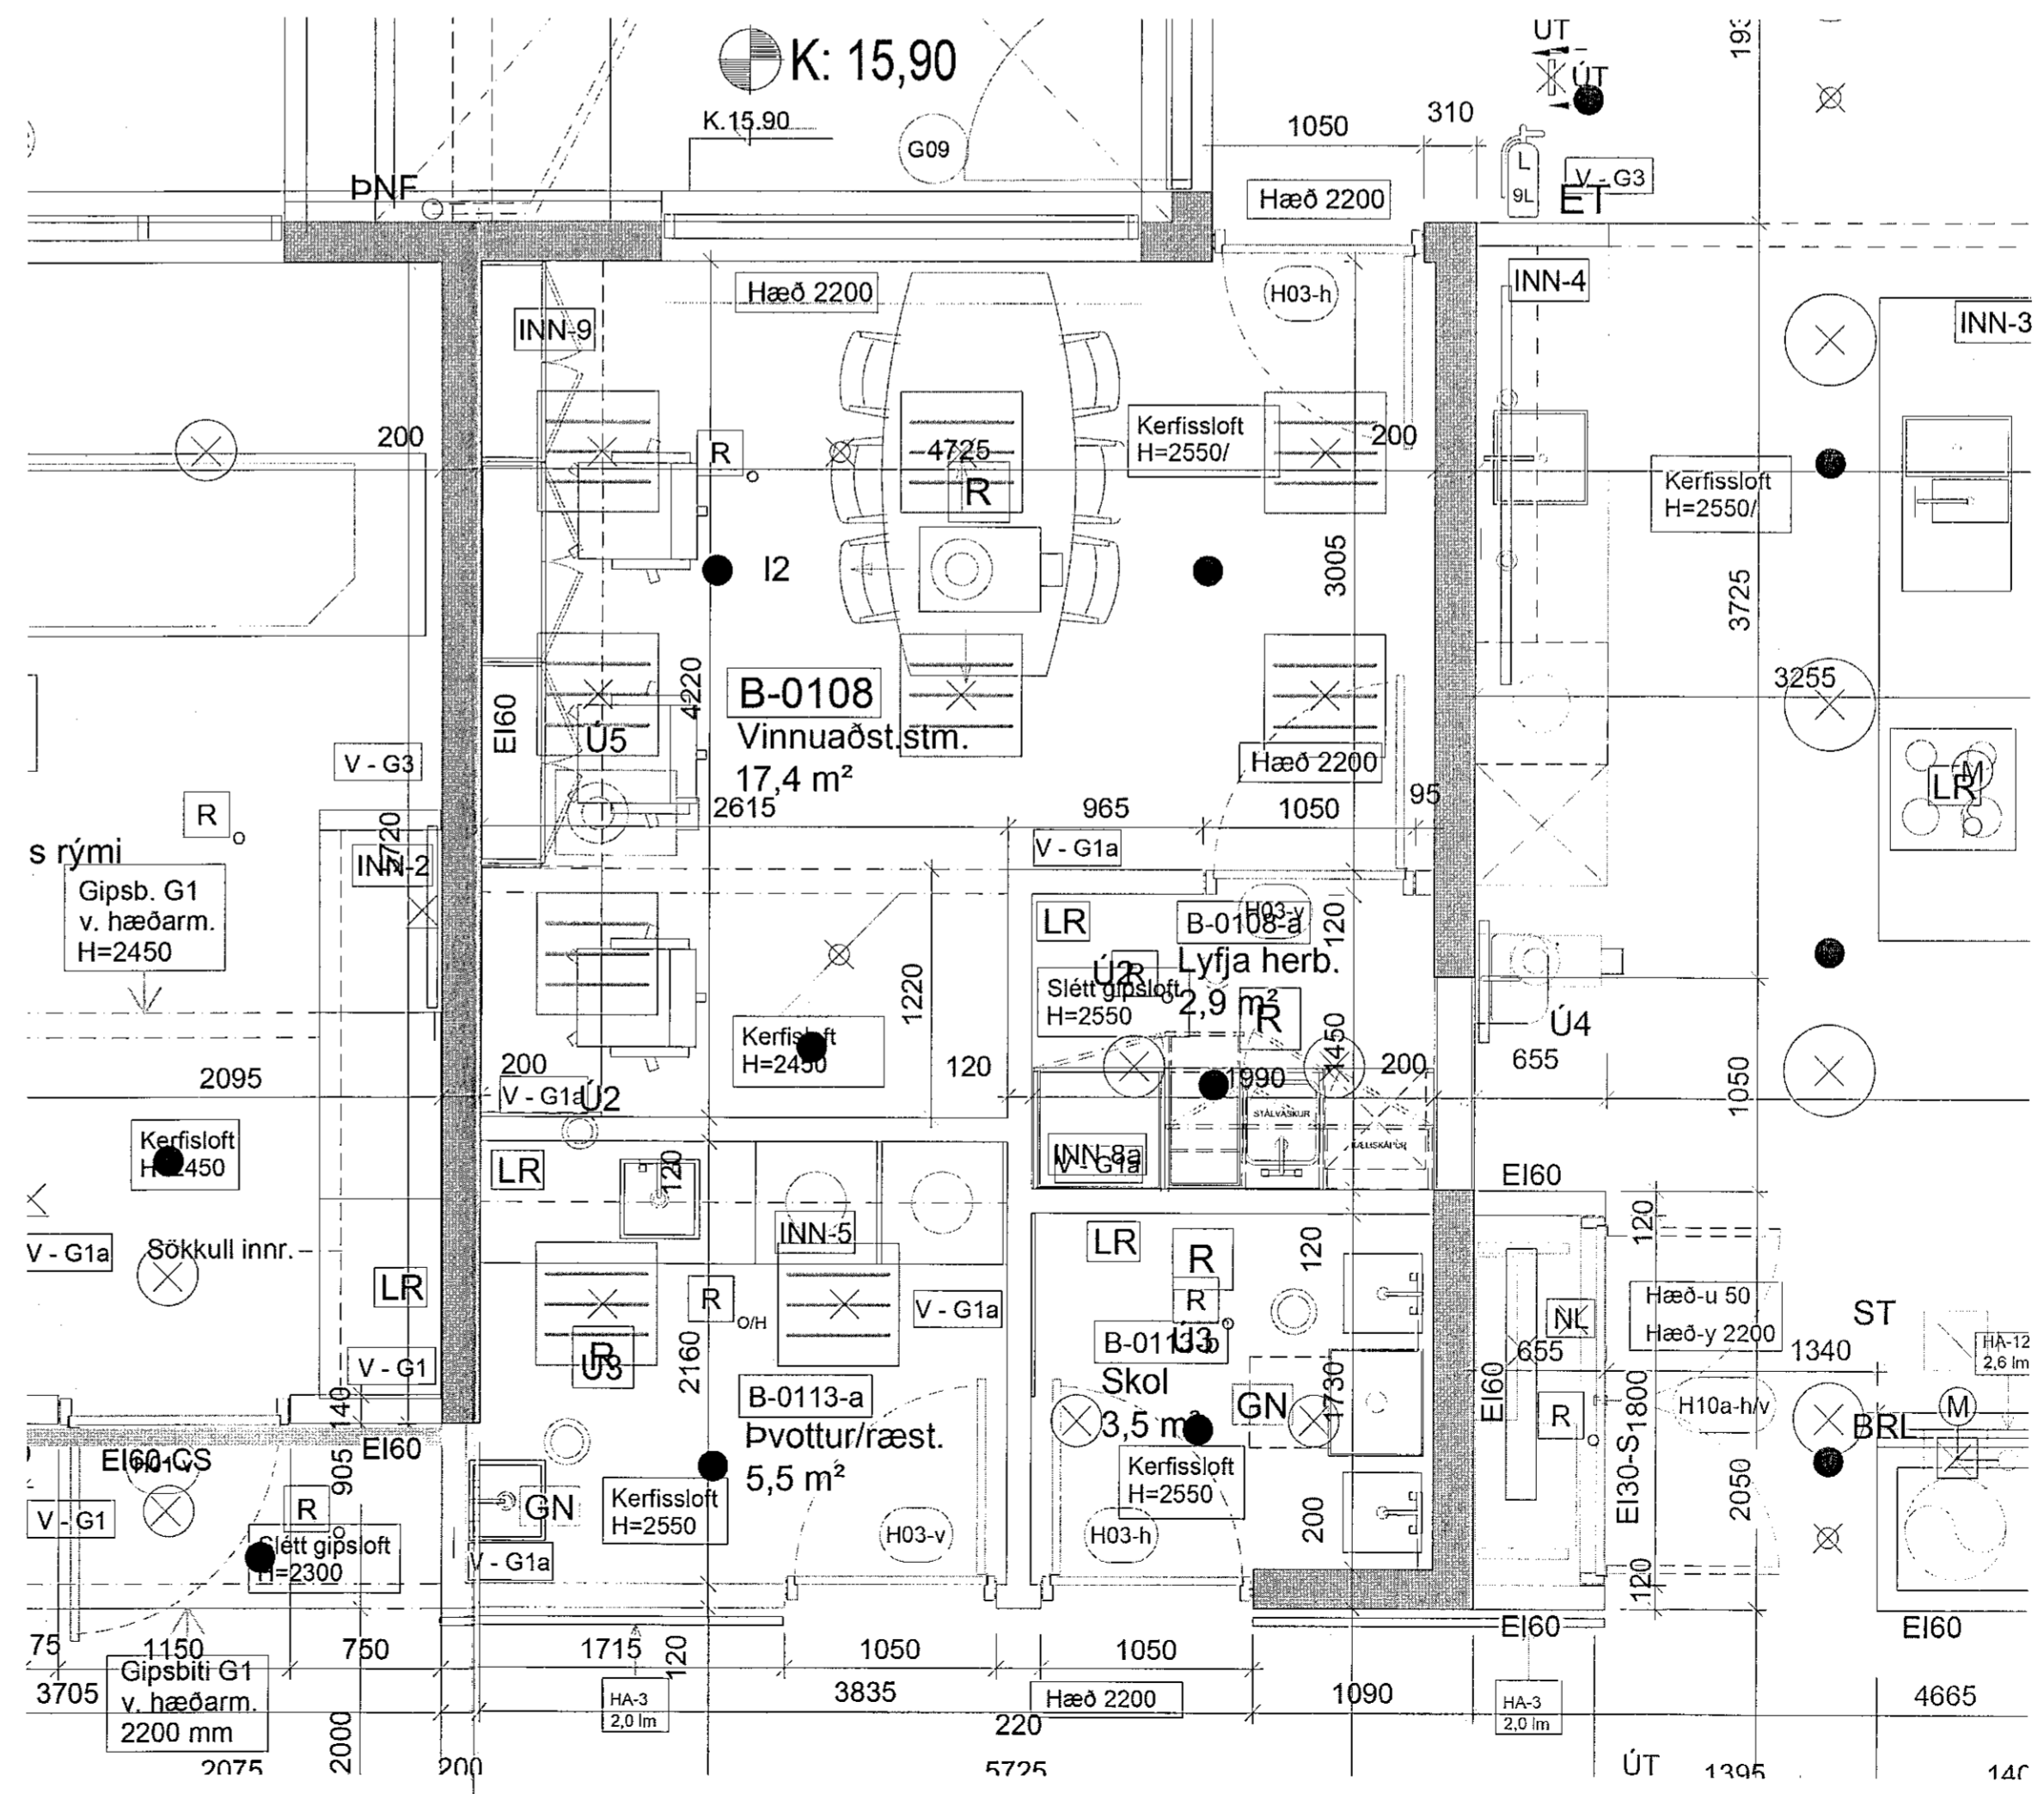
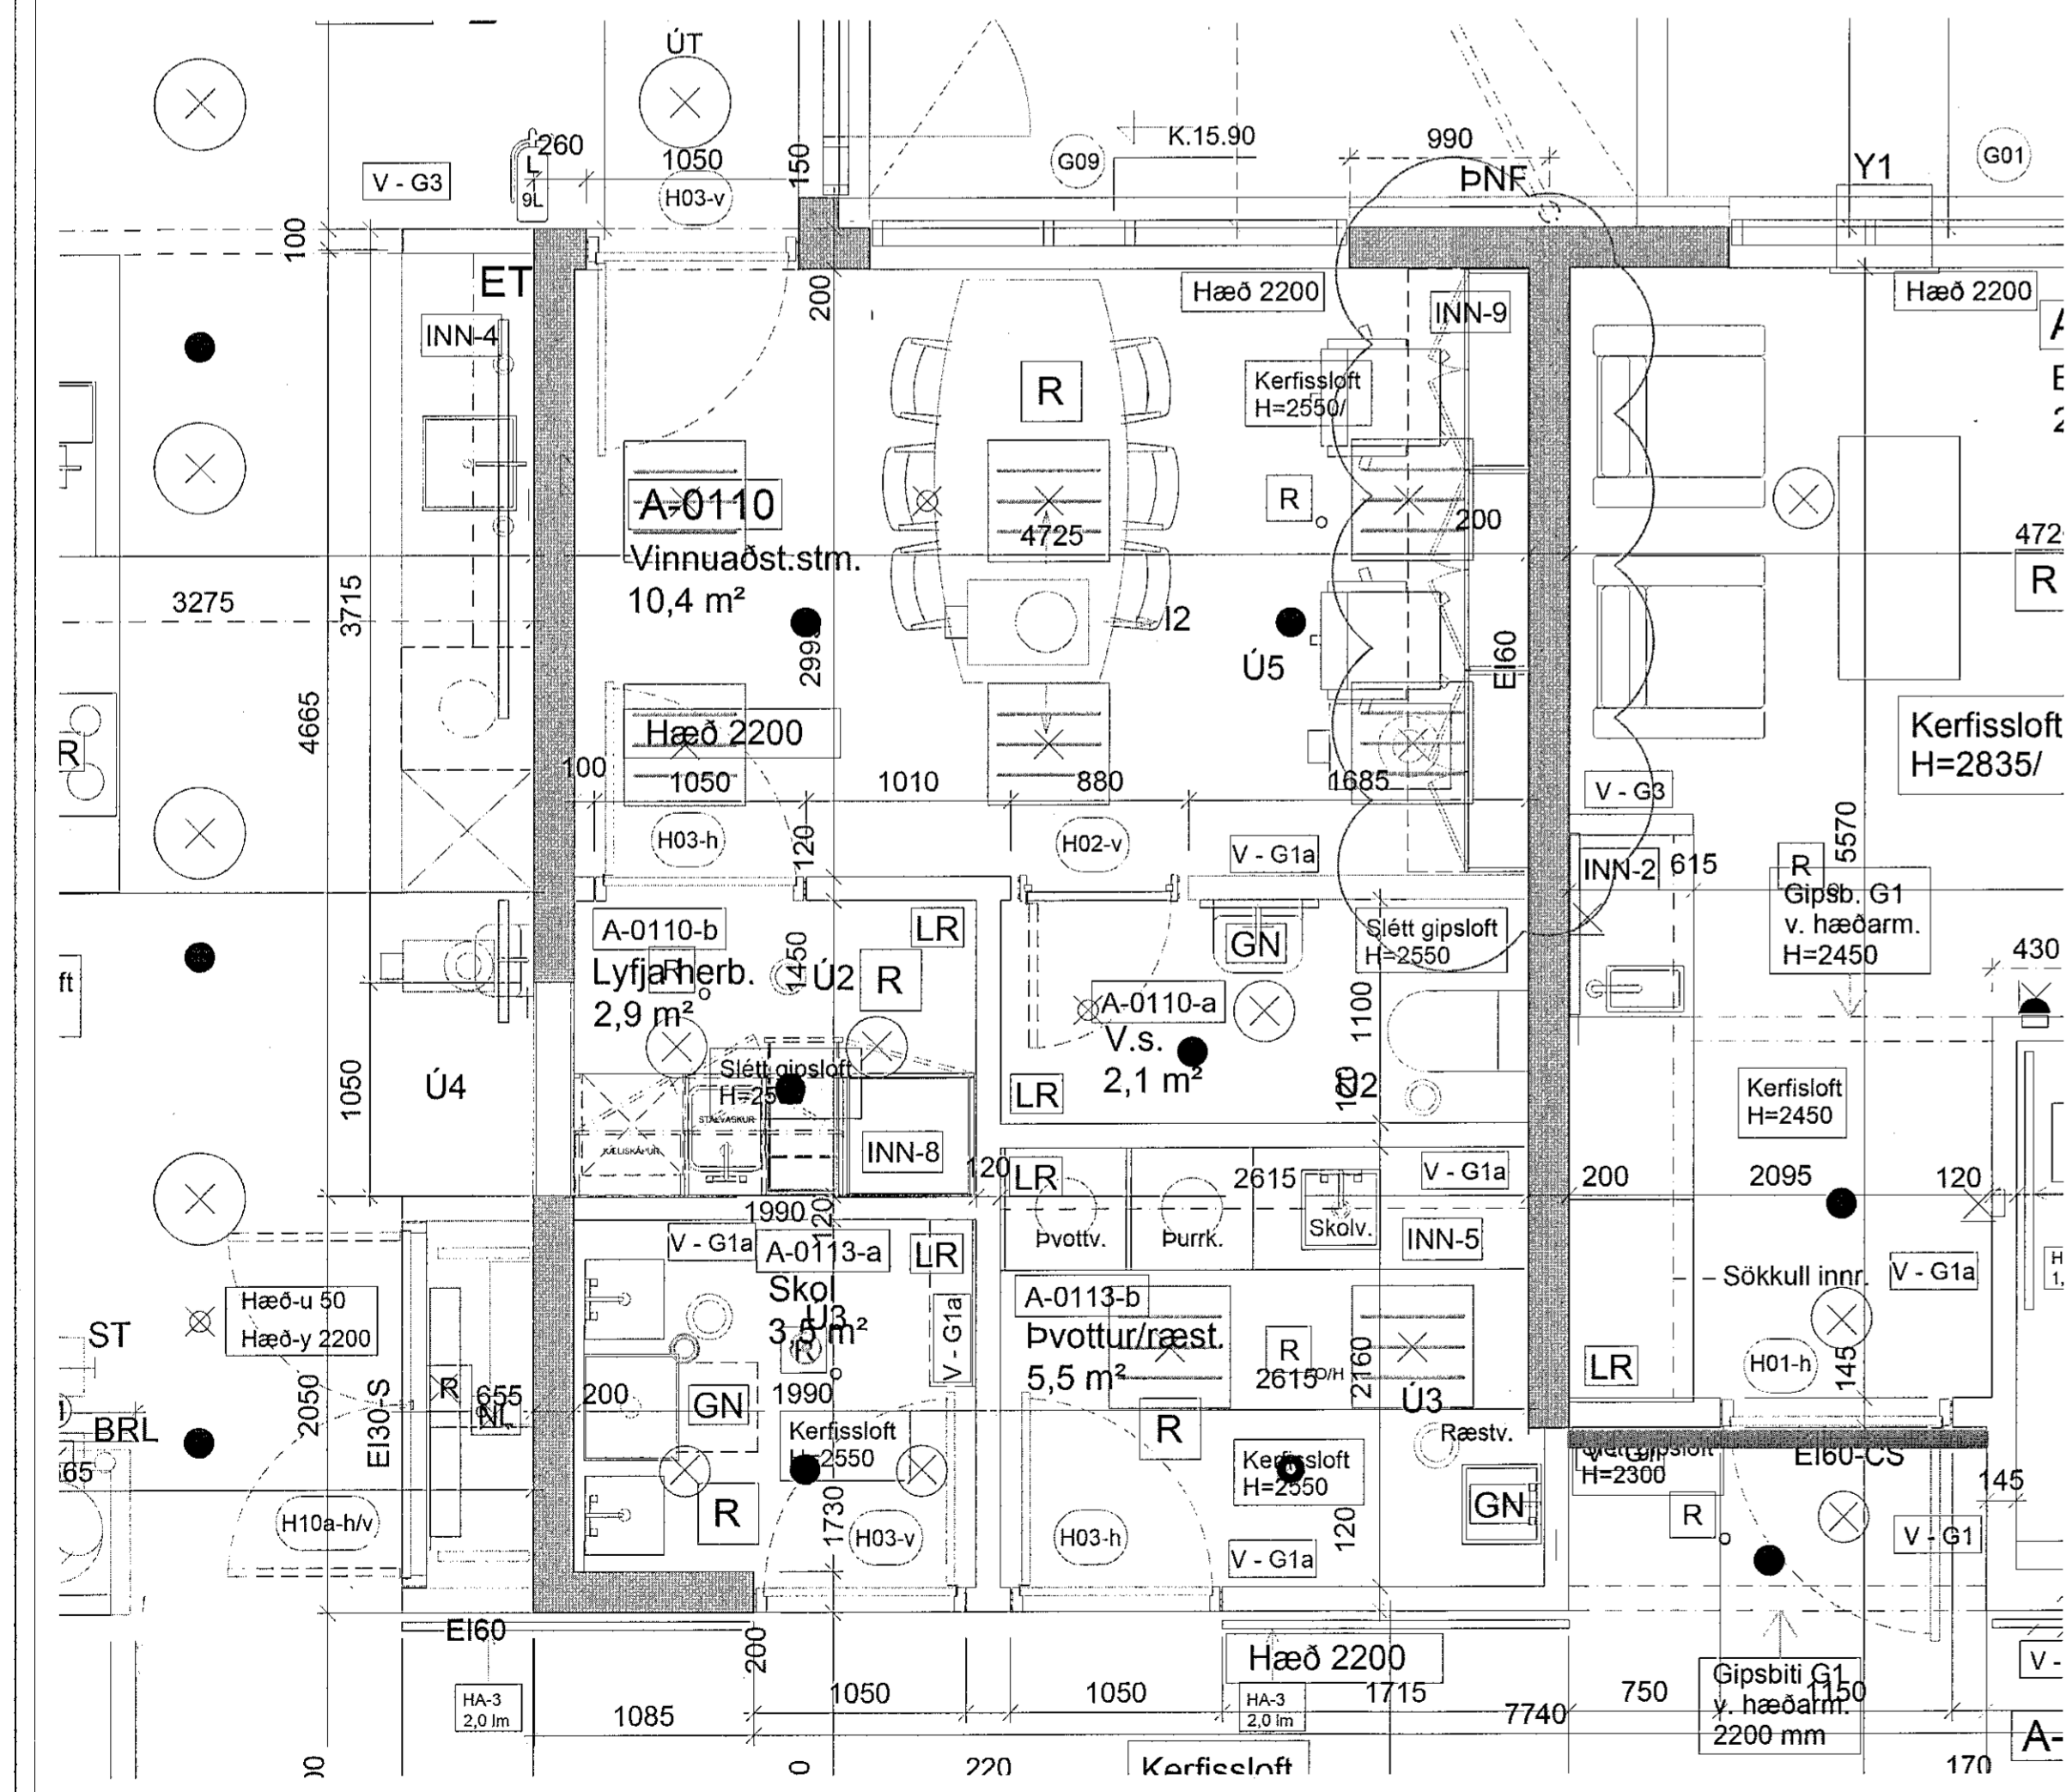


INN-10 FELLUR ÚT

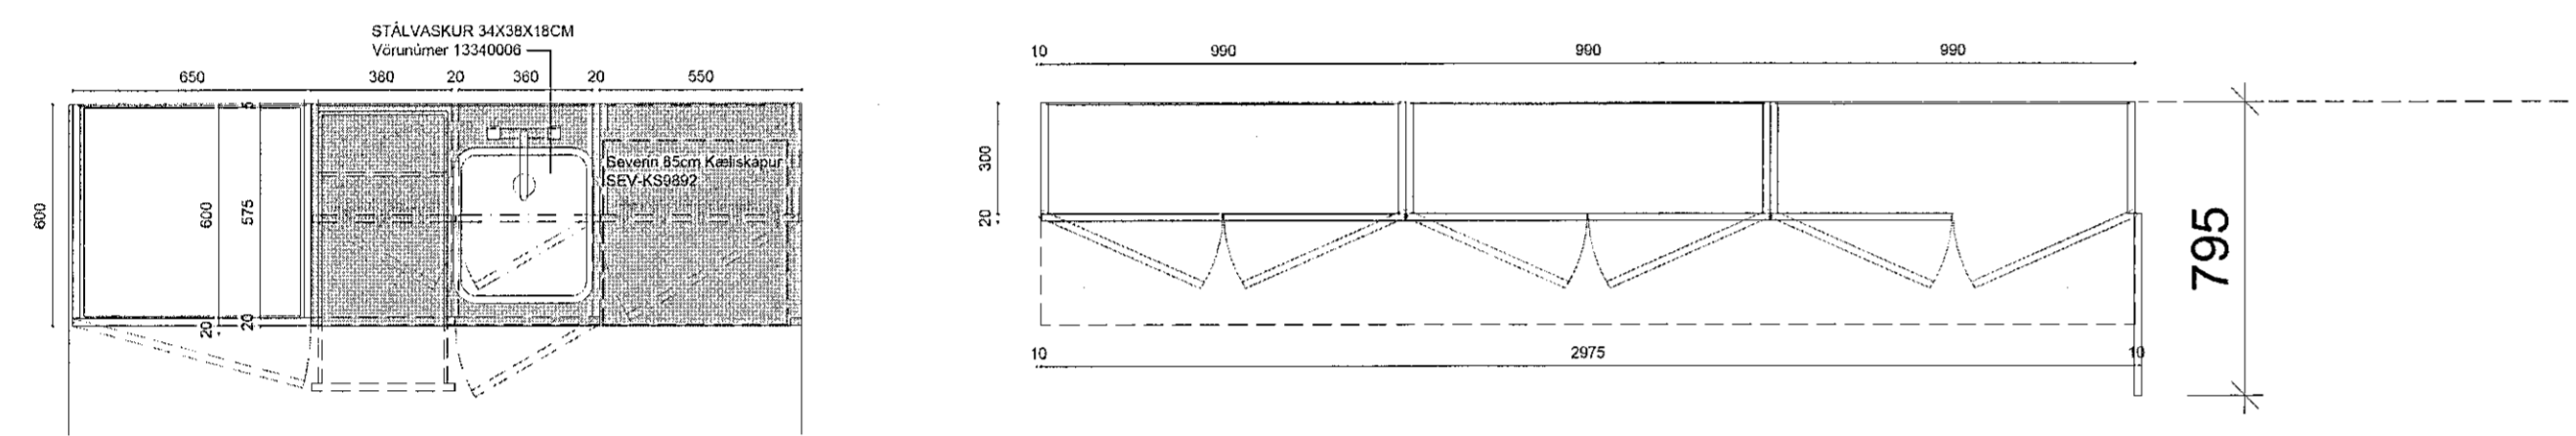

C: Nýjum innréttingum breytt 19.10.2018
A: Innréttingu breytt, fleiri uppýsingar 03.10.2018
BREYTINGAR: DAGS:

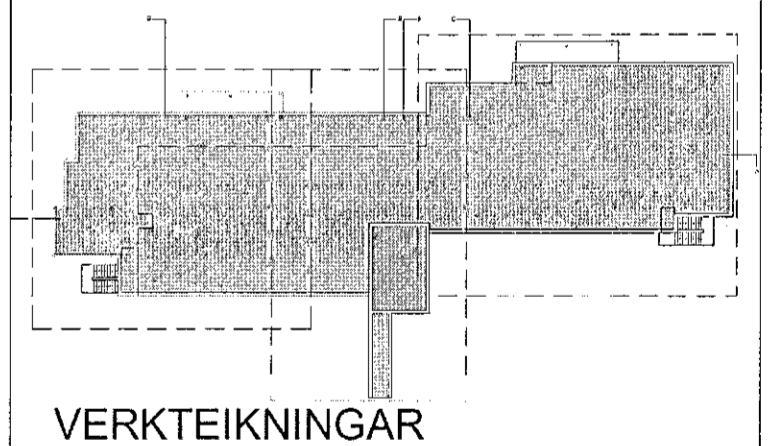

SÖLVANGUR HJÚKRUNARHEIMILI 2016
SÖLVANGSVEGI 2 HAFNARFIRÐI
VERK: SOLV 1533
KVARN: 1:20
DAGS: 12.06.2018
INNRETTINGA-YFIRLIT
TEIKN: JBP
SKRÁ: 1533-Grumur.dwg