
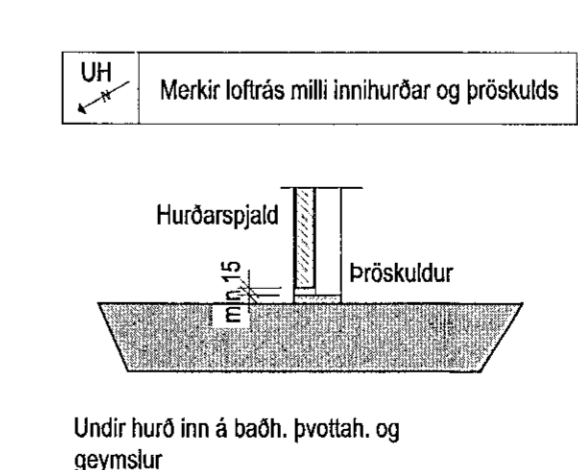
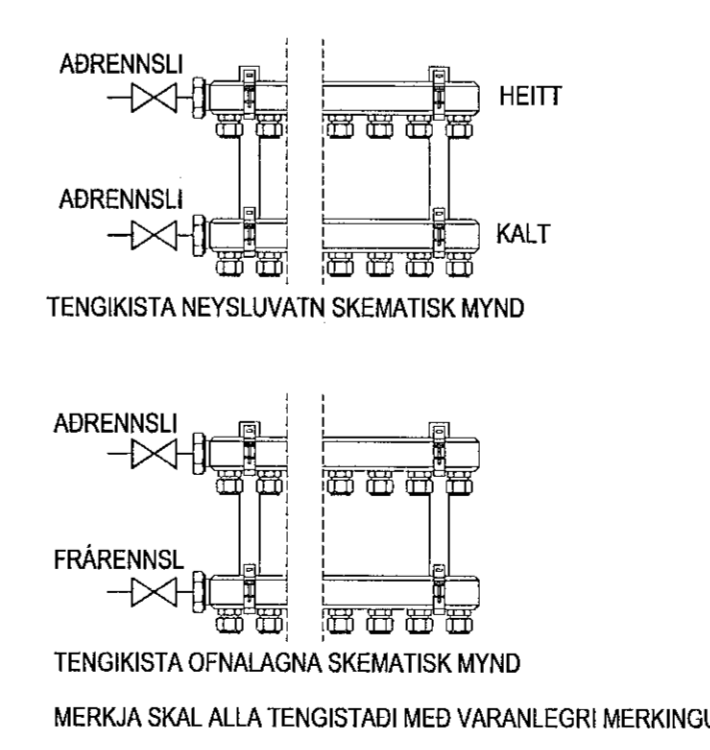
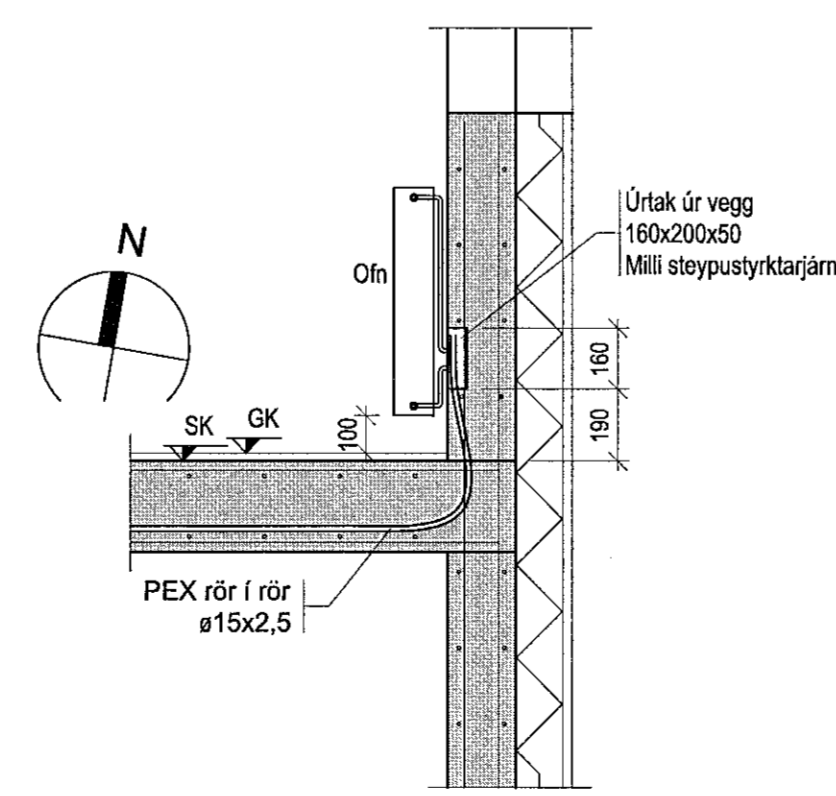


Lykilmýnd

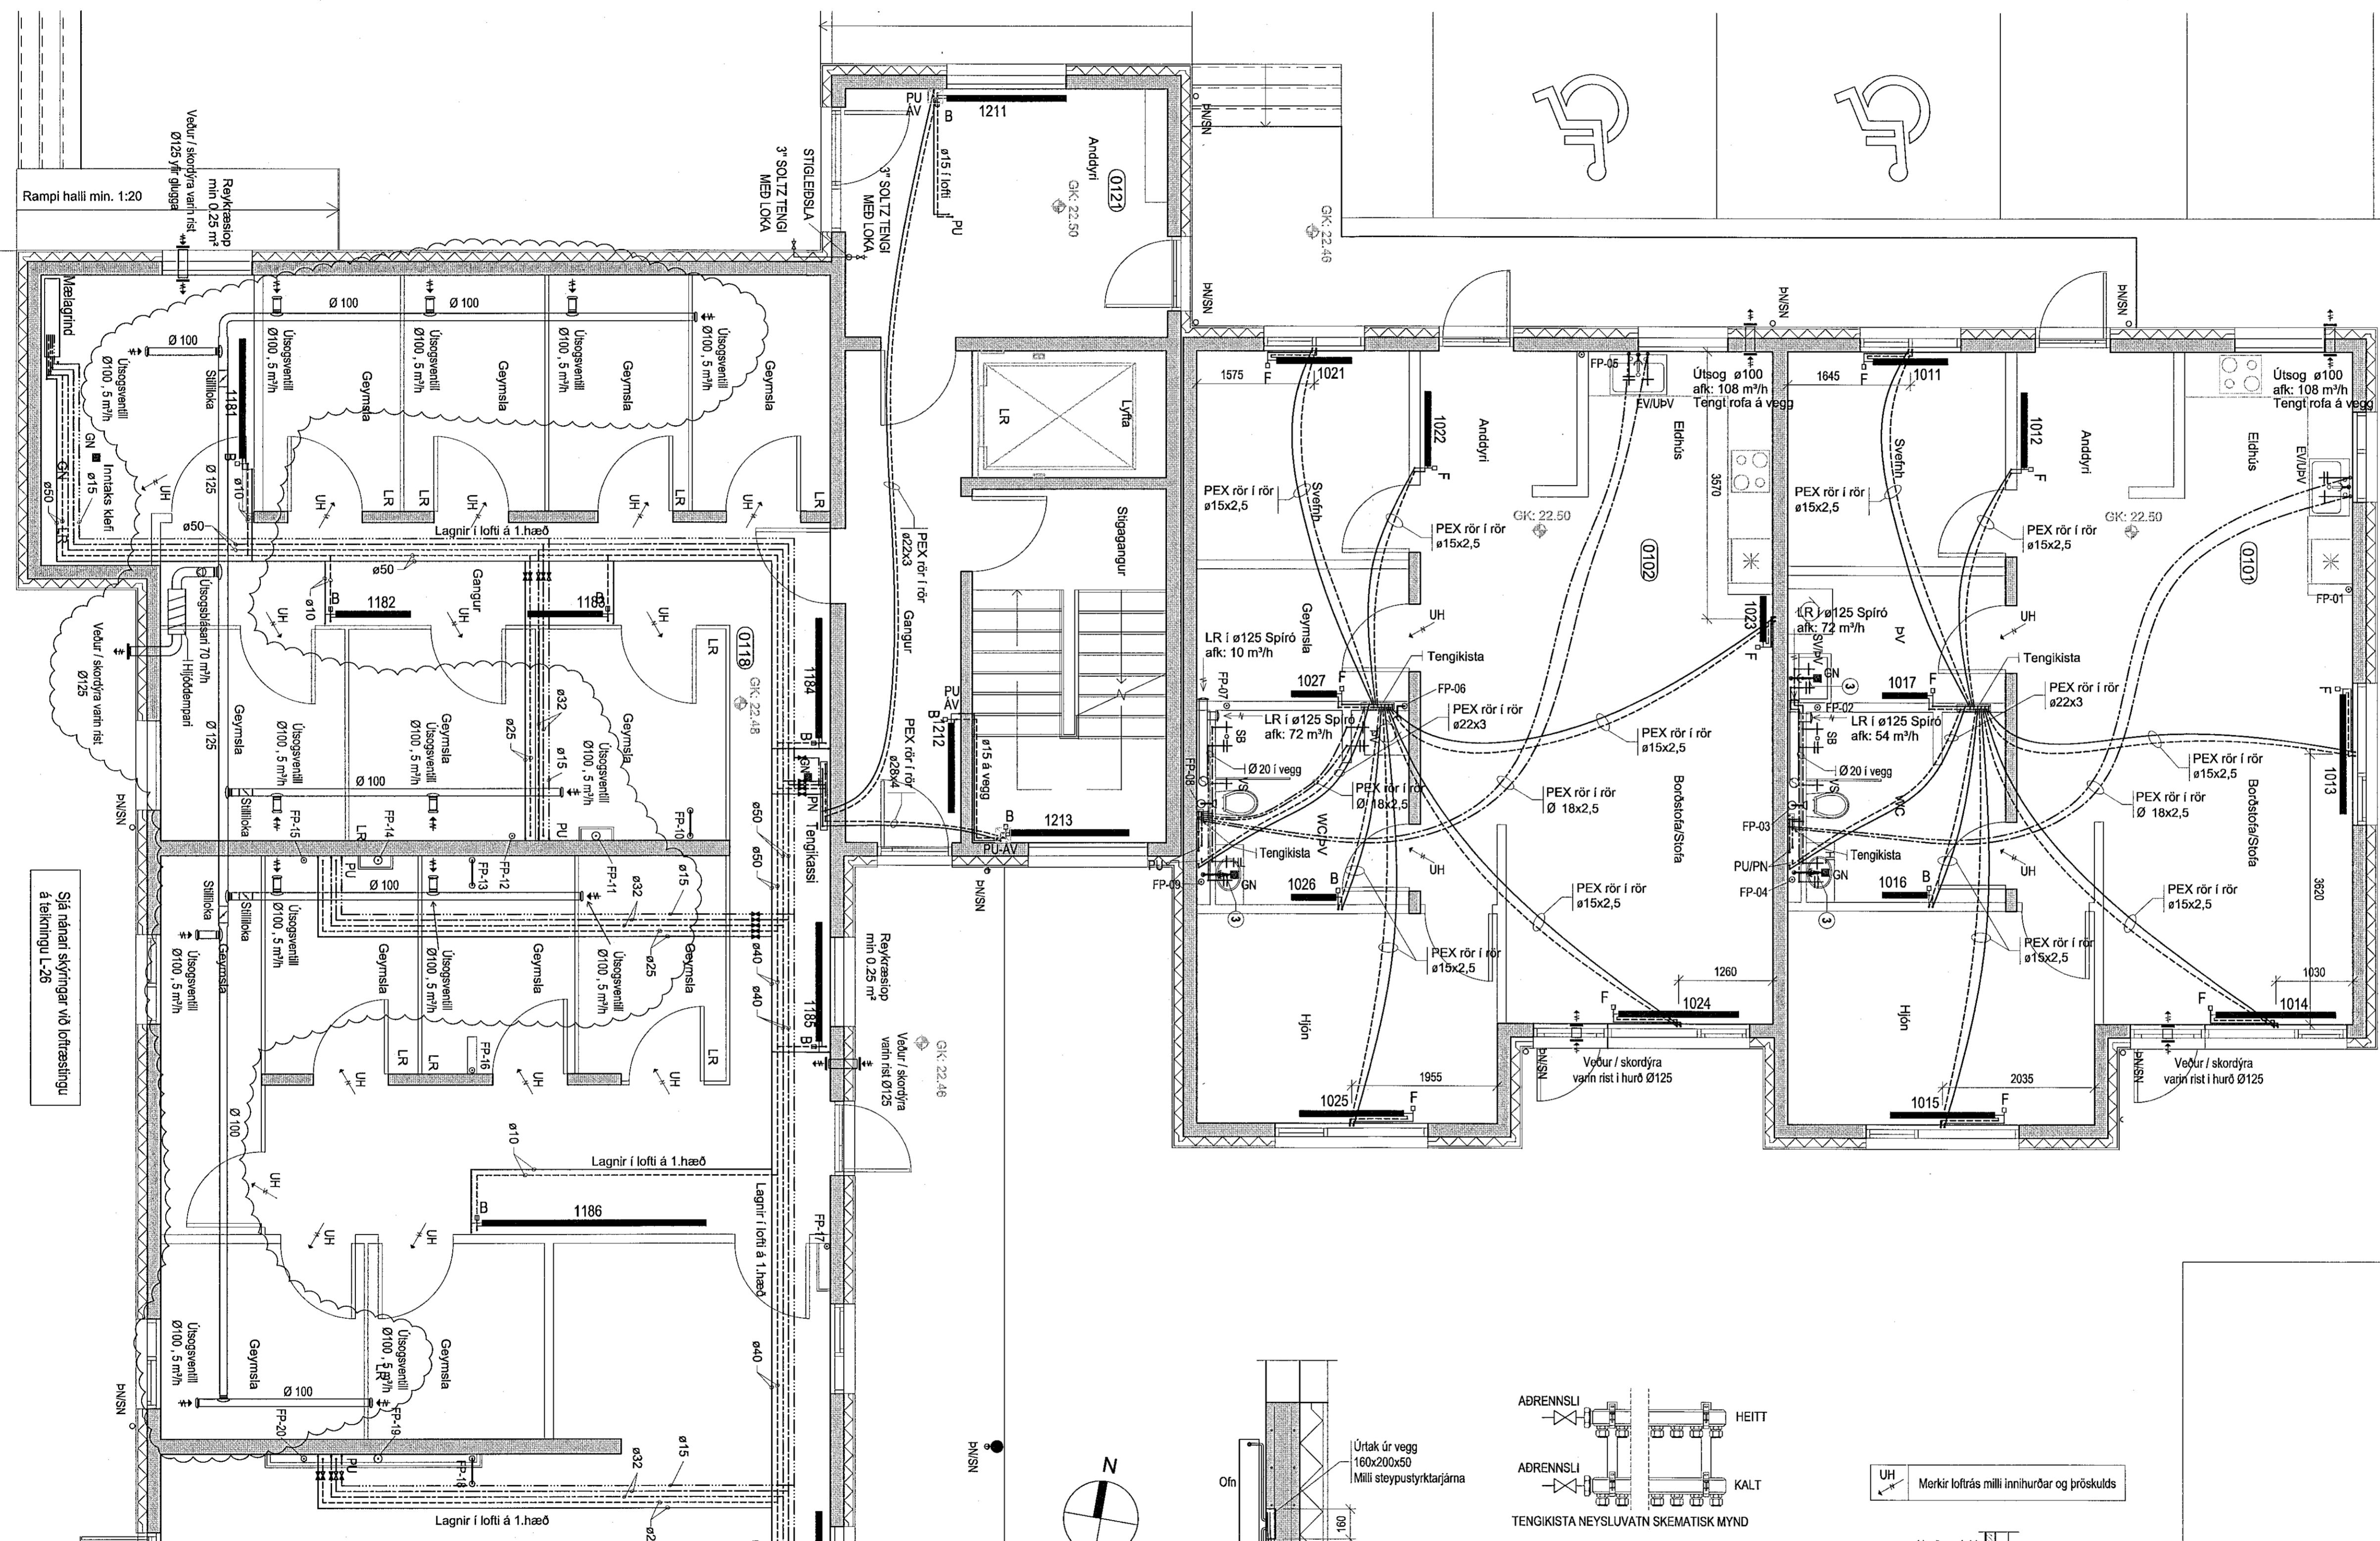

Breyting A dags. 23.10.2018  
Loftræstingnum í geymslum breytt.  
Breyting B dags. 23.10.2019  
Baðörum skipt út fyrir sturtur.

**Eskivellir 11**  
Hafnarfró

Lagnakerfi:  
Grunnmýnd: Lagnir á 1.hæð  
Þrifalagnir, ofnalagnir og loftræsting

**ABS**  
-teiknistofa-  
Jóhannes Pétursson  
Kl. 01648-3959  
Sí: 567-5107 - jph@abs.is

Manntal:	PJ	Dagsetning:	26.02.2016
Tekust:	PJ	MKV:	1:50
Sarykt:		N. skýring:	L-06