

Samblykt þann
08 APR 2020
Byggingsettuátrögn 112 með
F.h. Sigurður Skulason

LEGA LAGNA:	
PV: PIPAFER UPP	PV: PVOTTAVÉL
PN: HÍFAR FERDUR	PÜ: HÍRKARI
VO: VID SÖLF	F: UPPVÖTTAVÉL
VL: VID LOFT	B: VÖTHINNÝTUR FRAMASÁRLOKI
IR: Í RAUF	BR: BRUNNUR
IV: INNAN I VEGG	BS: BRUNASLÁNGA
IE: INNAN I ENNANGRUN	GN: GÖLFNBURFALL
Av: Á VEGG	P: BAKRENNSLIS HITAVEITU
UL: UNDR LOFTI	F: HREINSLOK
OU: OFAN Á MÍLULÖFTI	E: FALLIPIA
YD: YFIR DÝRUM	SV: SKOLVASKUR
HALLABREYTING	
BREYTING A RÖRSTAÐRD	

1. MERKINGAR

X:	OPNAN EGGUR GLUGGI EDA OPIN RIST
F:	VÖTHINNÝTUR FRAMASÁRLOKI
B:	STEYPARAD
BR:	VÖTNISALARNI
GS:	GÖLFSTÚR YFIR TENGINGU
P:	BAKRENNSLIS HITAVEITU
F:	HREINSLOK
E:	FALLIPIA
SV:	SKOLVASKUR


*OPID UNDR OGQEJA YFIR HUR,

EDA OPIN RUST.

ELDVARNALOKA E50.

STILLLOKA

LAGNA/VERMÁL					
Uppgefni DN-mál	Galv. og svart stål DN	Plast svart stål DN	Ryfrit stål stainless steel DN	PEH plast DN	AH-PEX-MD DN
(mm)	(mm)	(mm)	(mm)	(mm)	(mm)
10	3/8"	12x1,2	15x1,2	15x1	14x2
12	1/2"	12x1,2	15x1,2	15x1	16x2
15	1/2"	12x1,2	15x1,2	15x1	18x2/20x2,25
20	3/4"	22x1,2	22x1,2	25x1,8	25x2,5
25	1"	28x1,5	28x1,2	32x1,9	32x3
32	1 1/4"	35x1,5	35x1,5	40x2,3	40x4
40	1 1/2"	42x1,5	42x1,5	50x2,9	50x4,5
50	2"	54x1,5	54x1,5	63x3,6	63x6
63	2 1/2"	76,1x2	75x4,3	75x7,5	

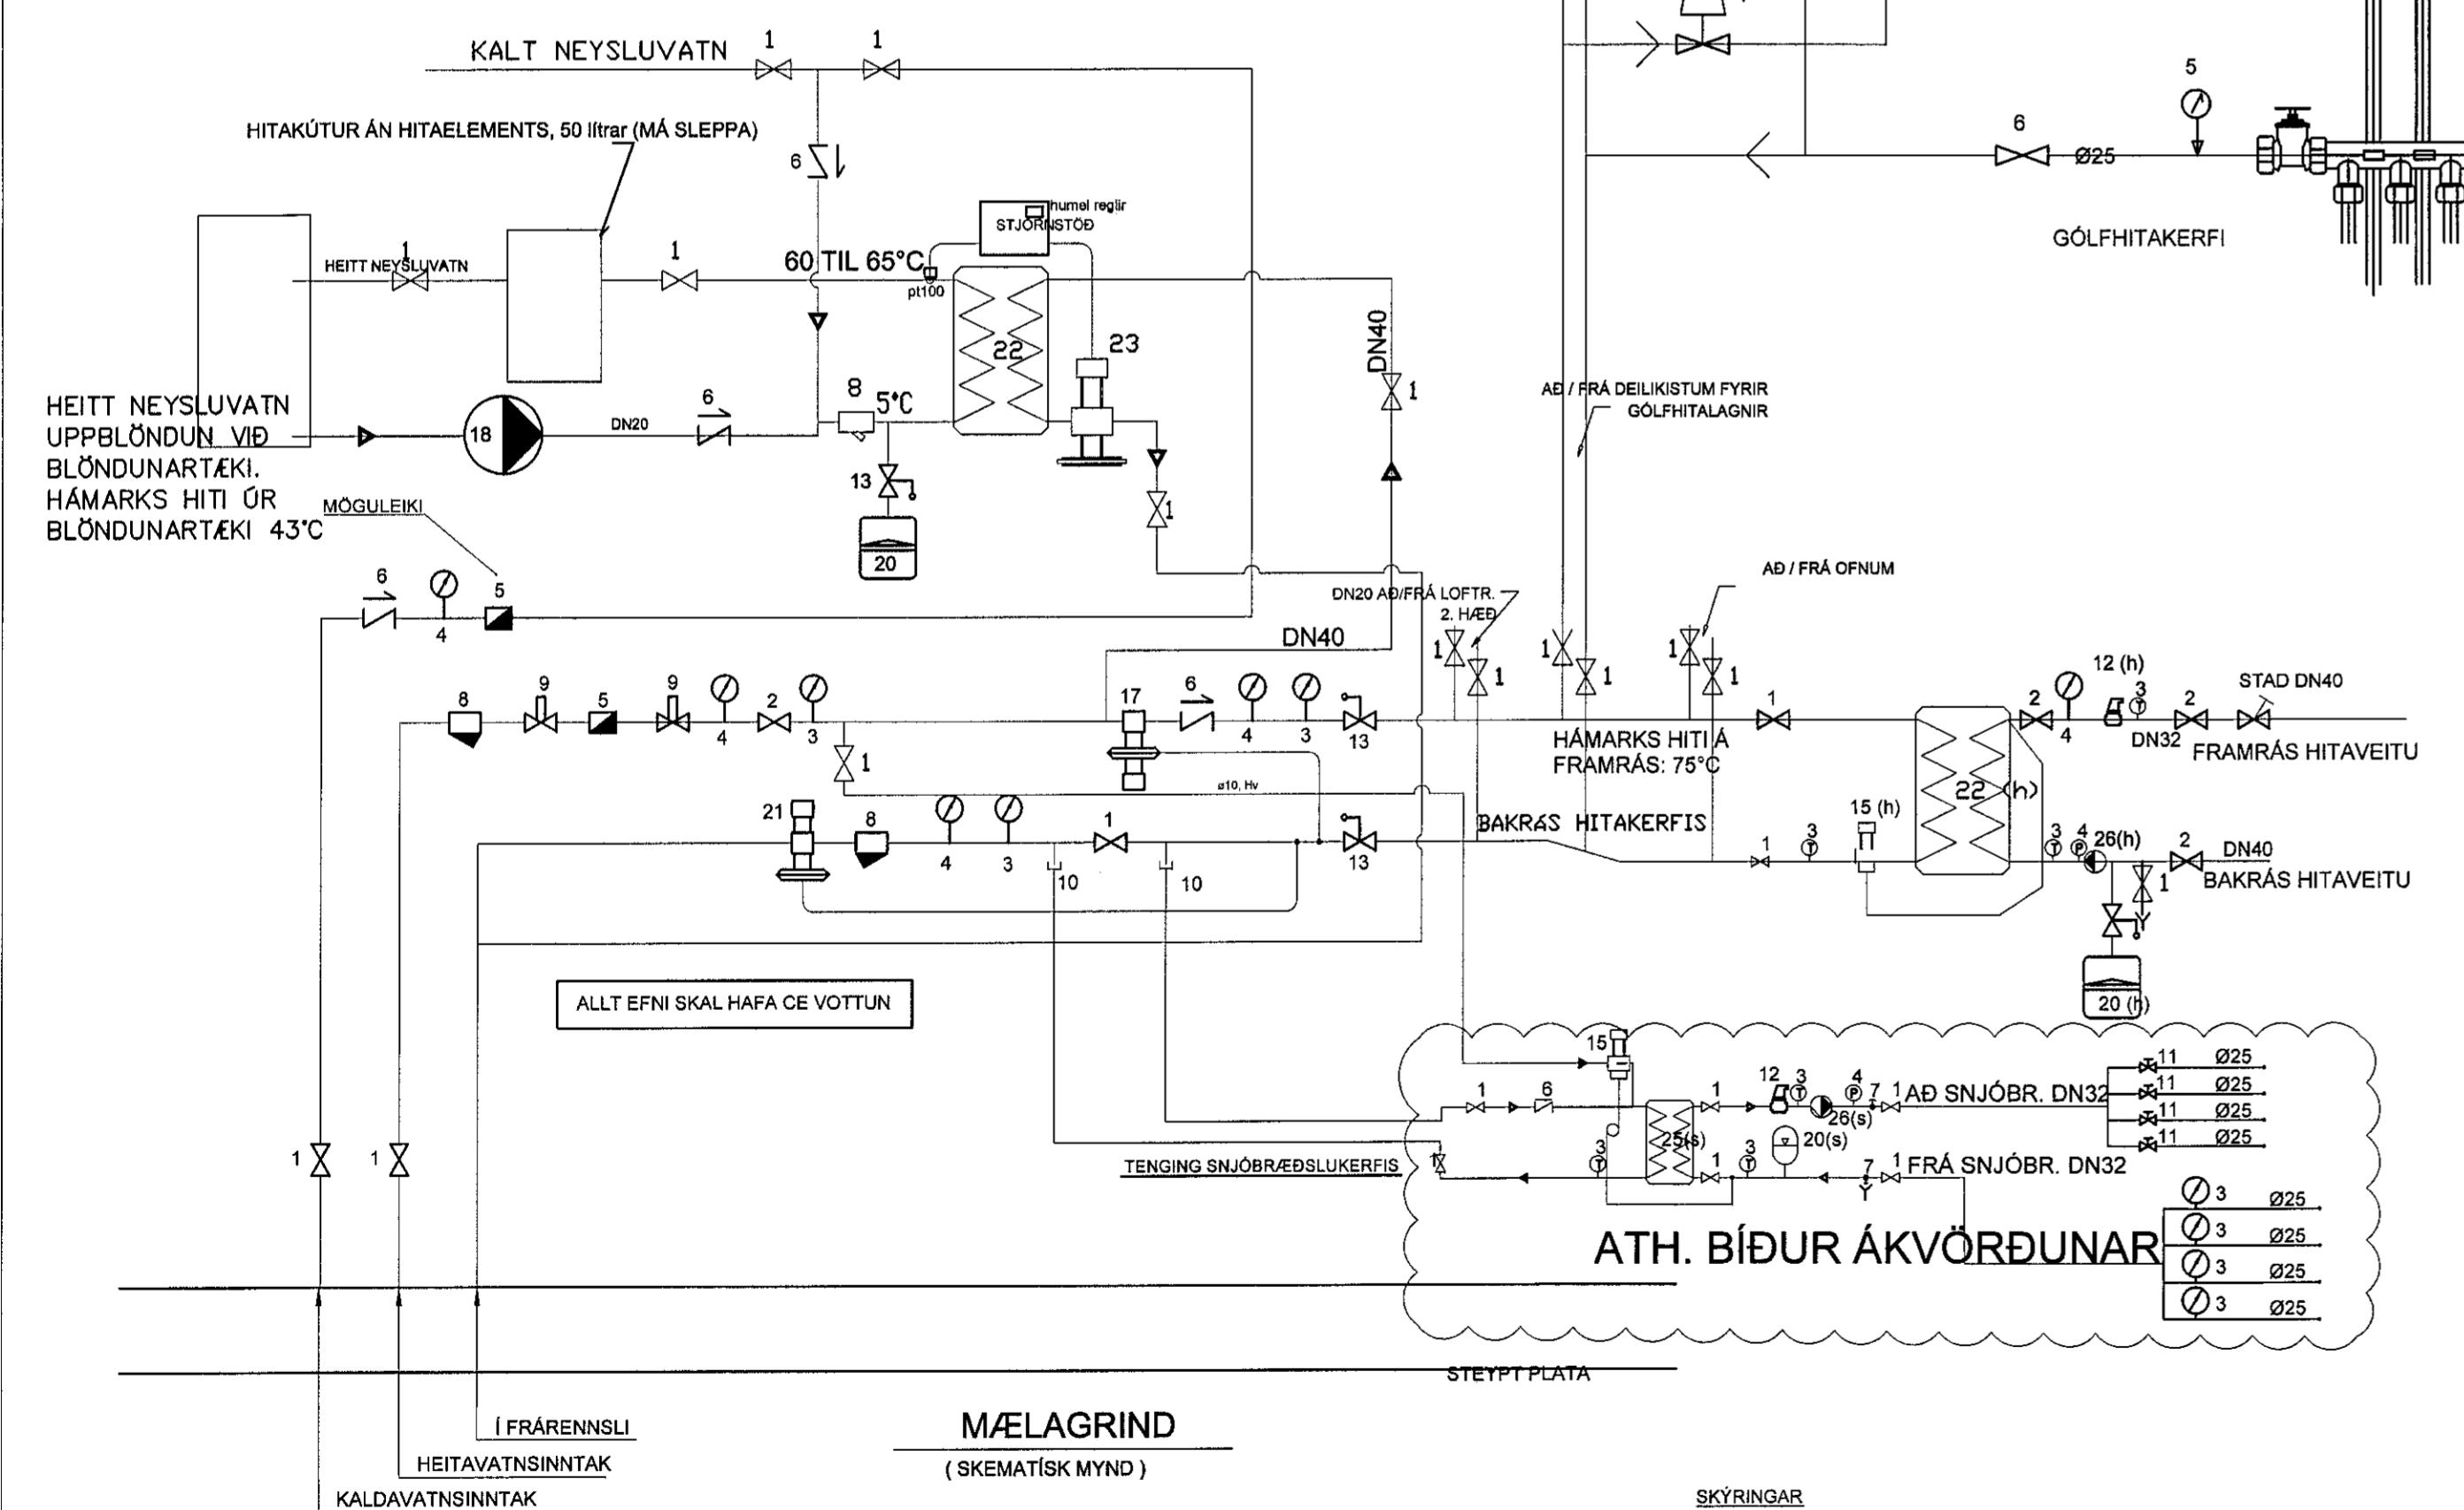

AB / FRÄ DEILIKISTUM 1

