




Samþykkt bann  
 07. okt. 2020  
 F.h. byggingarfulltrúans í Hafnarhúsi  
 Sigurður Steinar Jónsson

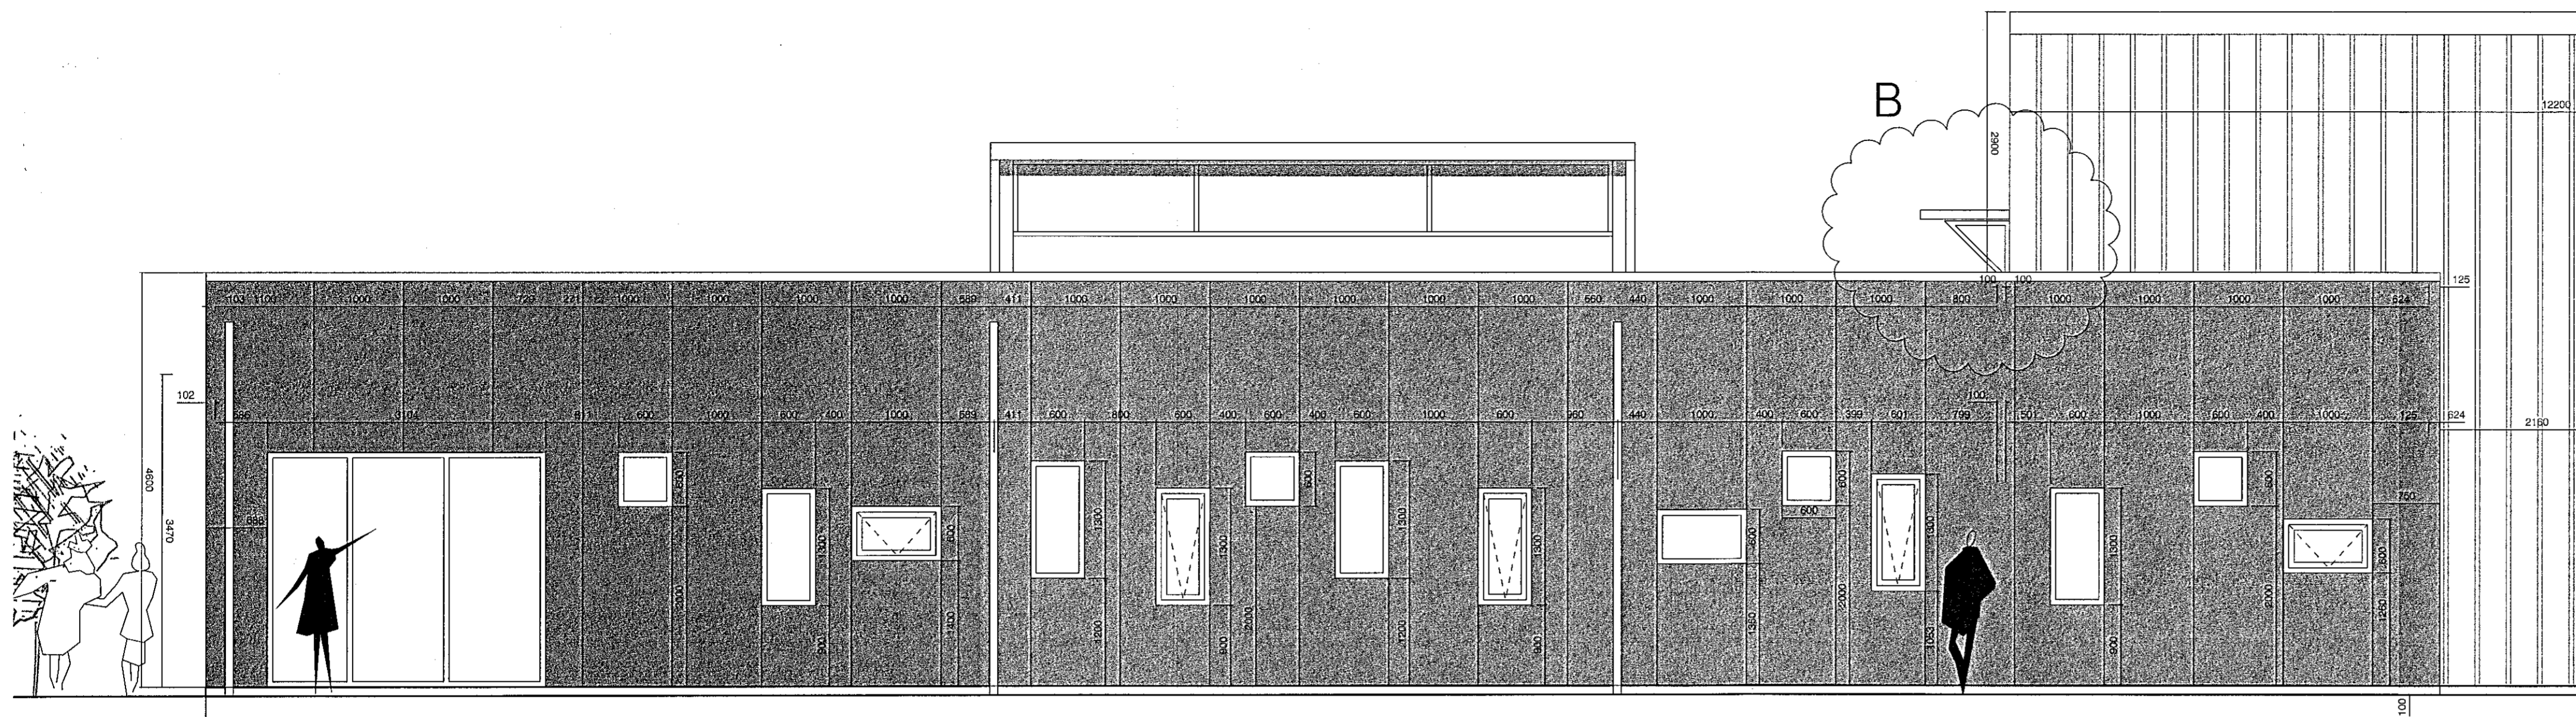

Vesturhlid

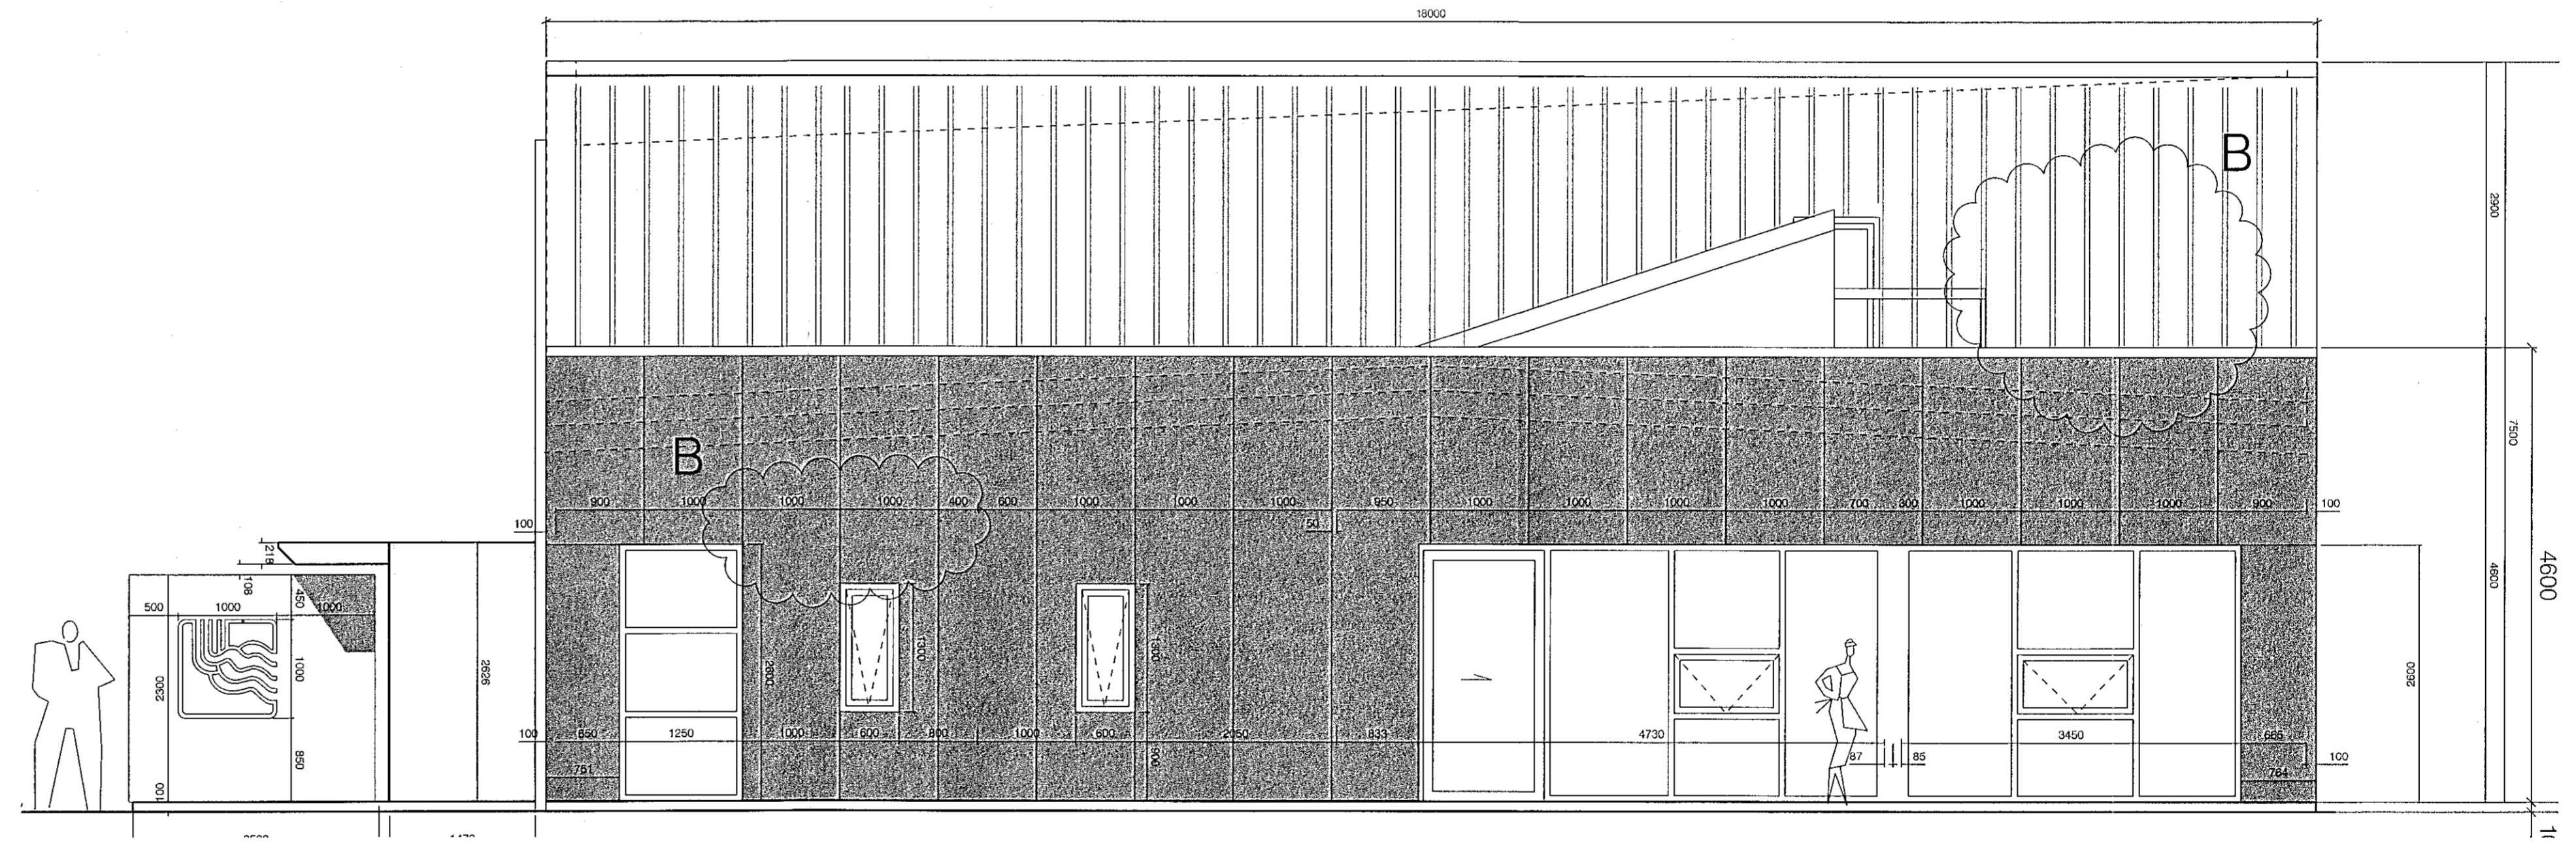

Sudurhliod

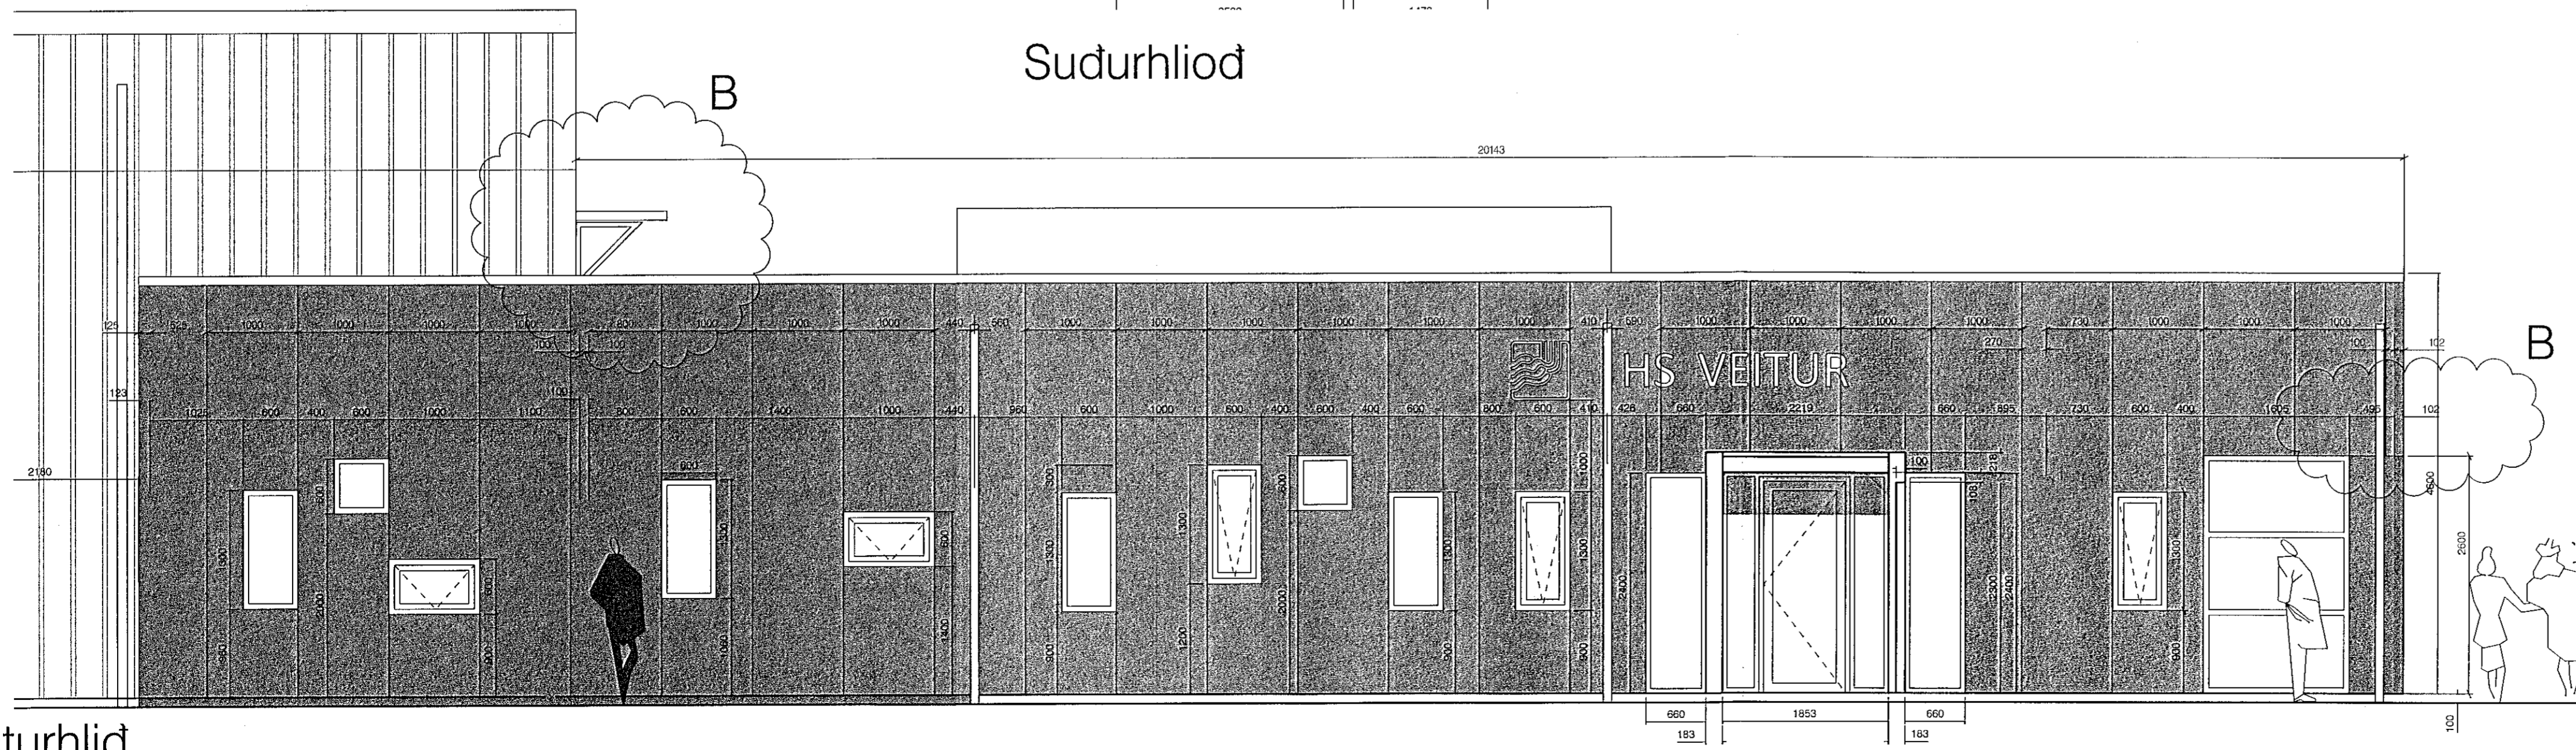

Austurhlid

B: 09.09.2020  
 Flóttaleid breytt,  
 Þakskyggni fjarlægð.  
 A: 19.03.2020  
 Leikretir gluggar



Verkefni: Selhella 8  
 HS Veitur

Útlit

Teikning nr. 50-25B  
 Mál 1:50  
 Dags. 06.02.2020  
 Teiknað ÚLB

Fiskjalad 31 101 Reykjavík  
 Sími 5511790 gpark@gpark.is  
 Góður Pálsson gpark@gpark.is  
 Kt. 291246-4519 Arkitekt FAI