



Samþykkt þann
 07. okt. 2020
 Sigurður Steinar Jónsson

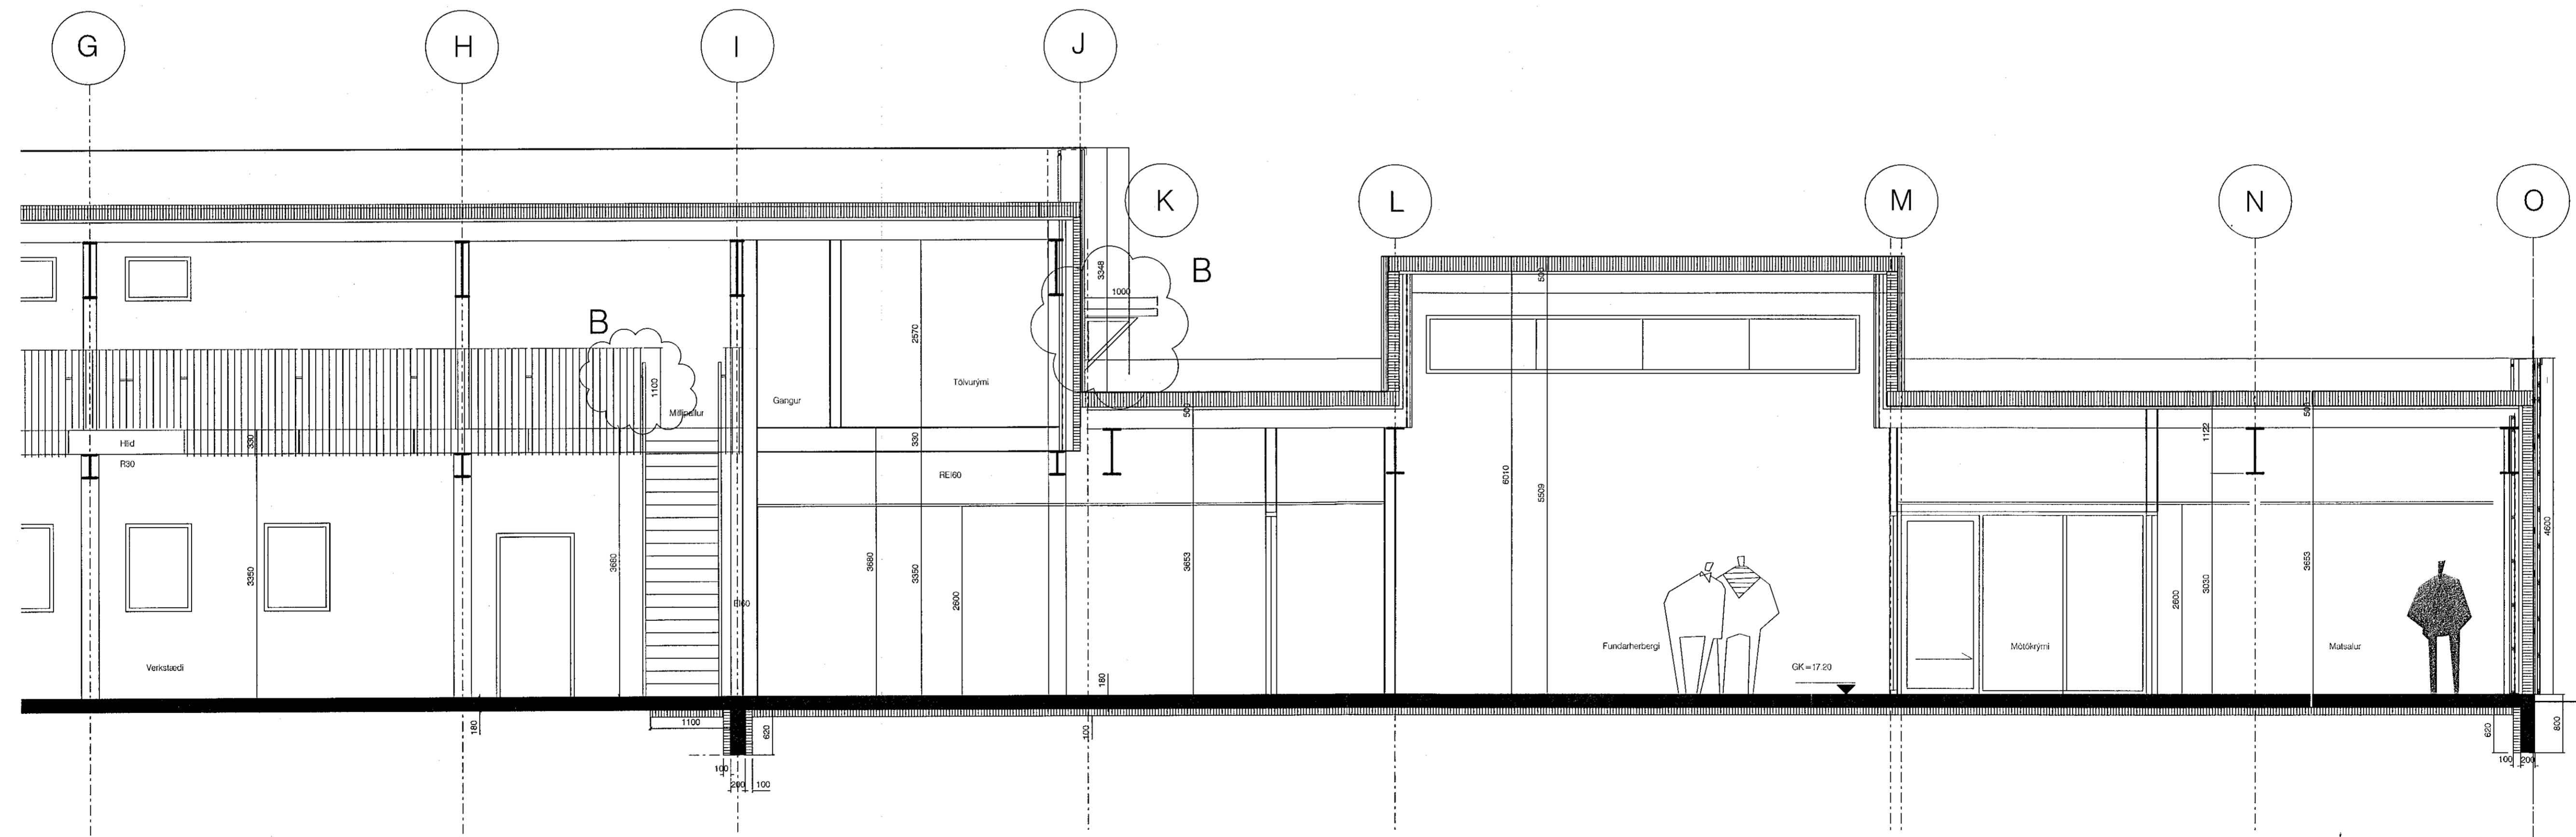

Sneid H-H

B: 09.09.2020
 Flötaleid breitt.
 Handdrif hækkja.
 A: 19.03.2020
 Flötaleid breitt.

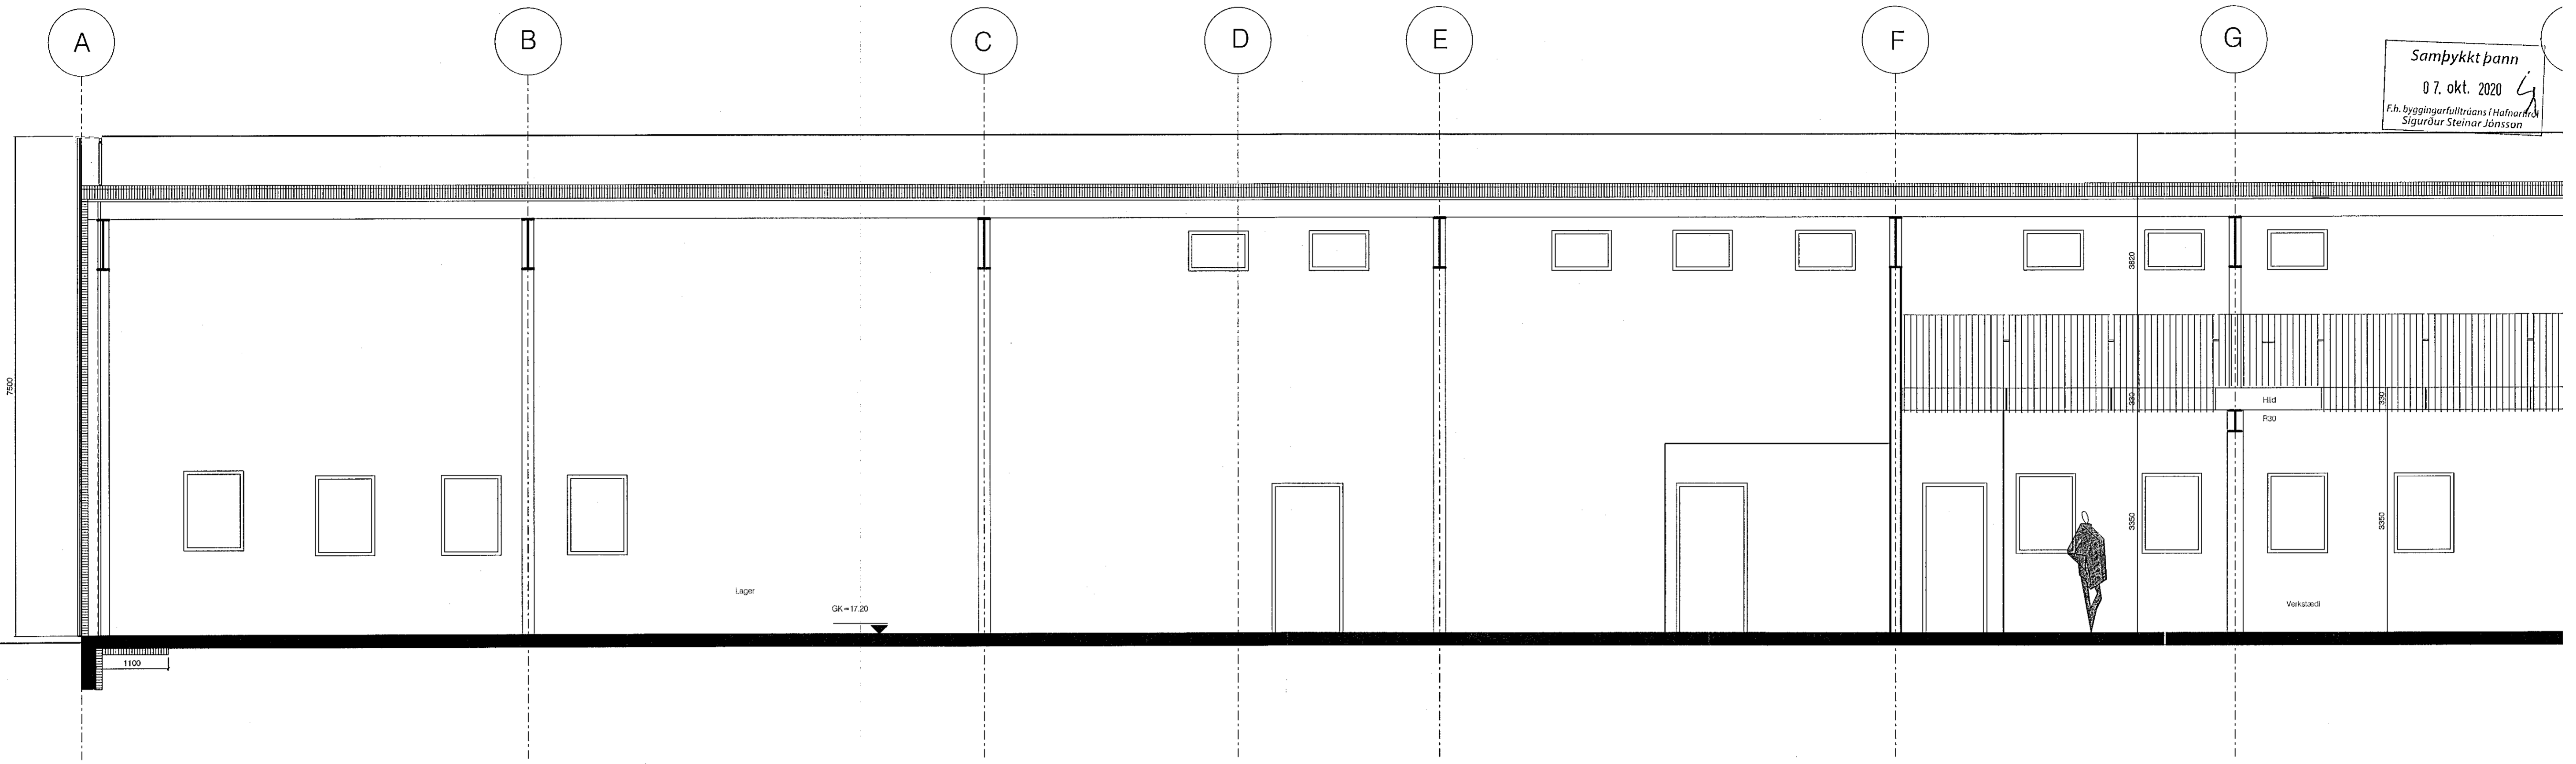

Verkefni: Selhella 8

Sneid
 HH

Teikning nr. 50-09B
 Mál 1:50
 Dags. 06.11.2019
 Teknad. UJB

Fiskisloð 31 101 Reykjavík
 Sími: 5511790 gpark@gpark.is
 5621298
 Sigurður Steinar Jónsson
 Kt. 291246-4519 Arkitekt FAI