



Samþykkt þann

07. okt. 2020 / 1

F.H. byggingarfulltrúans í Hafnarfirði
Sigurður Steinar Jónsson

1

5

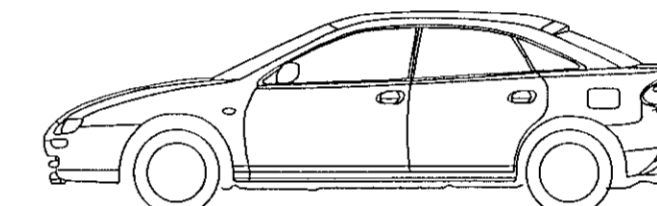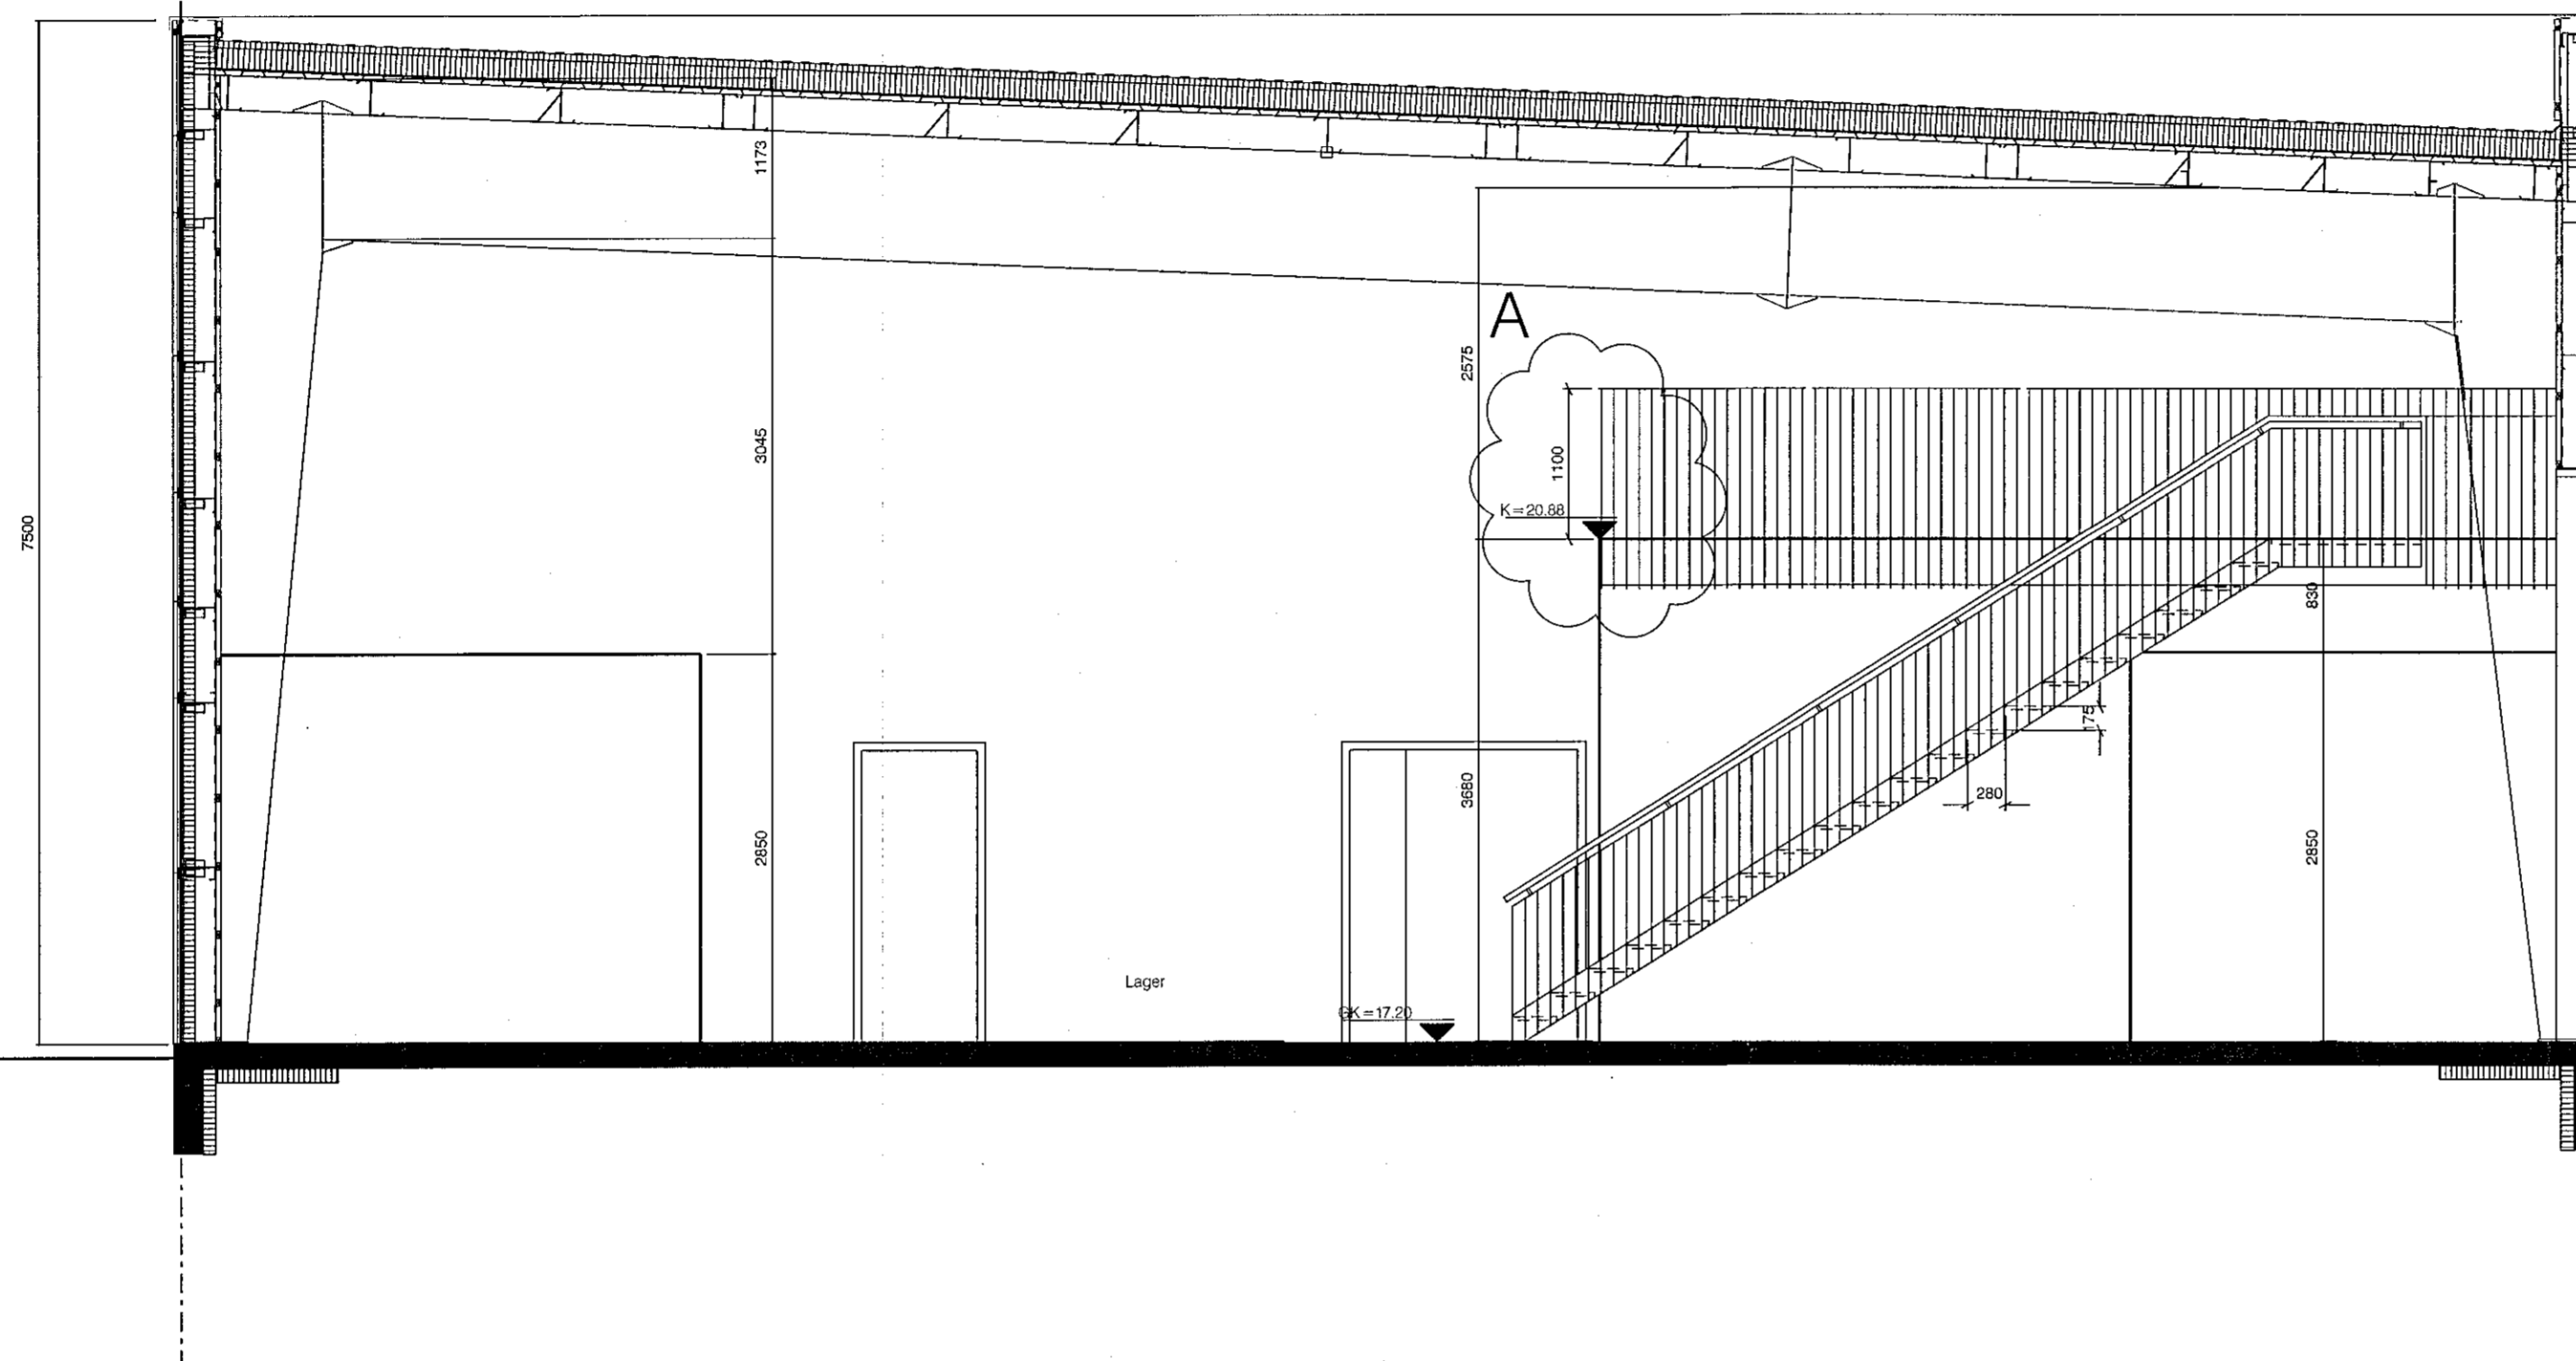

Sneid G-G

A: 09.09.2020
Handrit hækkar.

GP ARKITEKTAR

Verkefni: Selhella 8

Sneid
GG

Teikning nr. 50-08A
Mál 1:50
Dags. 06.11.2019
Teiknad. UJB

Fiskibod 31 101 Reykjavík
Sími: 5511790 gpark@gpark.is
5621790
Guðrún Pálmón
Kt. 291246-4519 Arkitekt FAL