



Samþykkt þann  
 07. okt. 2020  
 F.h. byggingarfulltrúans í Hafnarvíð  
 Sigurður Steinar Jónsson

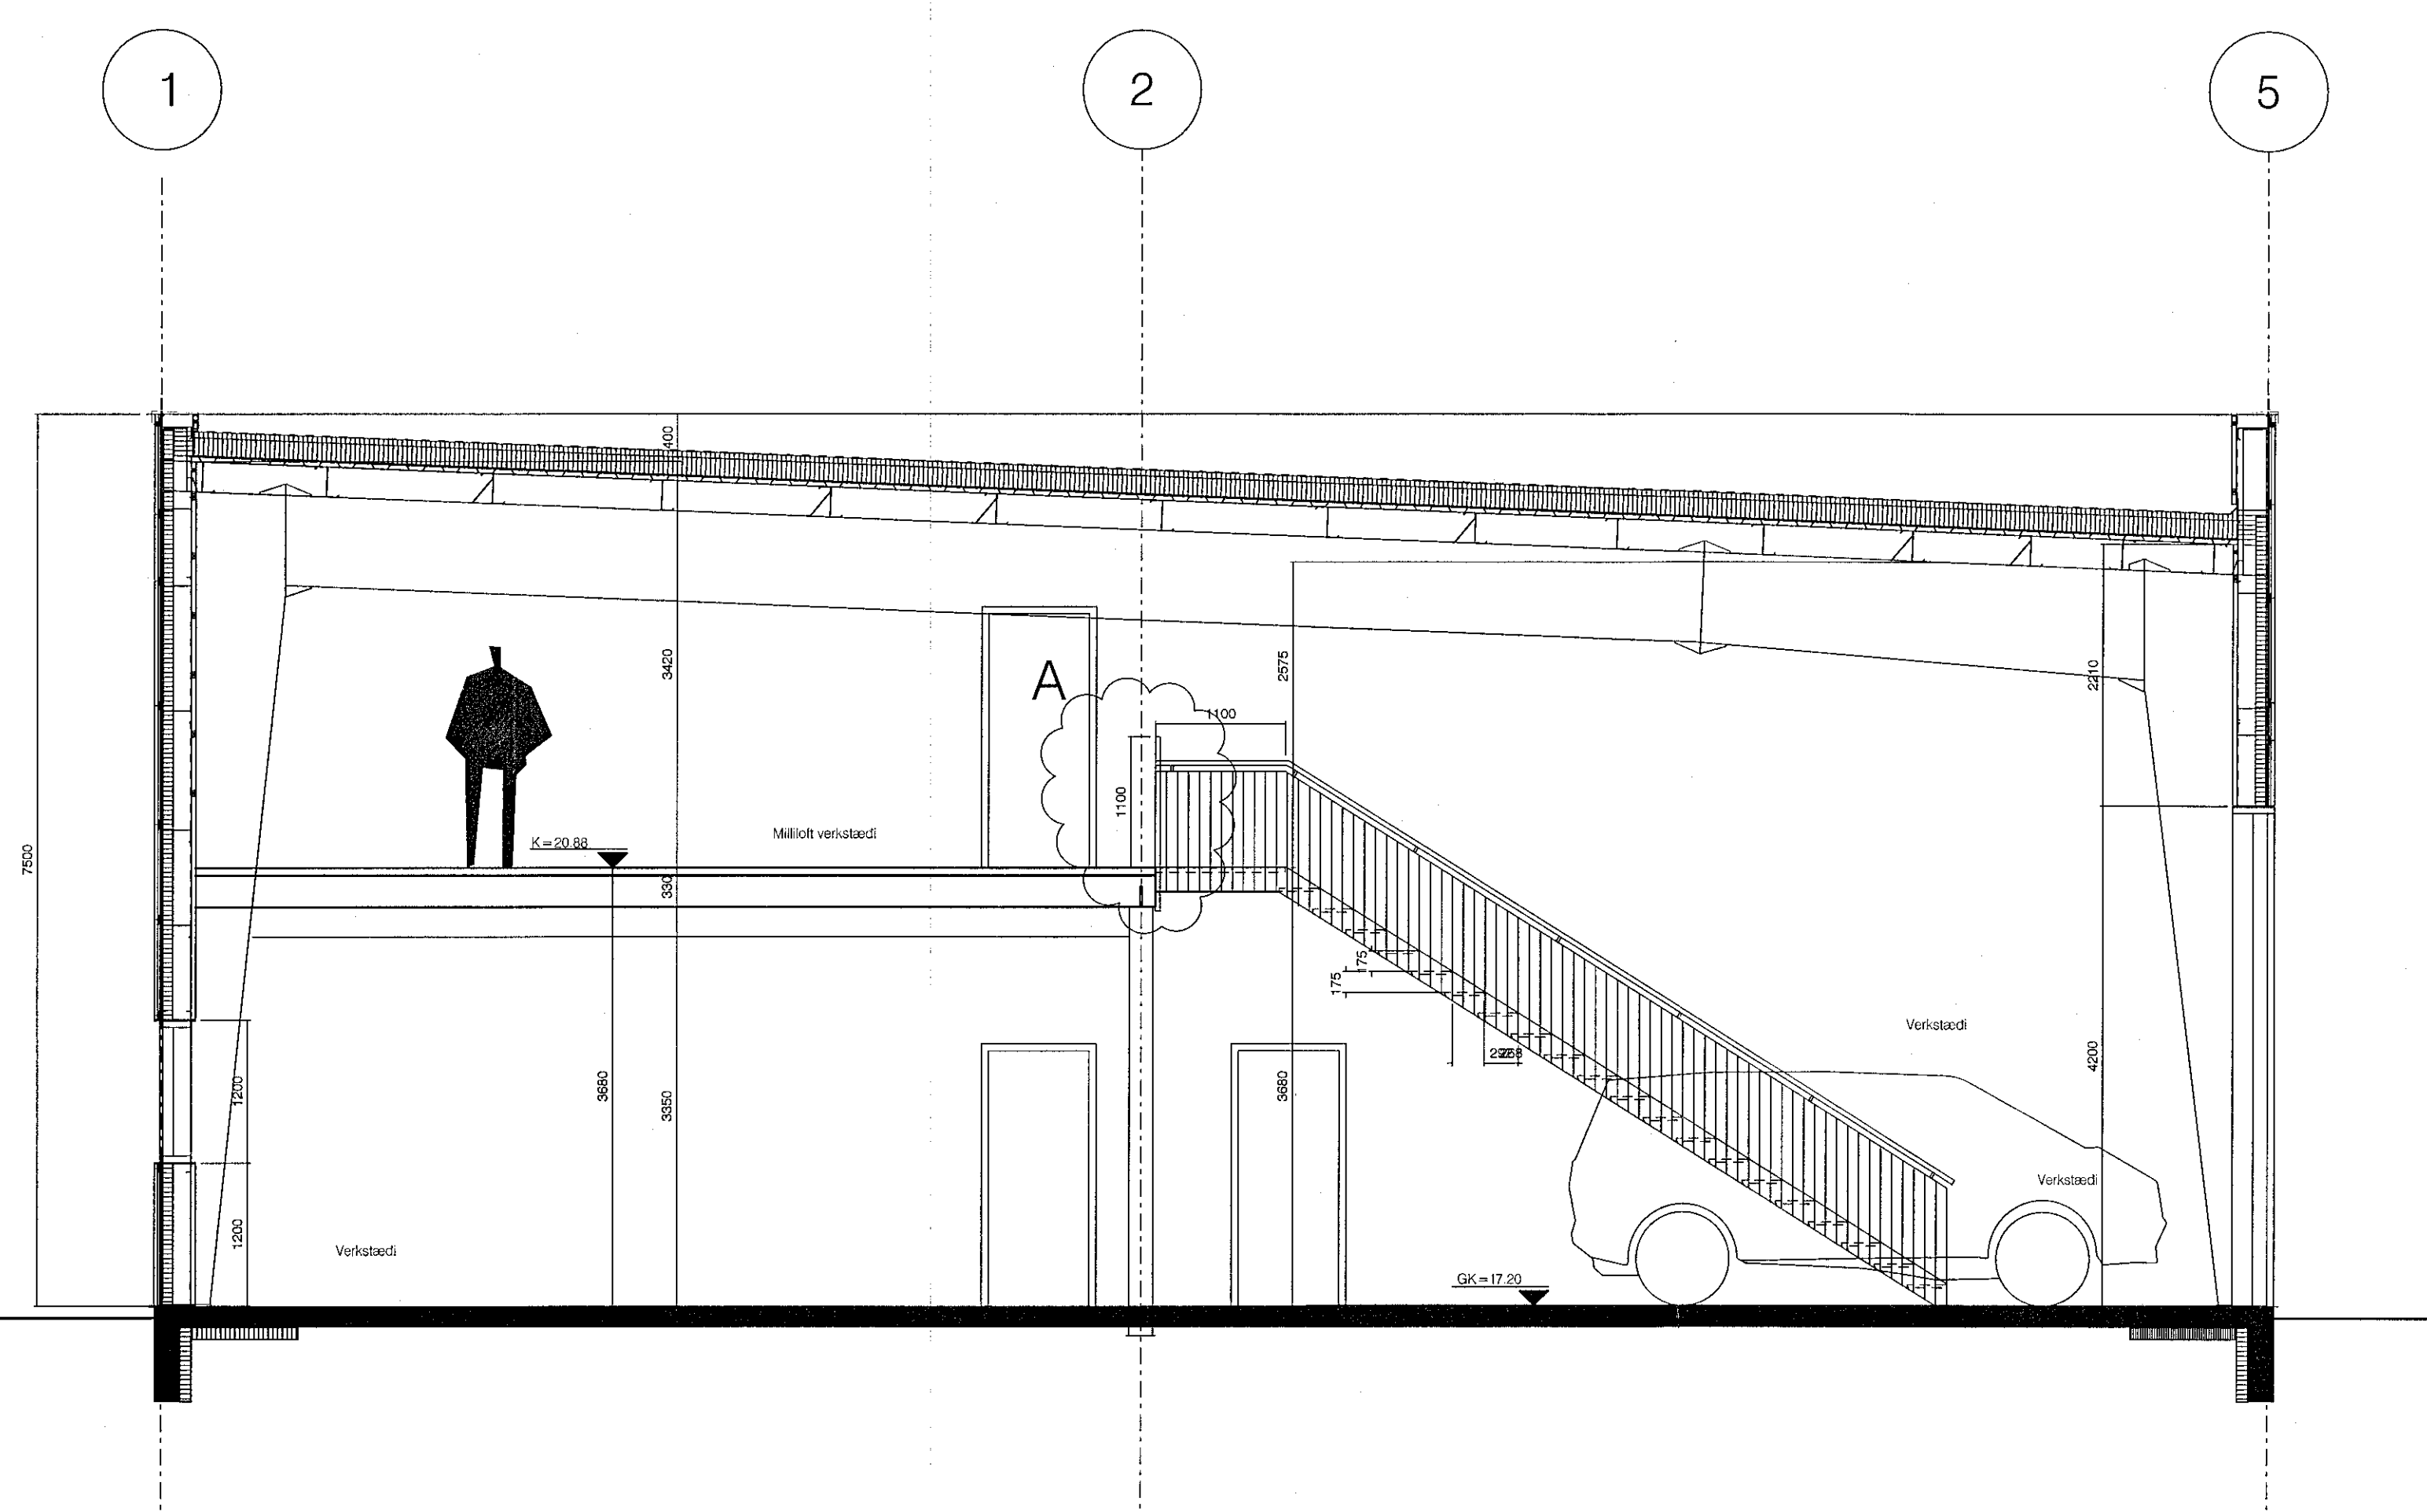

Sneid E-E

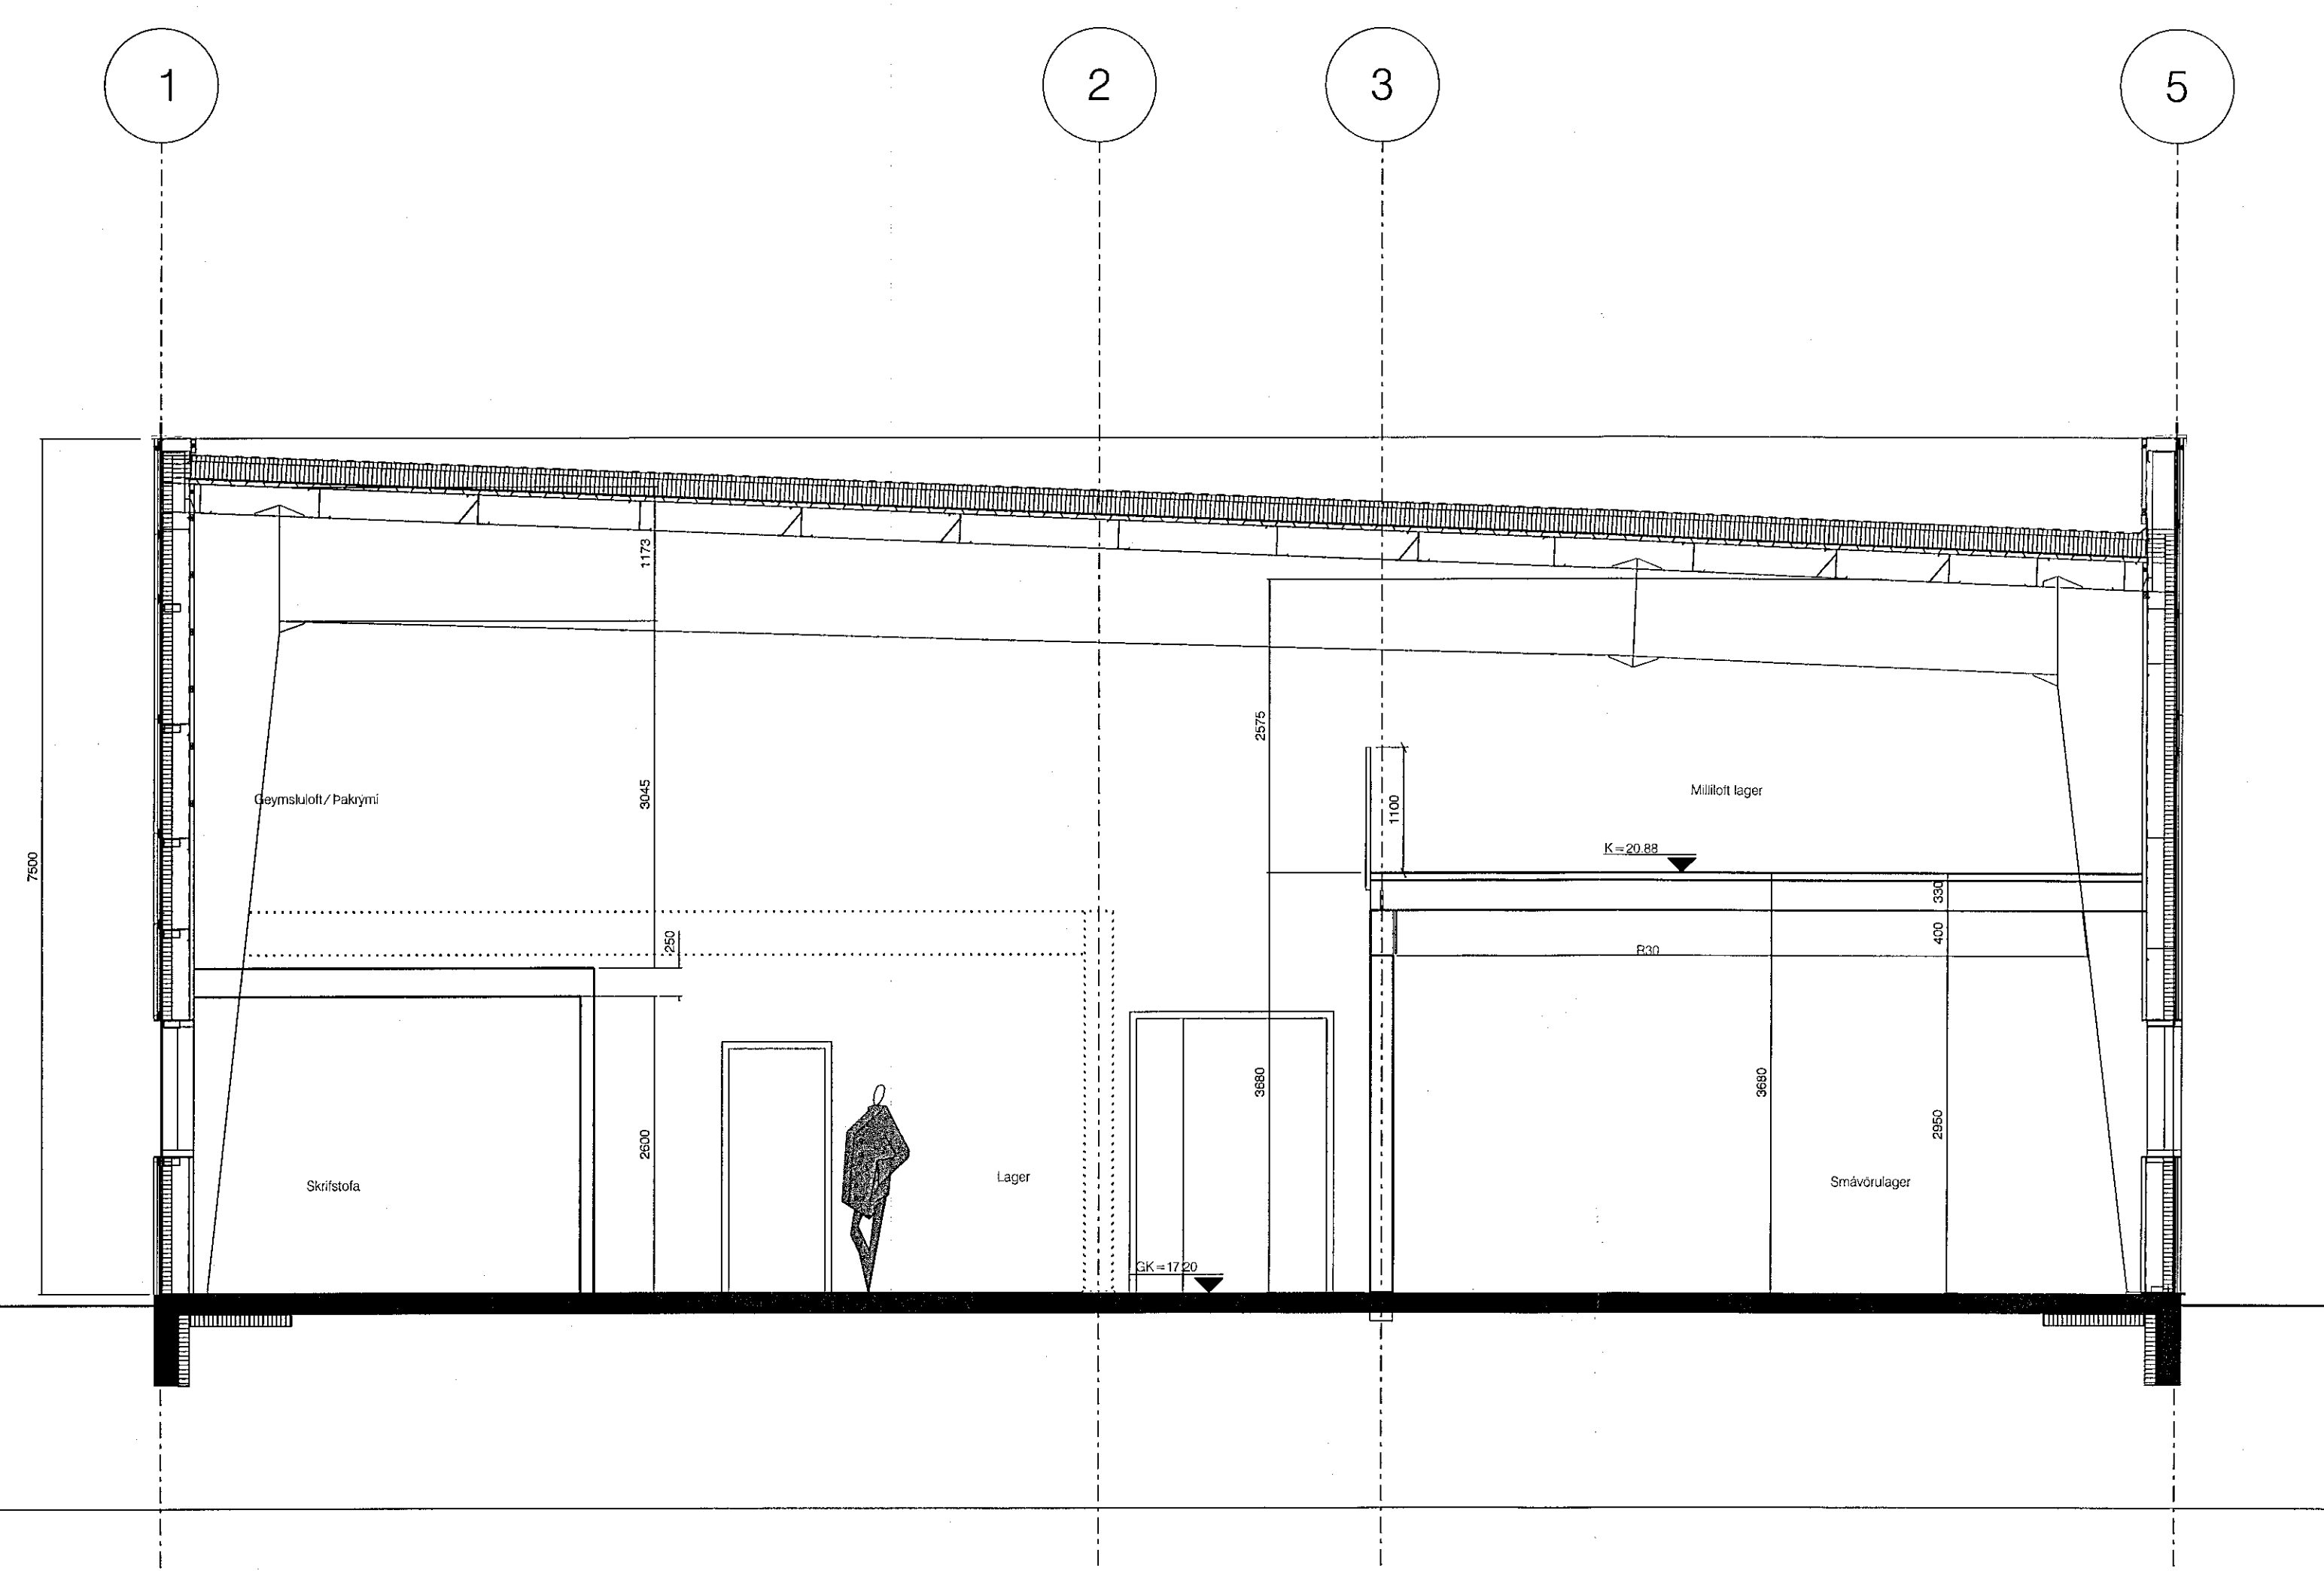

Sneid F-F

A: 09.09.2020  
 Handdrif hækkar.



Verkefni: Selhella 8

Sneid  
 EE og FF

Tekning nr. 50-07A  
 Mál 1:50  
 Dags. 06.11.2019  
 Teknad. ULB

Fiskelöld 31 101 Reykjavík  
 Sími: 5511790 gpark@gpark.is  
 5621790  
 Guðmússon  
 Kt. 291246-4519 Arkitekt FAI

