



Samþykkt þann
 07. okt. 2020
 Sigurður Steinar Jónsson

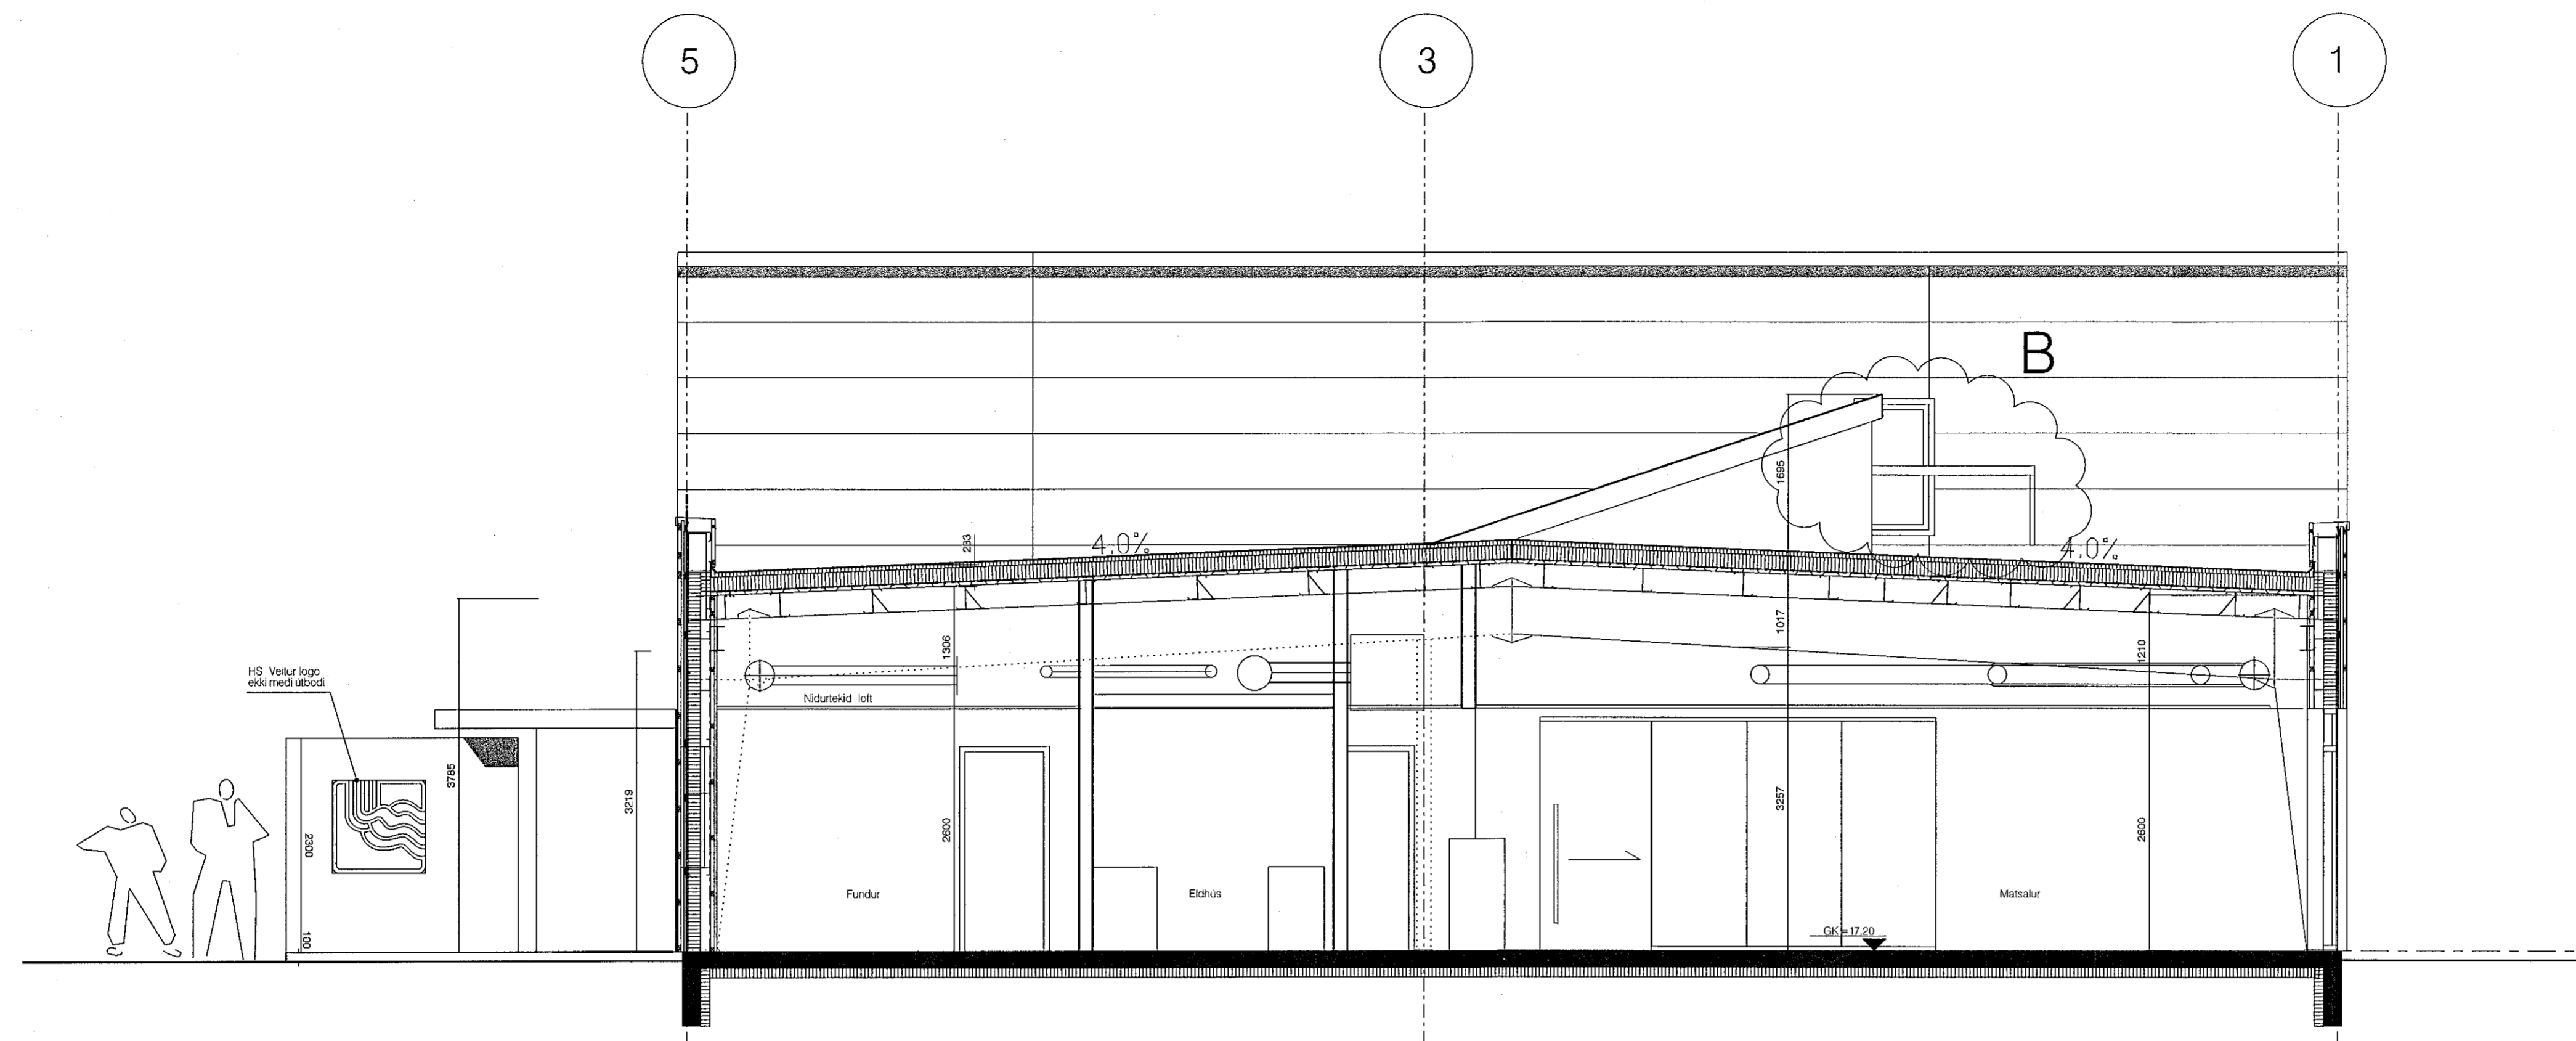

Sneid A-A

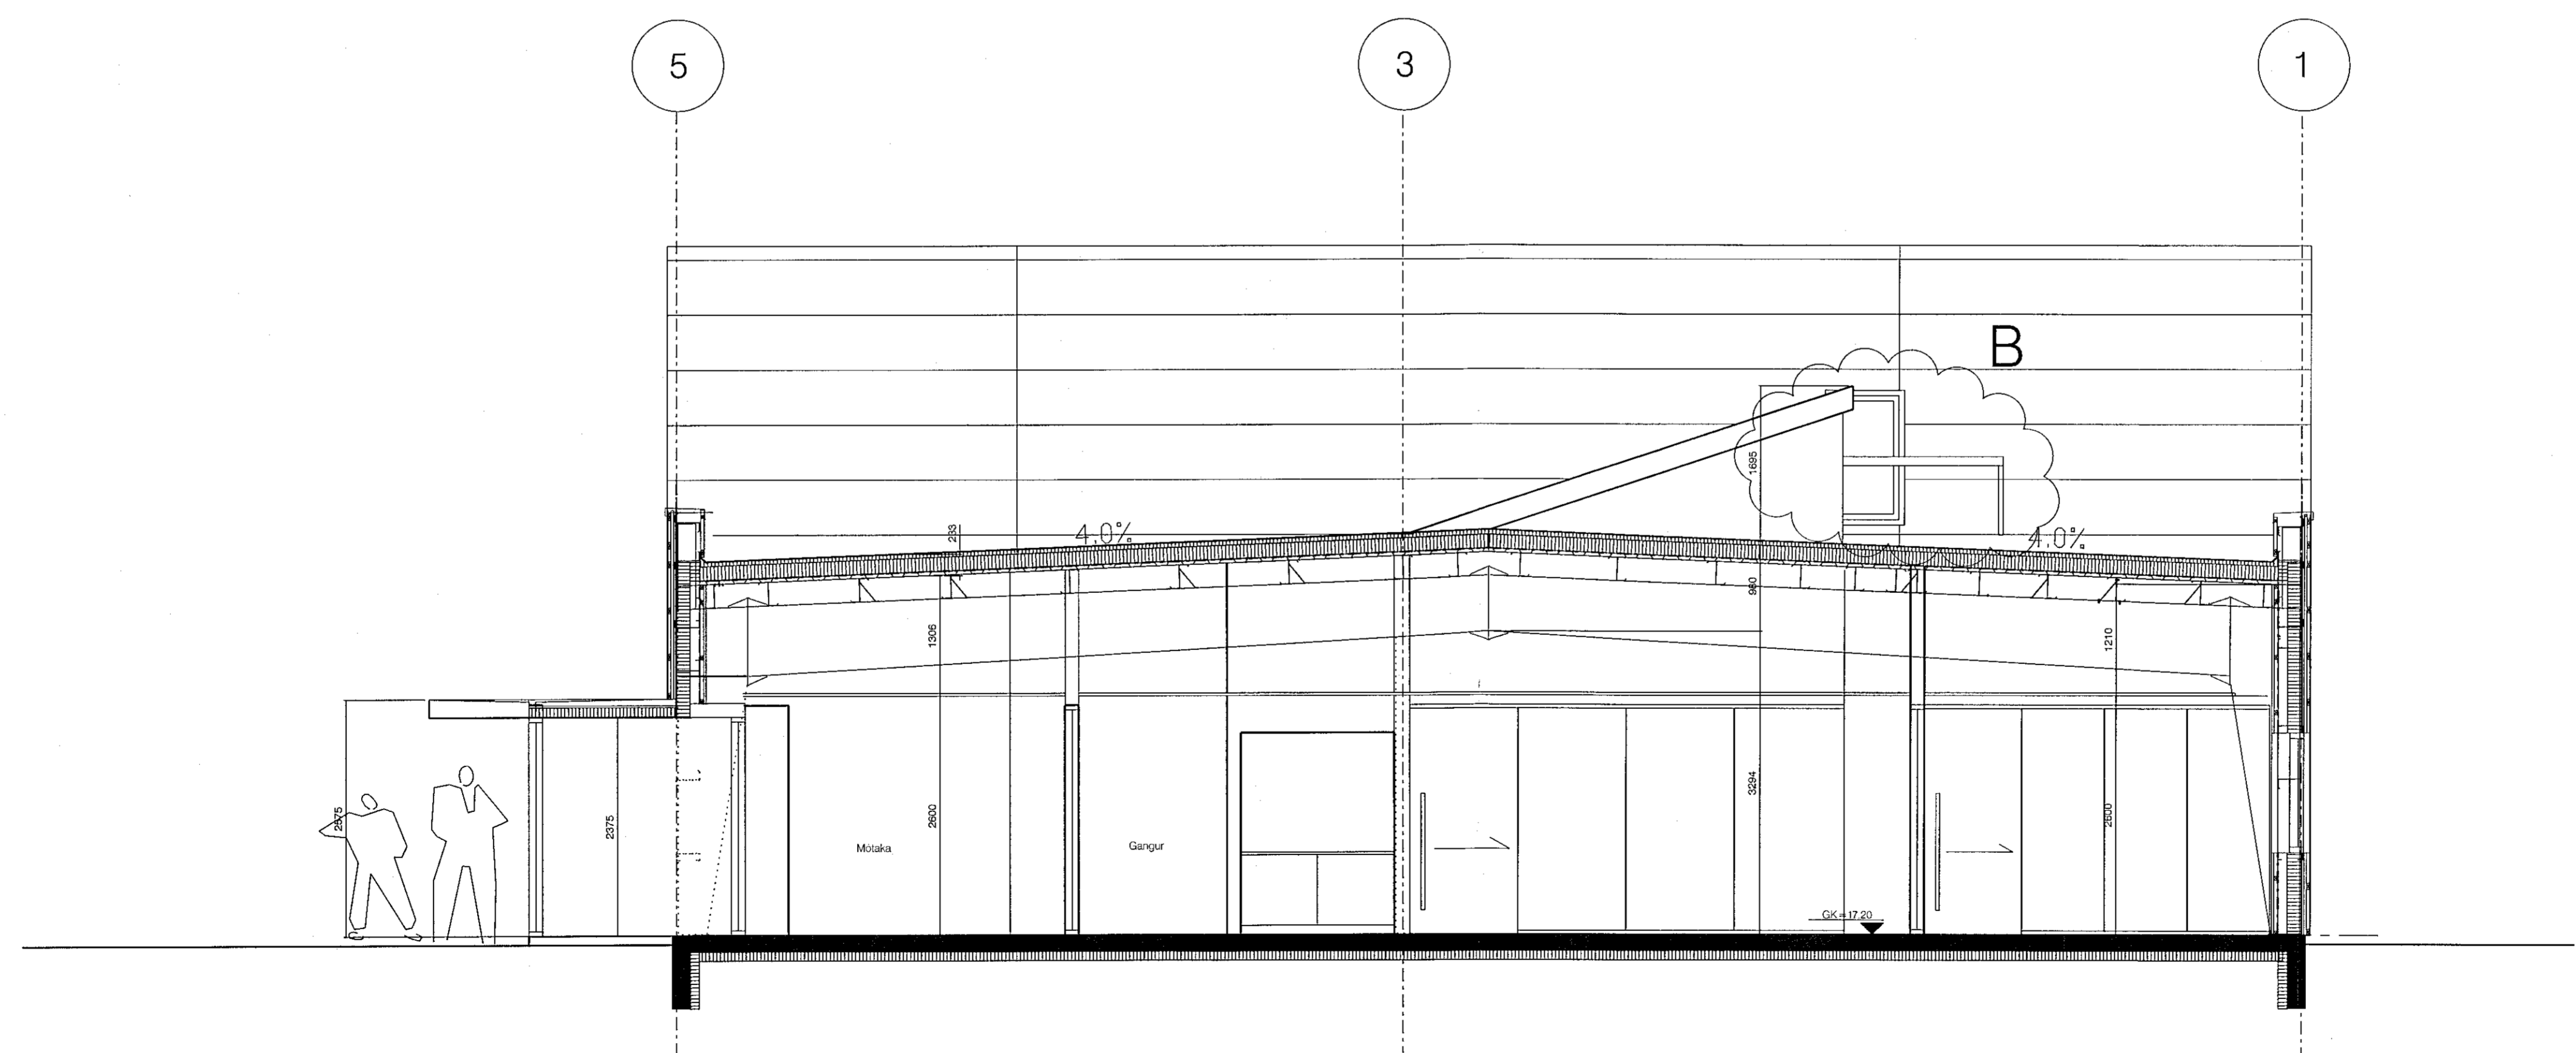

Sneid B-B

B: 09.08.2020
 Flóttaleyð breytt.
 A: 19.03.2020
 Flóttaleyð breytt.



Verkefni: Selhella 8

Sneid
 AA og BB

Teikning nr. 50-05B
 Mál 1:50
 Dags. 06.11.2019
 Teiknad UIB

Fiskiskóli 31 101 Reykjavík
 Sími 6511790 gpark@gpark.is
 6621790
 Góttfríð Pálsson Arkitekt FAL
 Kt. 291246-4519