



Samþykkt þann
07. okt. 2020
F.h. byggingarfulltrúans í Hafnarfirði
Sigurður Steinar Jónsson

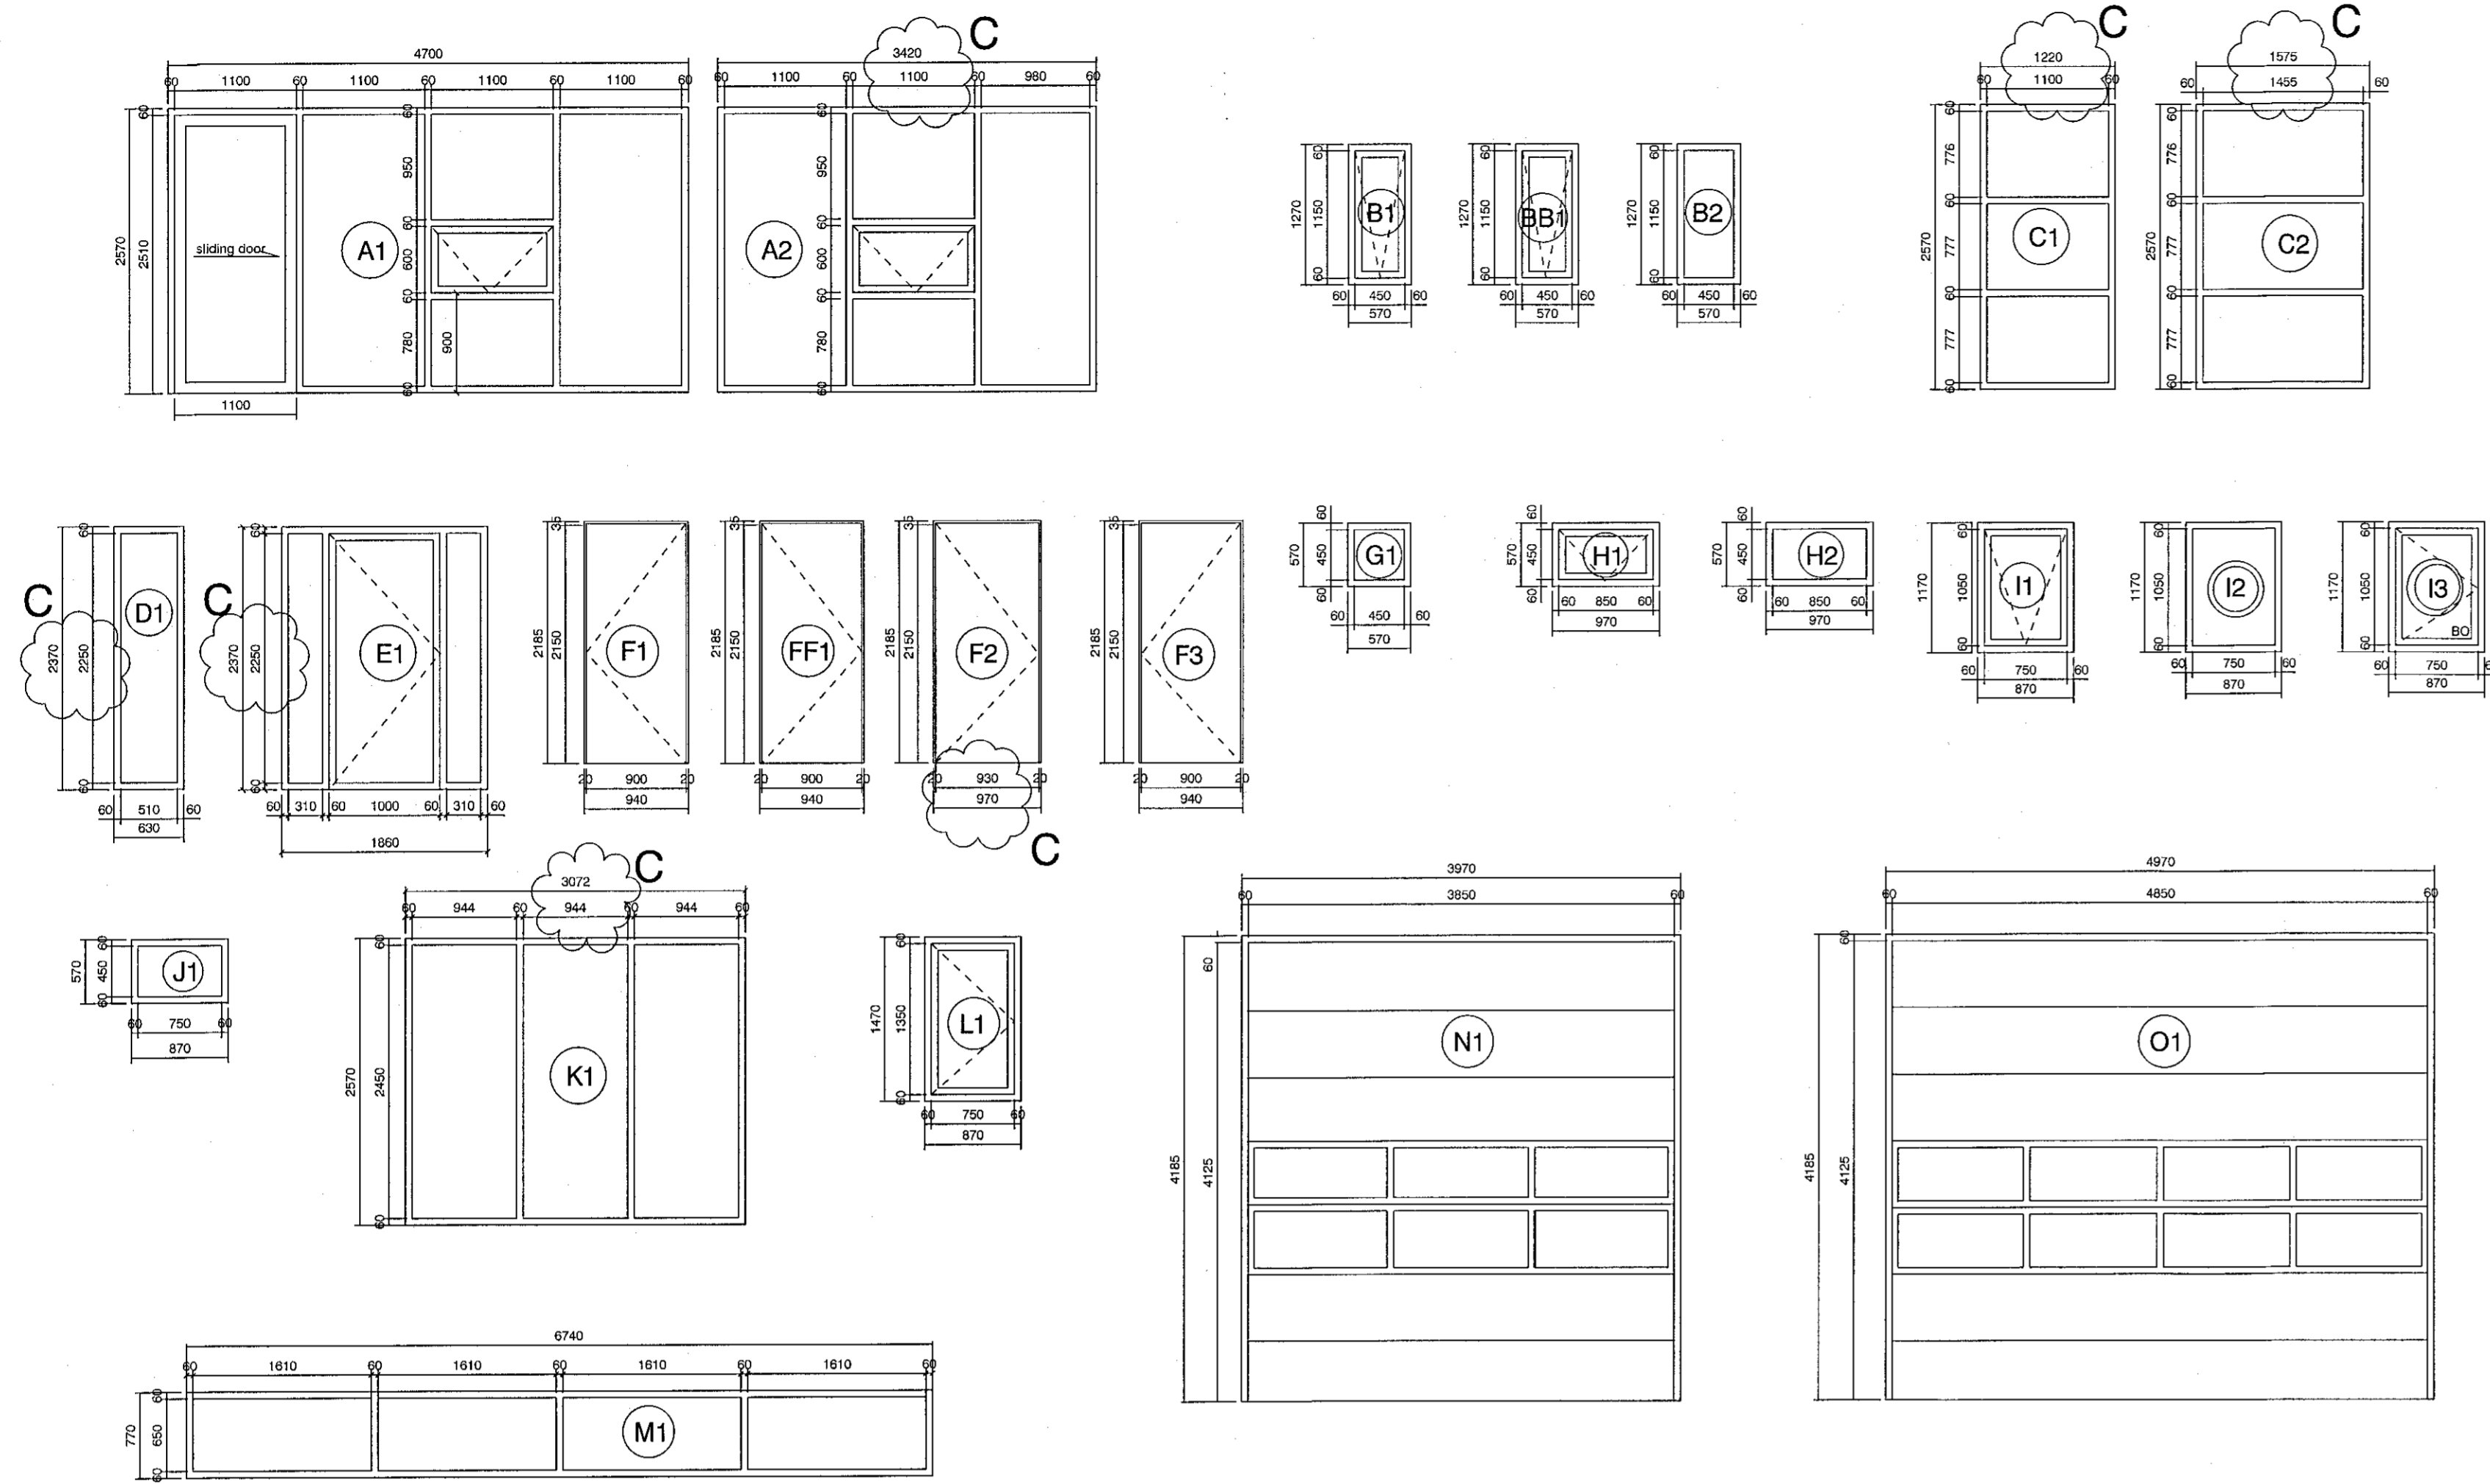

Quantity	E30 glass	Color	Sunstop	Hinges doors	Hinges windows	Opening	Sliding door	Car door	Safety glass	Security system
		White RAL 9010	Black RAL 9011	Left	Right	Left	Right	Above	Out	In
A1	1									
A2	1									
B1	6									
BB1	2									
B2	8									
C1	1									
C2	1									
D1	2									
E1	2									
F1	2									
FF1	2									
F2	1									
F3	1									
G1	6									
H1	4									
H2	1									
I1	7									
I2	7									
I3	1									
J1	11									
K1	1									
L1	1									
M1	1									
N1	2									
O1	1									

Ath. Farid eftir exelskrá vardandi glergerð, hengslun, liti

1:50

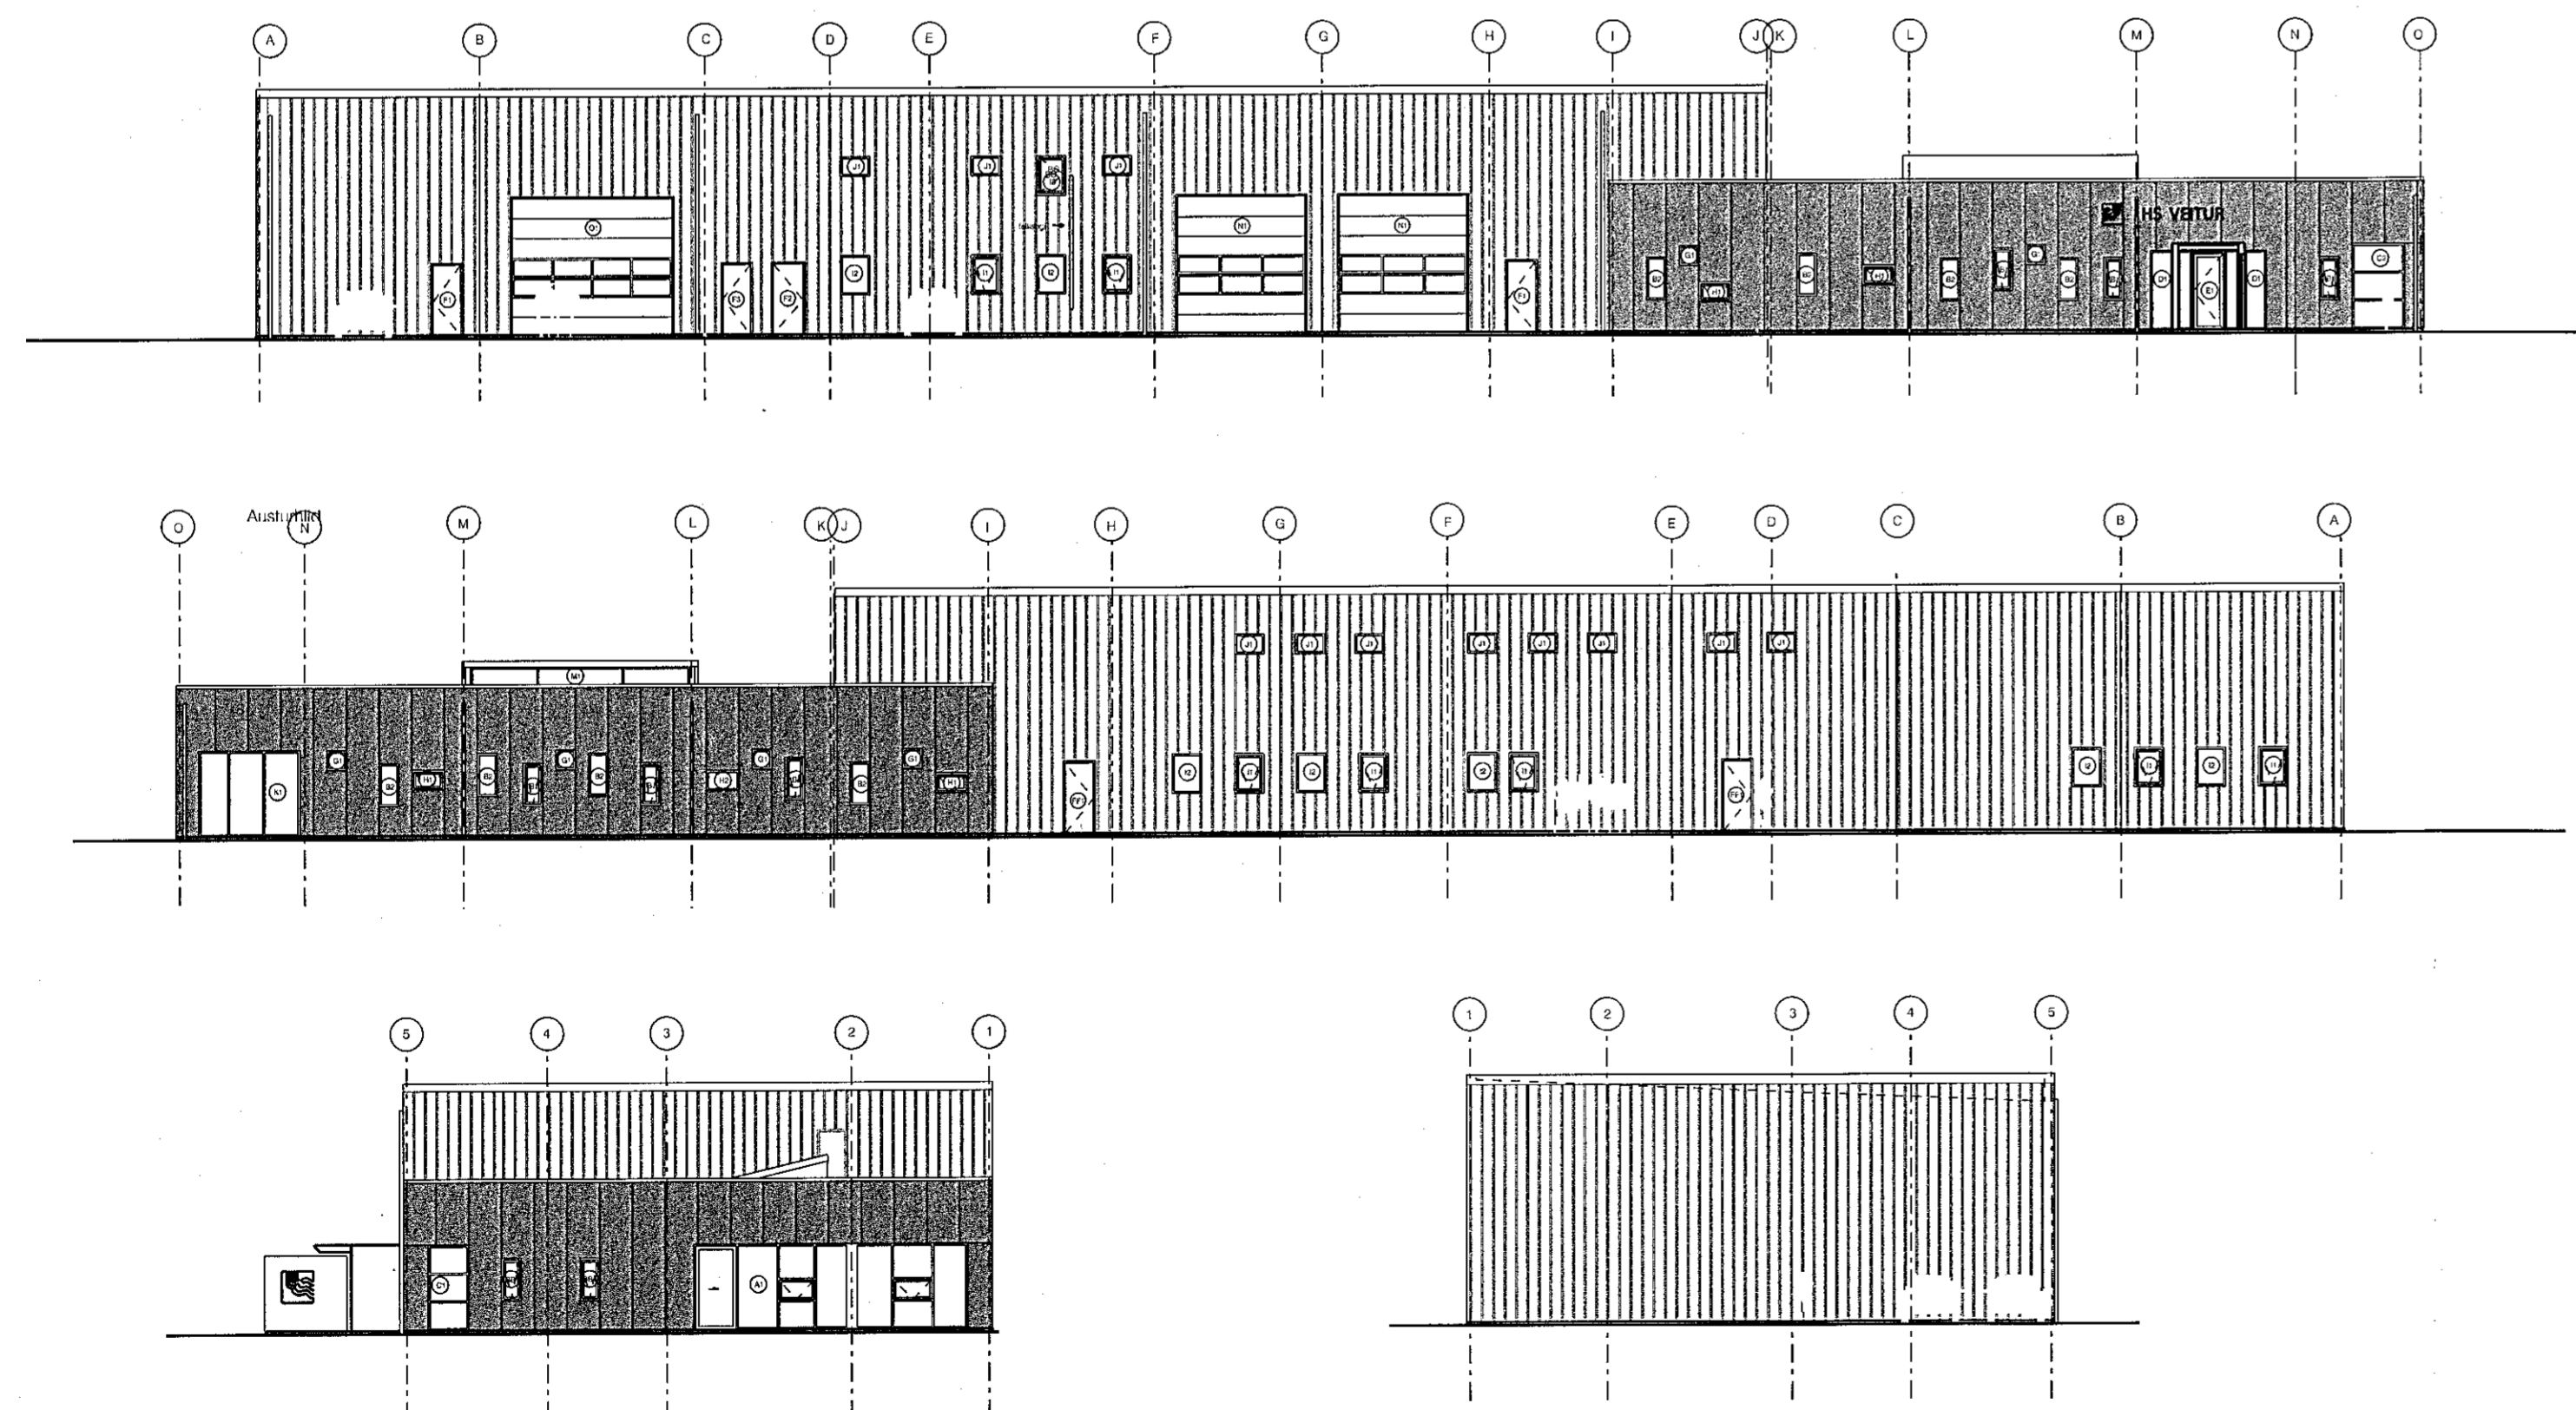

1:200

C: 17.02.2020
A2, K1, C1, C2, D1,
E1 and F2 have
changes sizes.

B: 17.01.2020
New mesurment
on Door E1 and
window C1.
Security system
on door FF1

A: 20.12.2019
New mesurments on
windows and doors.
Window A2 is new.

GP ARKITEKTAR

Verkefni: Selhella 8
HS Veitur
Gluggar og hurdir

Teikning nr. 50-13C
Mál 1:50, 1:200
Dags. 06.11.2019
Teiknad GP

Fiskilöð 31 101 Reykjavík
Sími: 5511790 gpark@gpark.is
5621793
Guðrún Pálsson
Kt. 291246-4519 Arkitekt FAI