



Samþykkt þann

16. nóv. 2020

F.h. byggingarfulltrúans í Hafnarfórði
Sigurður Steinar Jónsson

Dags:	Nr.:	Breytingar:	Samþ.
20.02.2020	A	Lagnir færðar til vegna loftupphengja og eldhútsúg og fært.	

01
612

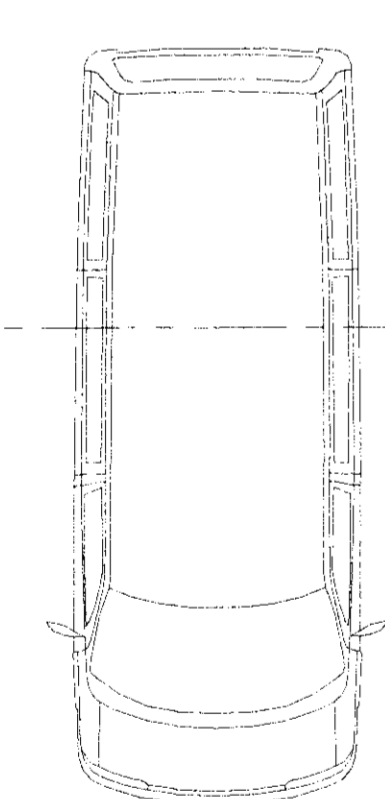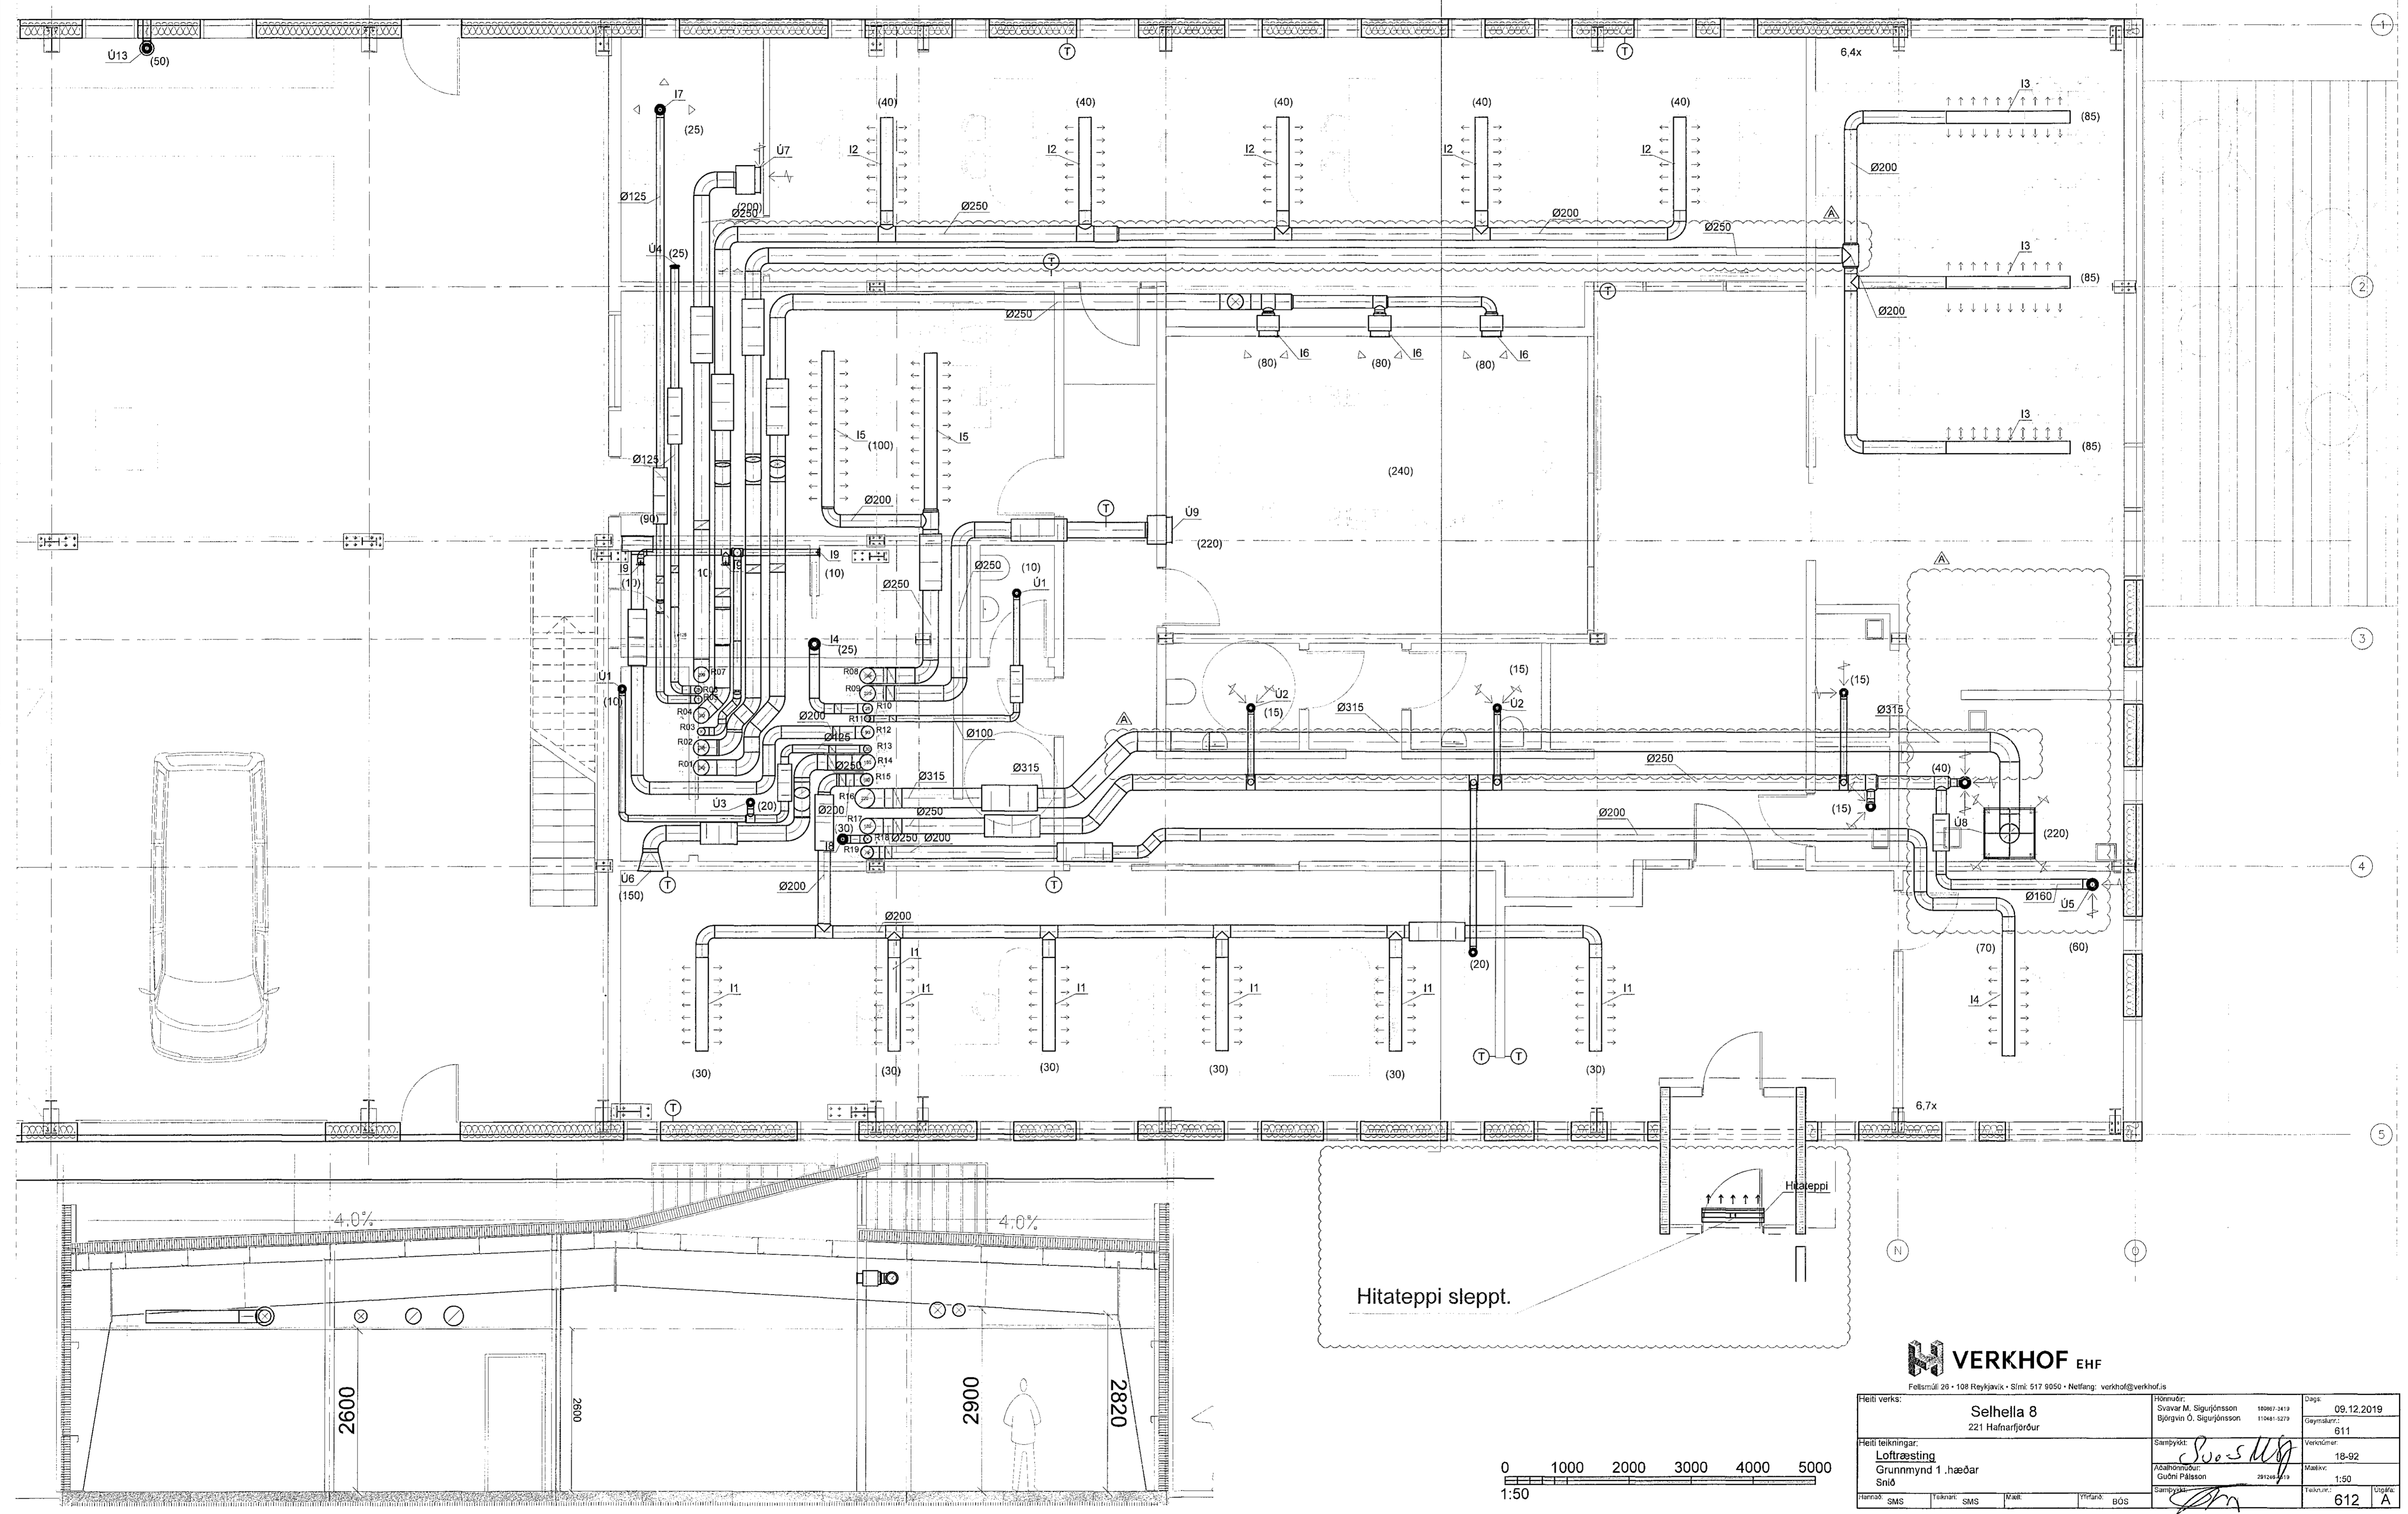

Hitateppi sleppt.

VERKHOF EHF

Felssmíði 26 • 108 Reykjavík • Sími: 517 9050 • Netfang: verkhof@verkhof.is

Hefli verks:	Selhella 8 221 Hafnarfjörður	Höfundur: Sigríður M. Sigrúnsson Björgvin Ó. Sigrúnsson	Dags: 09.12.2019
Hefli teikningar:	Loftræsting Grunnmynd 1. hæðar Snið	Samþykkt: Guðni Pálsson	Öppunardagur: 18-02
Skala:	1:50	Utgáfa:	612 A

