
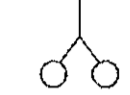


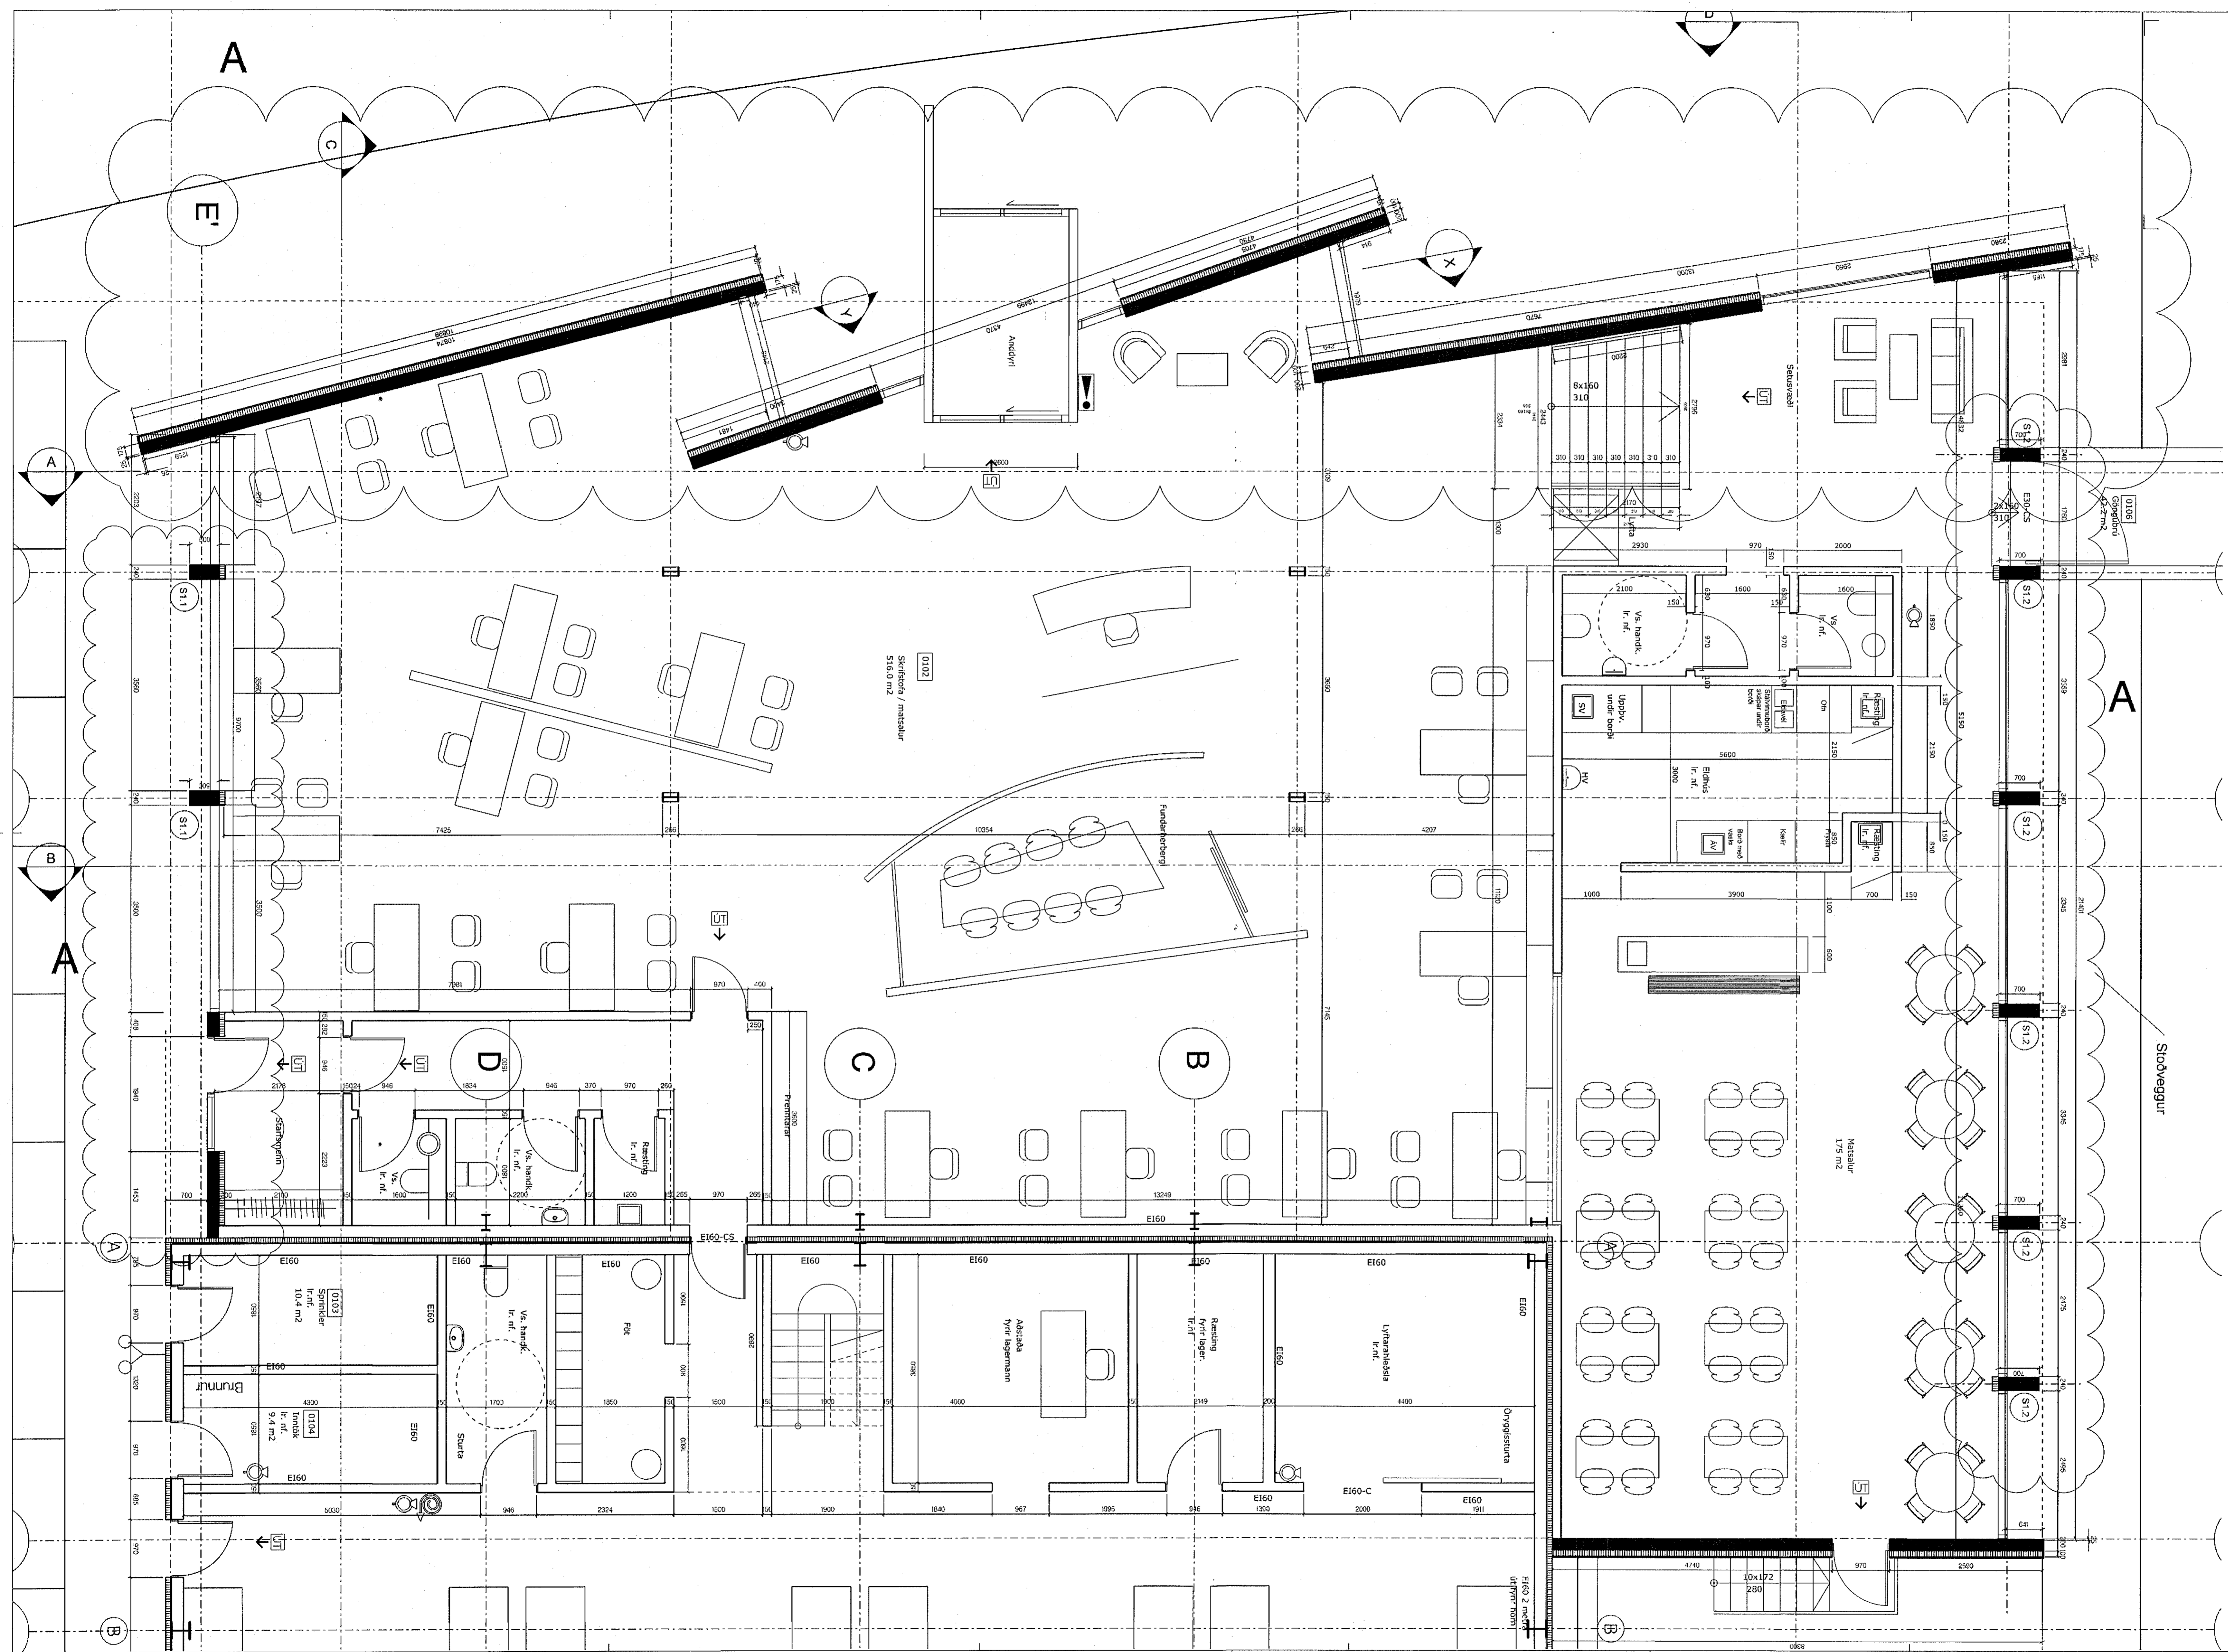


-  Brúslanga
-  Tvíburatengi Slökkvélis
-  Stjórnstöð Brúnaþvöðunarkerfis
-  Handslökkvélir



A:02.05.21 Allar súkur á suður og norðurlind breytast. Einnig breytast veggir til vesturs

GP ARCHITECTAR
Verkefni: Selhella 7
Grunnmynd

Tekning nr. 50-01A
Mál 1:50
Dags. 30.07.2018
Teiknad GP

Flekkstöð 31
Sími: 5511790
gpark@gpark.is
Sjur/Pálsson
Kt. 291246-4519

101 Reykjavík
gpark@gpark.is
Arkitekti FAI