Samþykkt þann
30 SEPT. 2003
Byggingafulltrúinn í Hafnarfirði
F.h. Hulda G. Pétursdóttir

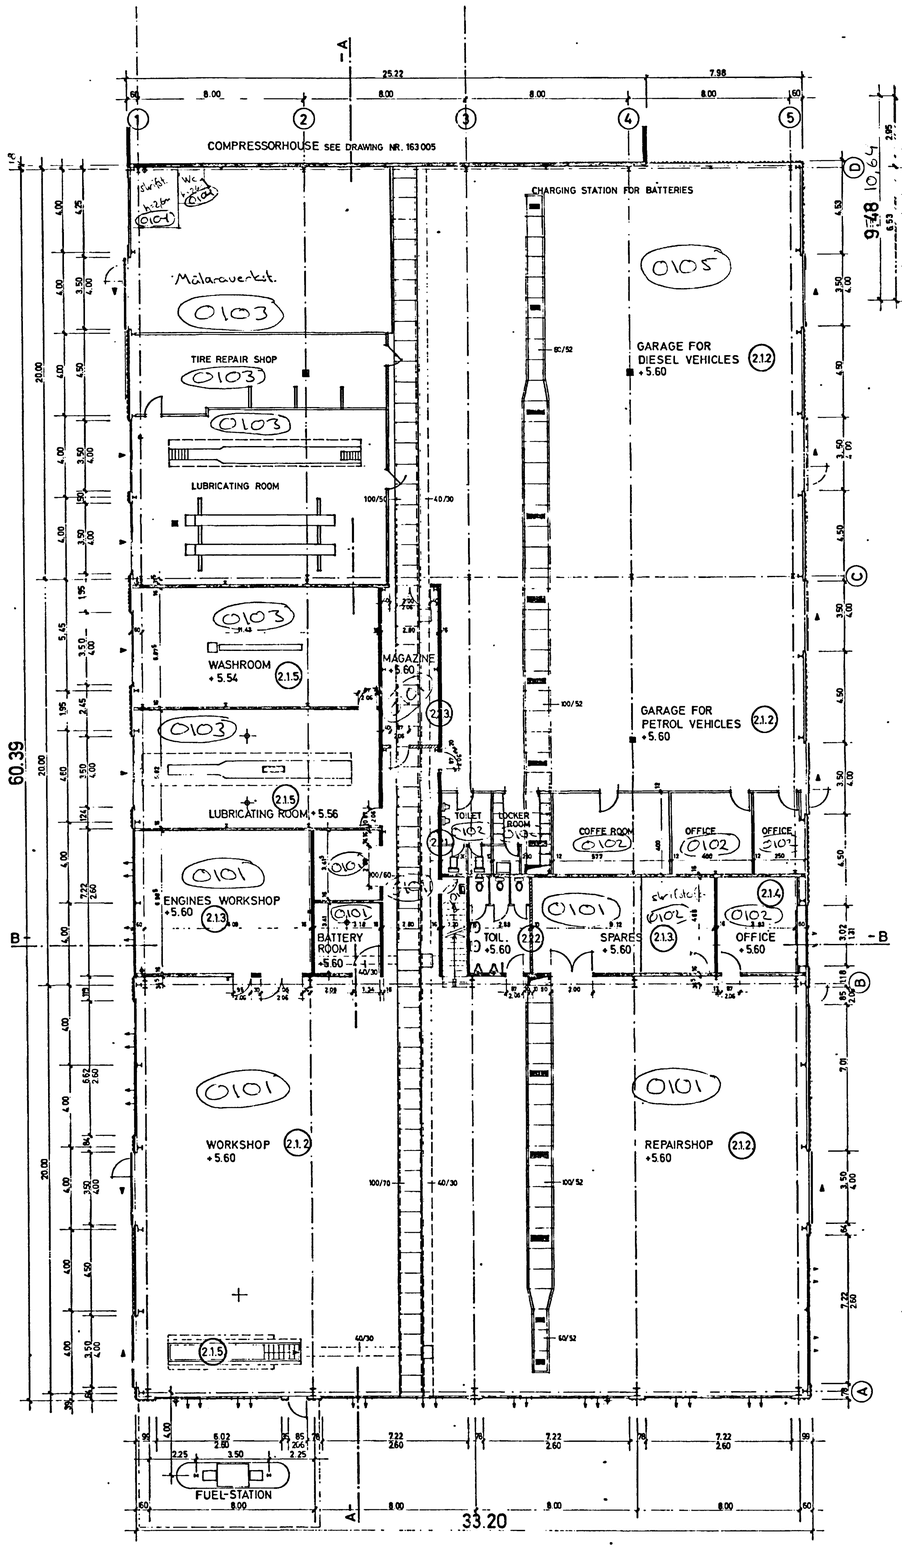


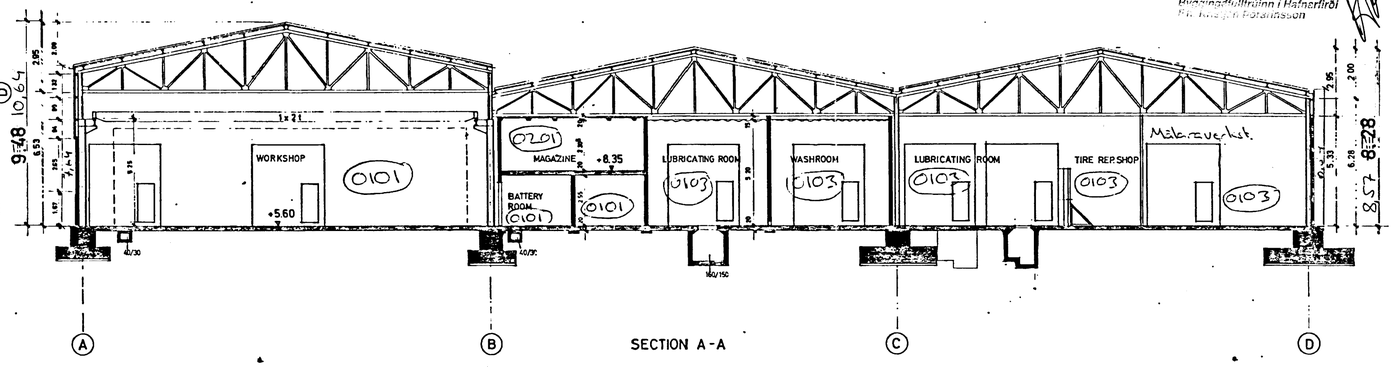


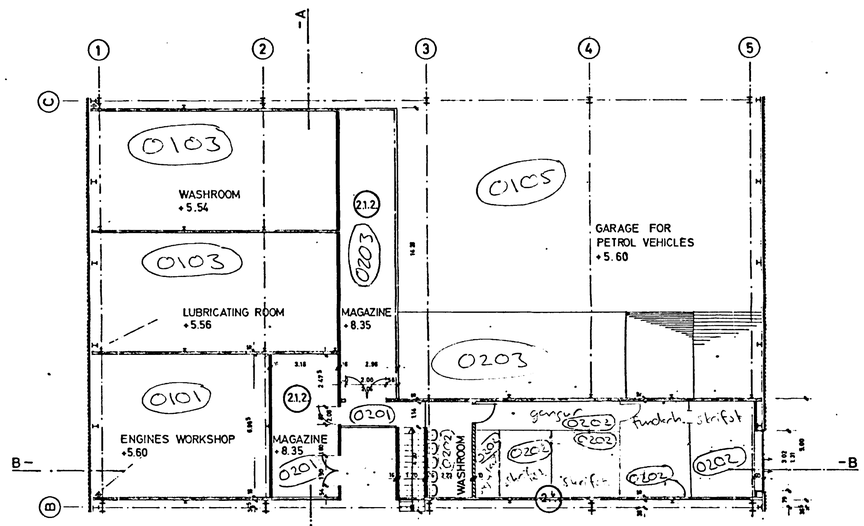


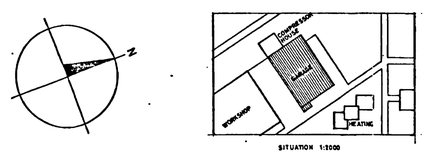


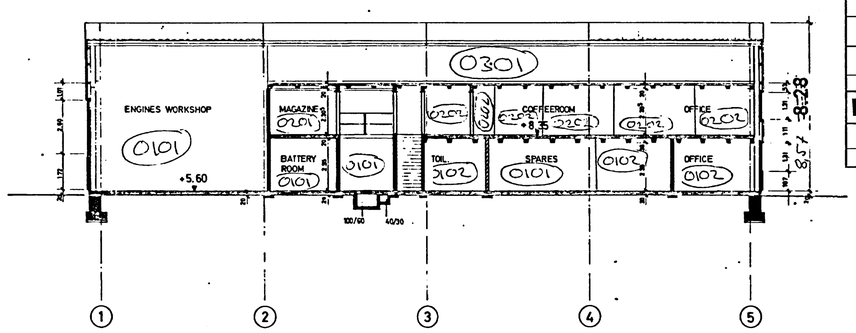


## 2. LEGEND

INTERNAL STRUCTURE

2.1 FLOORS

2.1.1 Concrete

Carpet B 150 under foundations pits and ducts 50 mm. Concrete B 350 for footings, piers, pits, grade floor and stairs. Elements B 450 (inside building).

2.1.2 Concrete floors, unpainted

Machine trowelled finish on concrete floors; workshop, repair shop, garage for vehicles and magazines (balcony).

2.1.3 Concrete floors, painted

Machine trowelled finish on concrete floors; spares and engines workshop.

2.1.4 Floor in offices and coffeeroom

Machine trowelled concrete floors. Floor covering, vinyl asbestos tiles. Size 250x250 mm thickness 1,5 mm colour green A 223. Manufacturer "TARKETT", Sweden. Baseboard; black 2 1/2". Manufacturer "KENCOVE", U.S.A.

2.1.5 Ceramic floors

Ceramic floors in repair pit, toilet, battery room, lubricating room and washrooms. Tiles in mortar bed 30 mm, ceramic floor tiles, size 150x150x15. Colour brown grey and yellow. Manufacturer "HÖGANÄS", Sweden and "H.R. GIBBS & SON LTD.".

2.2 WALLS (INSIDE BUILDING)

2.2.1 Concrete walls; Treatment smooth surface.

2.2.2 Lava block walls; Size of lava blocks 70x500x500. Grouting on both sides.

2.2.3 Prefabricated elements.

Thickness 150 mm, height and length variable. Tightening between elements with mortar.

2.2.4 Ceramic walls.

Glazed ceramic wall tiles size 150x150x5 mm. Colour: yellow and white. Manufacturer: "Villery & Bock" West-Germany.
Tile laying on prefab. walls in mortar bed with "latikrit" solution. Light partition walls: dip., 175x120 cm. 20 mm plastic coated Novopan sheets. Colour: white.

2.3 ROOF (INSIDE BUILDING)

Prefabricated channel slab elements. Tightening between elements with mortar.

2.3.1 Suspended ceiling

In washroom (groundfloor) and lubricating room, suspended ceiling, steel construction covered with Aluman verticlad 92/101.

2.4 WINDOWS (INSIDE BUILDING)

Windows of pine wood 2 1/2"x5". Glass single, quality "B" 4 mm. Tightening of windows in walls by "Airofill" fillers and wooden covering list on both sides.

2.5 DOORS

2.5.1 Steel doors

Made by "Hellbergs Industrier" AB, Sweden. Construction according to Sweden standard of fire doors lock-bodies, handles and cylinders made by "ASSA", Sweden.

**Alcan á Íslandi hf.**

**Skráning matshluta bygginga í Straumsvík**

| VINNUVÉLAVERKSTÆÐI | | 123154 | 20 |
|---|---|---|---|
| Heiti byggingar | Fastanúmer | Landnúmer | Matshlutanúmer |

VST Verkfræðistofa Sigurðar Thoroddsen hf. kt. 611276-0289

Niels Indriðason kt. 181144-3949 — 2003-09-15 (Dagsetning)

| REV. Nr. | DATUM | REVISION | GEZ. | GEPR. | GEN. |
|---|---|---|---|---|---|
| 2. | 18.2.94 | UP TO DATE | GuR | | |
| 1. | 21.9'84 | UP TO DATE | RV | | |

ICELANDIC ALUMINIUM COMPANY LTD.

ARCHITECTURAL DRAWING
GARAGE
PLAN, SECTIONS

Maßstab 1:100 — Entwurf — Gezeichnet 30.5.69 bu — 13.8.69 fmc — Bearbeit. — Genehmigt — Format

AS BUILT DRAWING

Projektierung: Schweizerische Aluminium AG ZÜRICH

No. 163 003 7110-BA1233