



RP

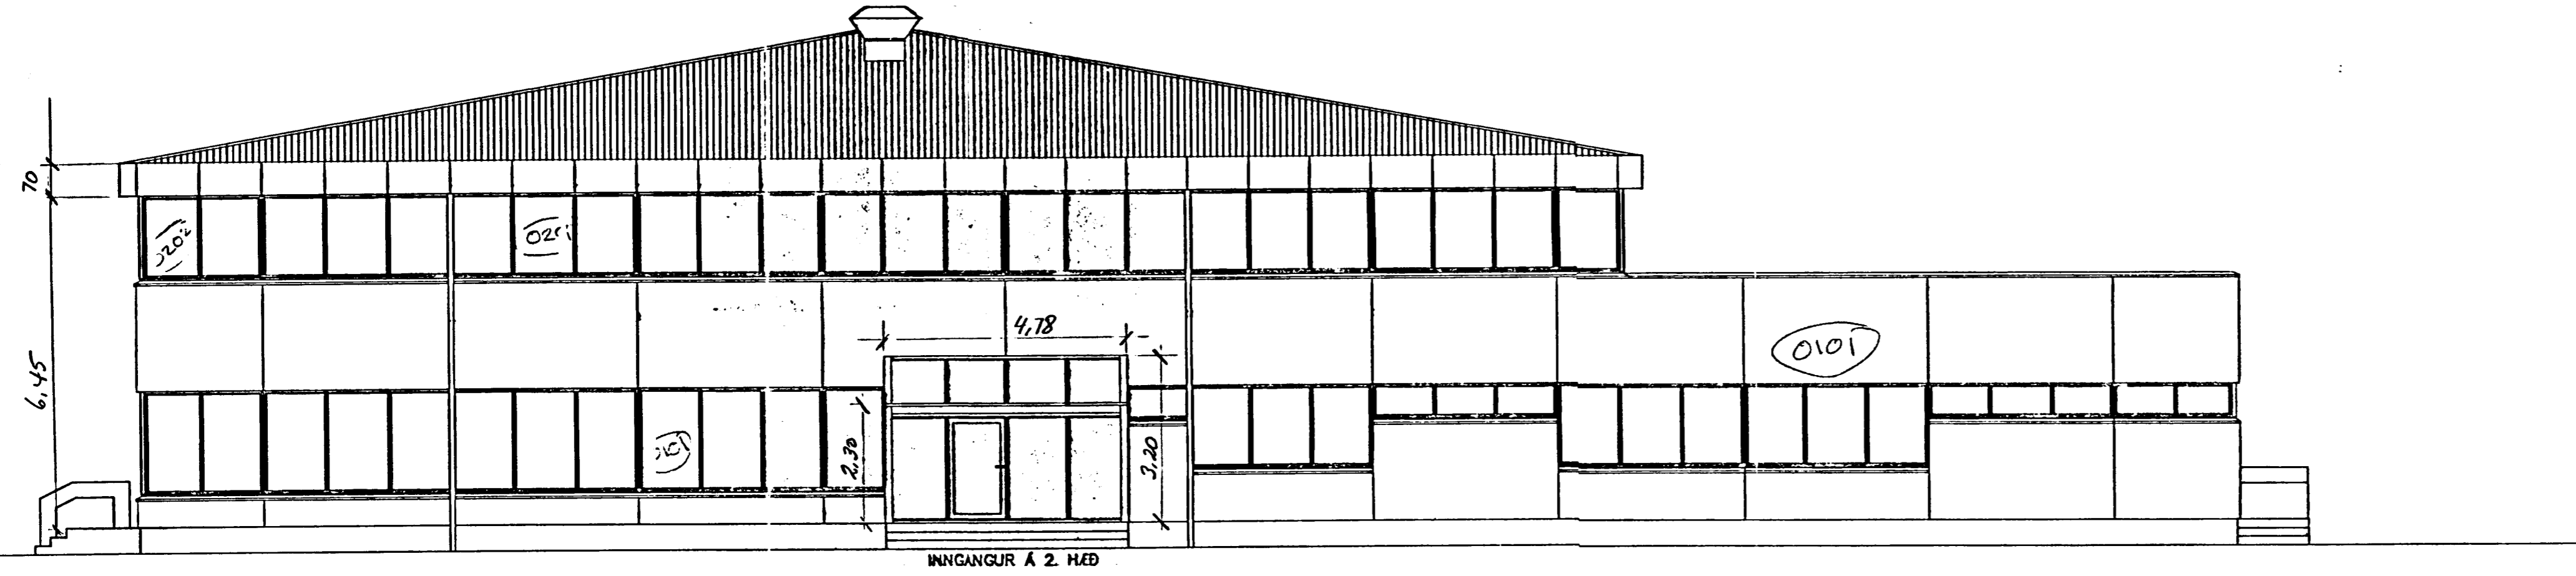

SUÐ-VESTUR

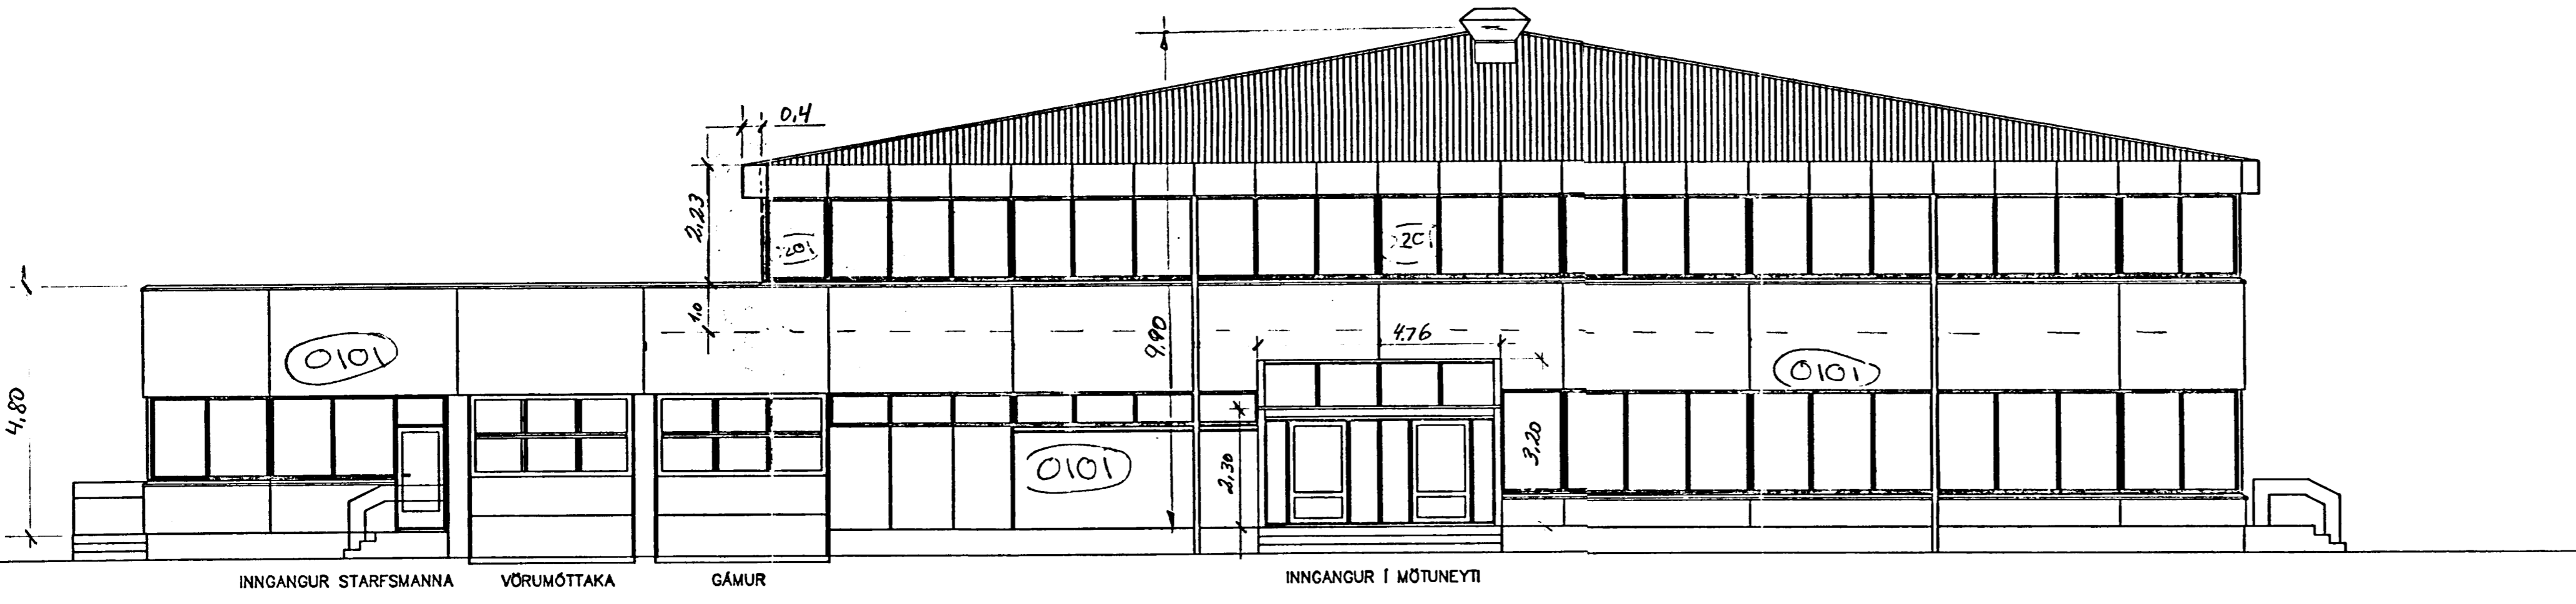

NORÐ-AUSTUR

Alcan á Íslandi hf.			
Skráning matshluta bygginga í Straumsvík			
MÖTUNEYTI	123154	96	
<small>Heiti byggingar</small>	<small>Fastanúmer</small>	<small>Landnúmer</small>	<small>Matshlutanúmer</small>
VST Verkræðistofa Sigurðar Thoroddsen hf. kt. 611276-0289			
Niels Indriðsson kt. 18144-3949		2003-09-19	
<small>Niels Indriðsson kt. 18144-3949</small>		<small>Dagsetning</small>	

[SAL - MÖTUNEYTI]
 184804 4130BA2360
 ÚTLITSMYNDIR :

SH 1:100
 pG JÚL '92
 A-