




Samþykkt bann

30 SEPT. 2003

Byggingafulltrúinn / Hafnarfirði  
F.h. Kristján Þórarinnsson

4,2 x (málaf. salur rými 0103)

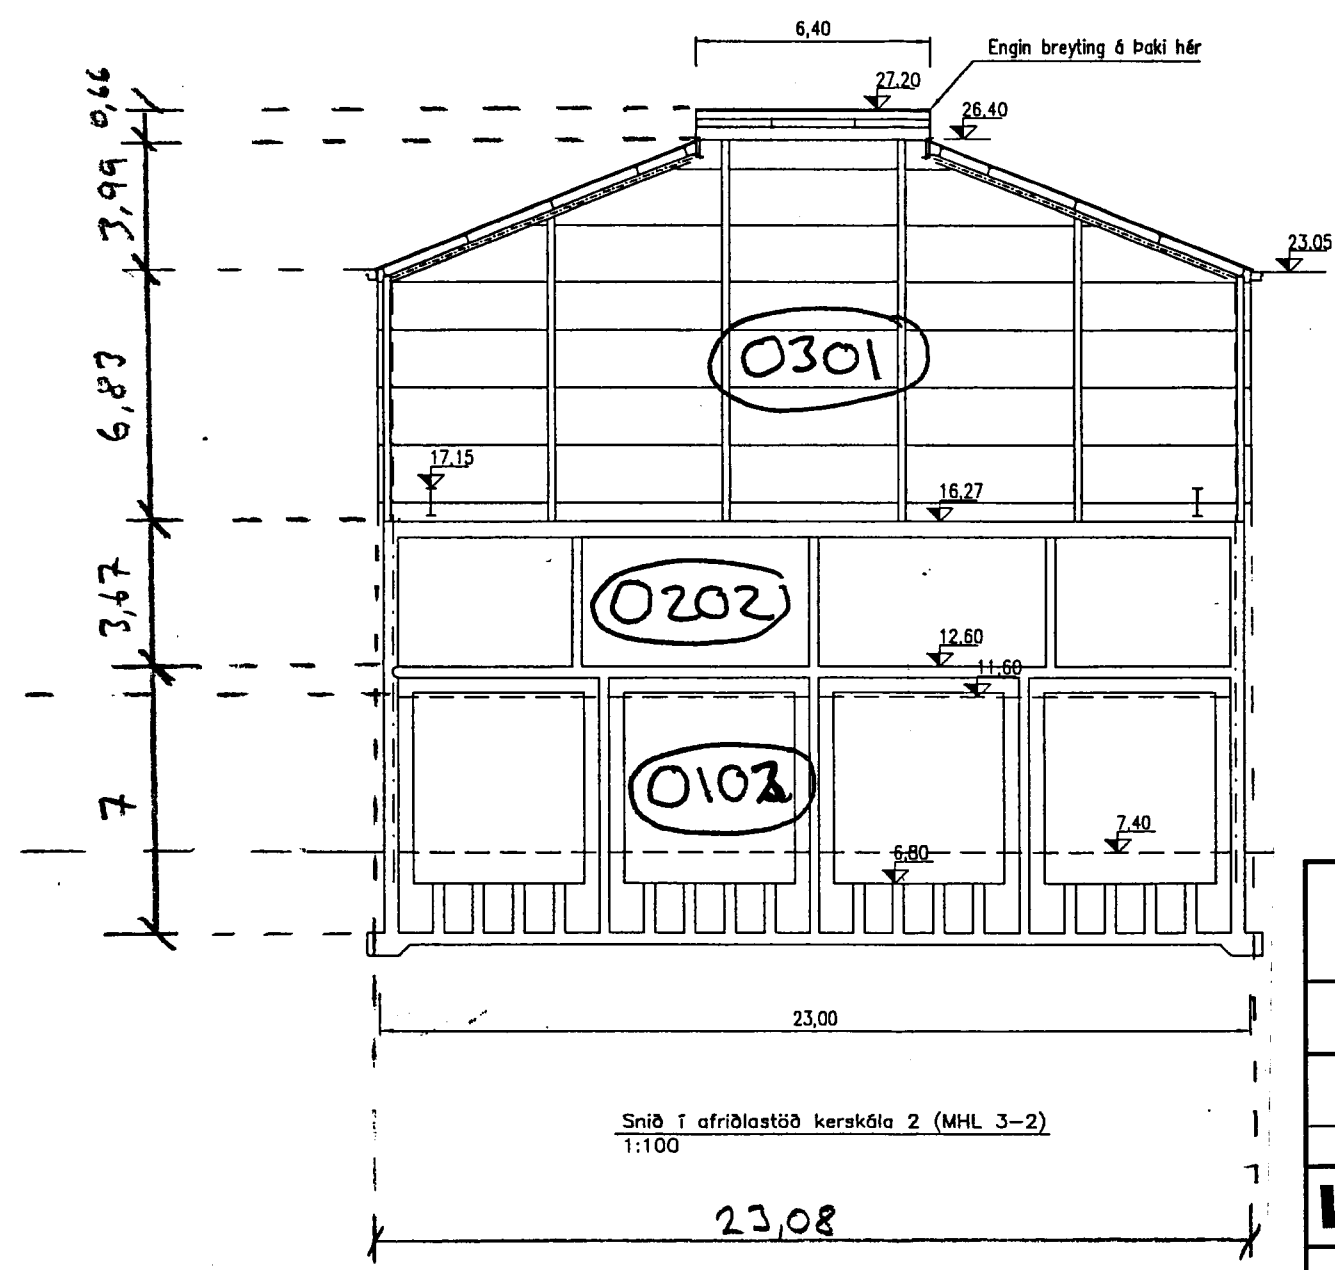

<b>Alcan á Íslandi hf.</b>			
<b>Skráning matshluta bygginga í Straumsvík</b>			
<b>KERSKÁLI 2</b>	<b>123154</b>	<b>40</b>	
<i>Heiti byggingar</i>	<i>Fastanúmer</i>	<i>Landnúmer</i>	<i>Matshlutanúmer</i>
<b>VST Verkfræðistofa Sigurðar Thoroddsen hf. kt. 611276-0289</b>			
<i>Niels Indriðason b1</i>		<b>2003-09-22</b>	
<i>Niels Indriðason kt. 181144-3949</i>		<i>Dagsetning</i>	

Skýringar:  
 Alverð í Straumsvík  
 Landnúmer 123154  
 Þjódskrárnúmer 9998-6500  
 Kerakóll 2; matshluti 3-2  
 Byggingarár 1972 og '79  
 Sterð kerakóla 2; 363.480m<sup>3</sup>



This drawing is the property of the ICELANDIC ALUMINUM CO. LTD. and handed out for personal use only. It may neither be copied nor made available to others without permission of the ICELANDIC ALUMINUM CO. LTD. The receiver is liable for any misuse.		Fjarhitun hf. 164654-0	1:100 A1 Esq.
Byggl. No. ISAL Ref. drawing no. of ISAL	Breyting No. Revision	Date Date	Drawn by Checked by Approved by
Sannaín. Lóðnúmer nr. ISAL Assembly drawing no. of ISAL	Date Date	Drawn by Checked by Approved by	164.654 0