


RÜMMYND HITALAGNA 1:250

SKÝRINGAR  
SJA BL NR. 12

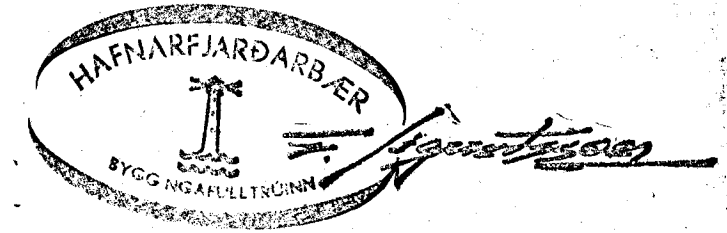

BREYTT JAN 80 SP

SEVANGUR 16 HAFNARFIRÐI  
RÜMMYND HITALAGNA

MKV. 1:250

SIGURÐUR ÞORLEIFSSON TEKNIPR. F.T.F.  
HRAUNBRUN 17 HAFNARFIRÐI SÍMI 52452

DAGS. 79.09.01
REIKN SP
TEIKN SP
VERK. NR
78-02
BLAÐ NR
15