
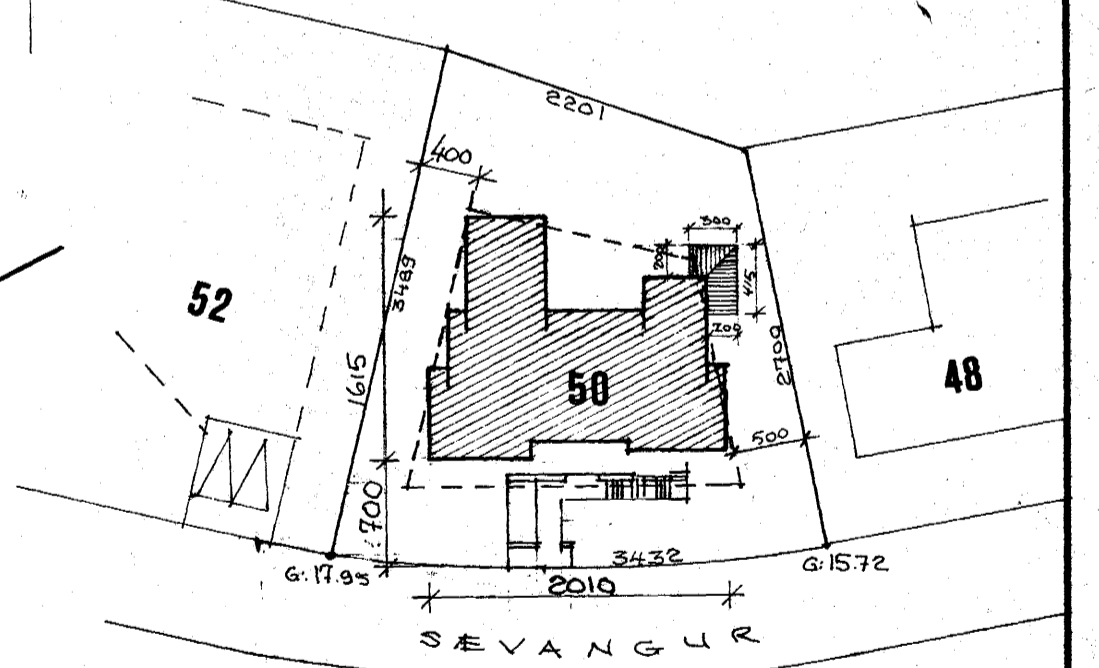
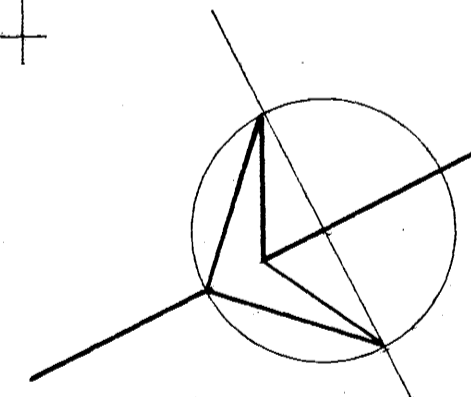
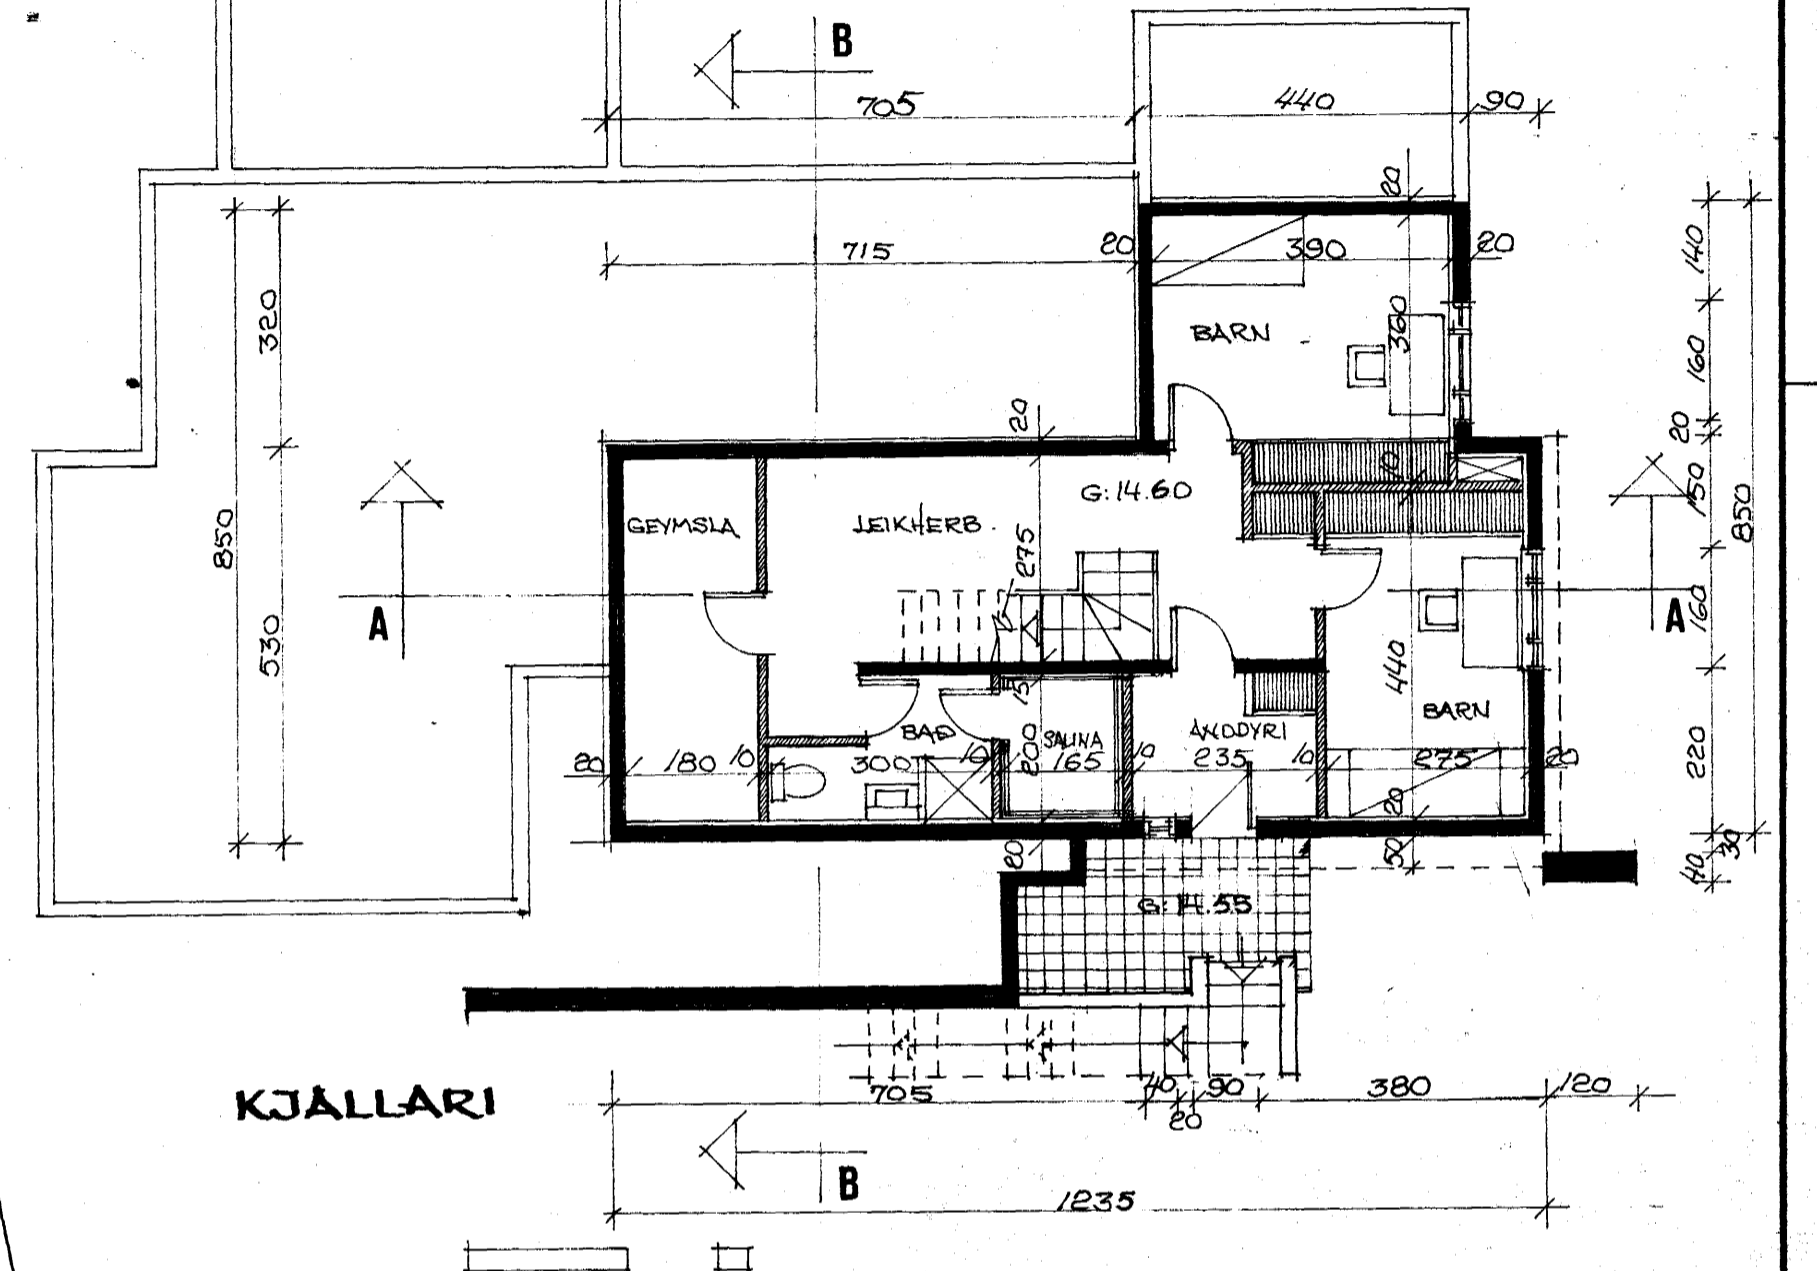


Sampykkt 5 fundi byggingarnefndar þ. 15. 1. 5. 1991  
 BYGGINGAFULLTRÚINN  
 Í HAFNARFIRDI

*[Signature]*

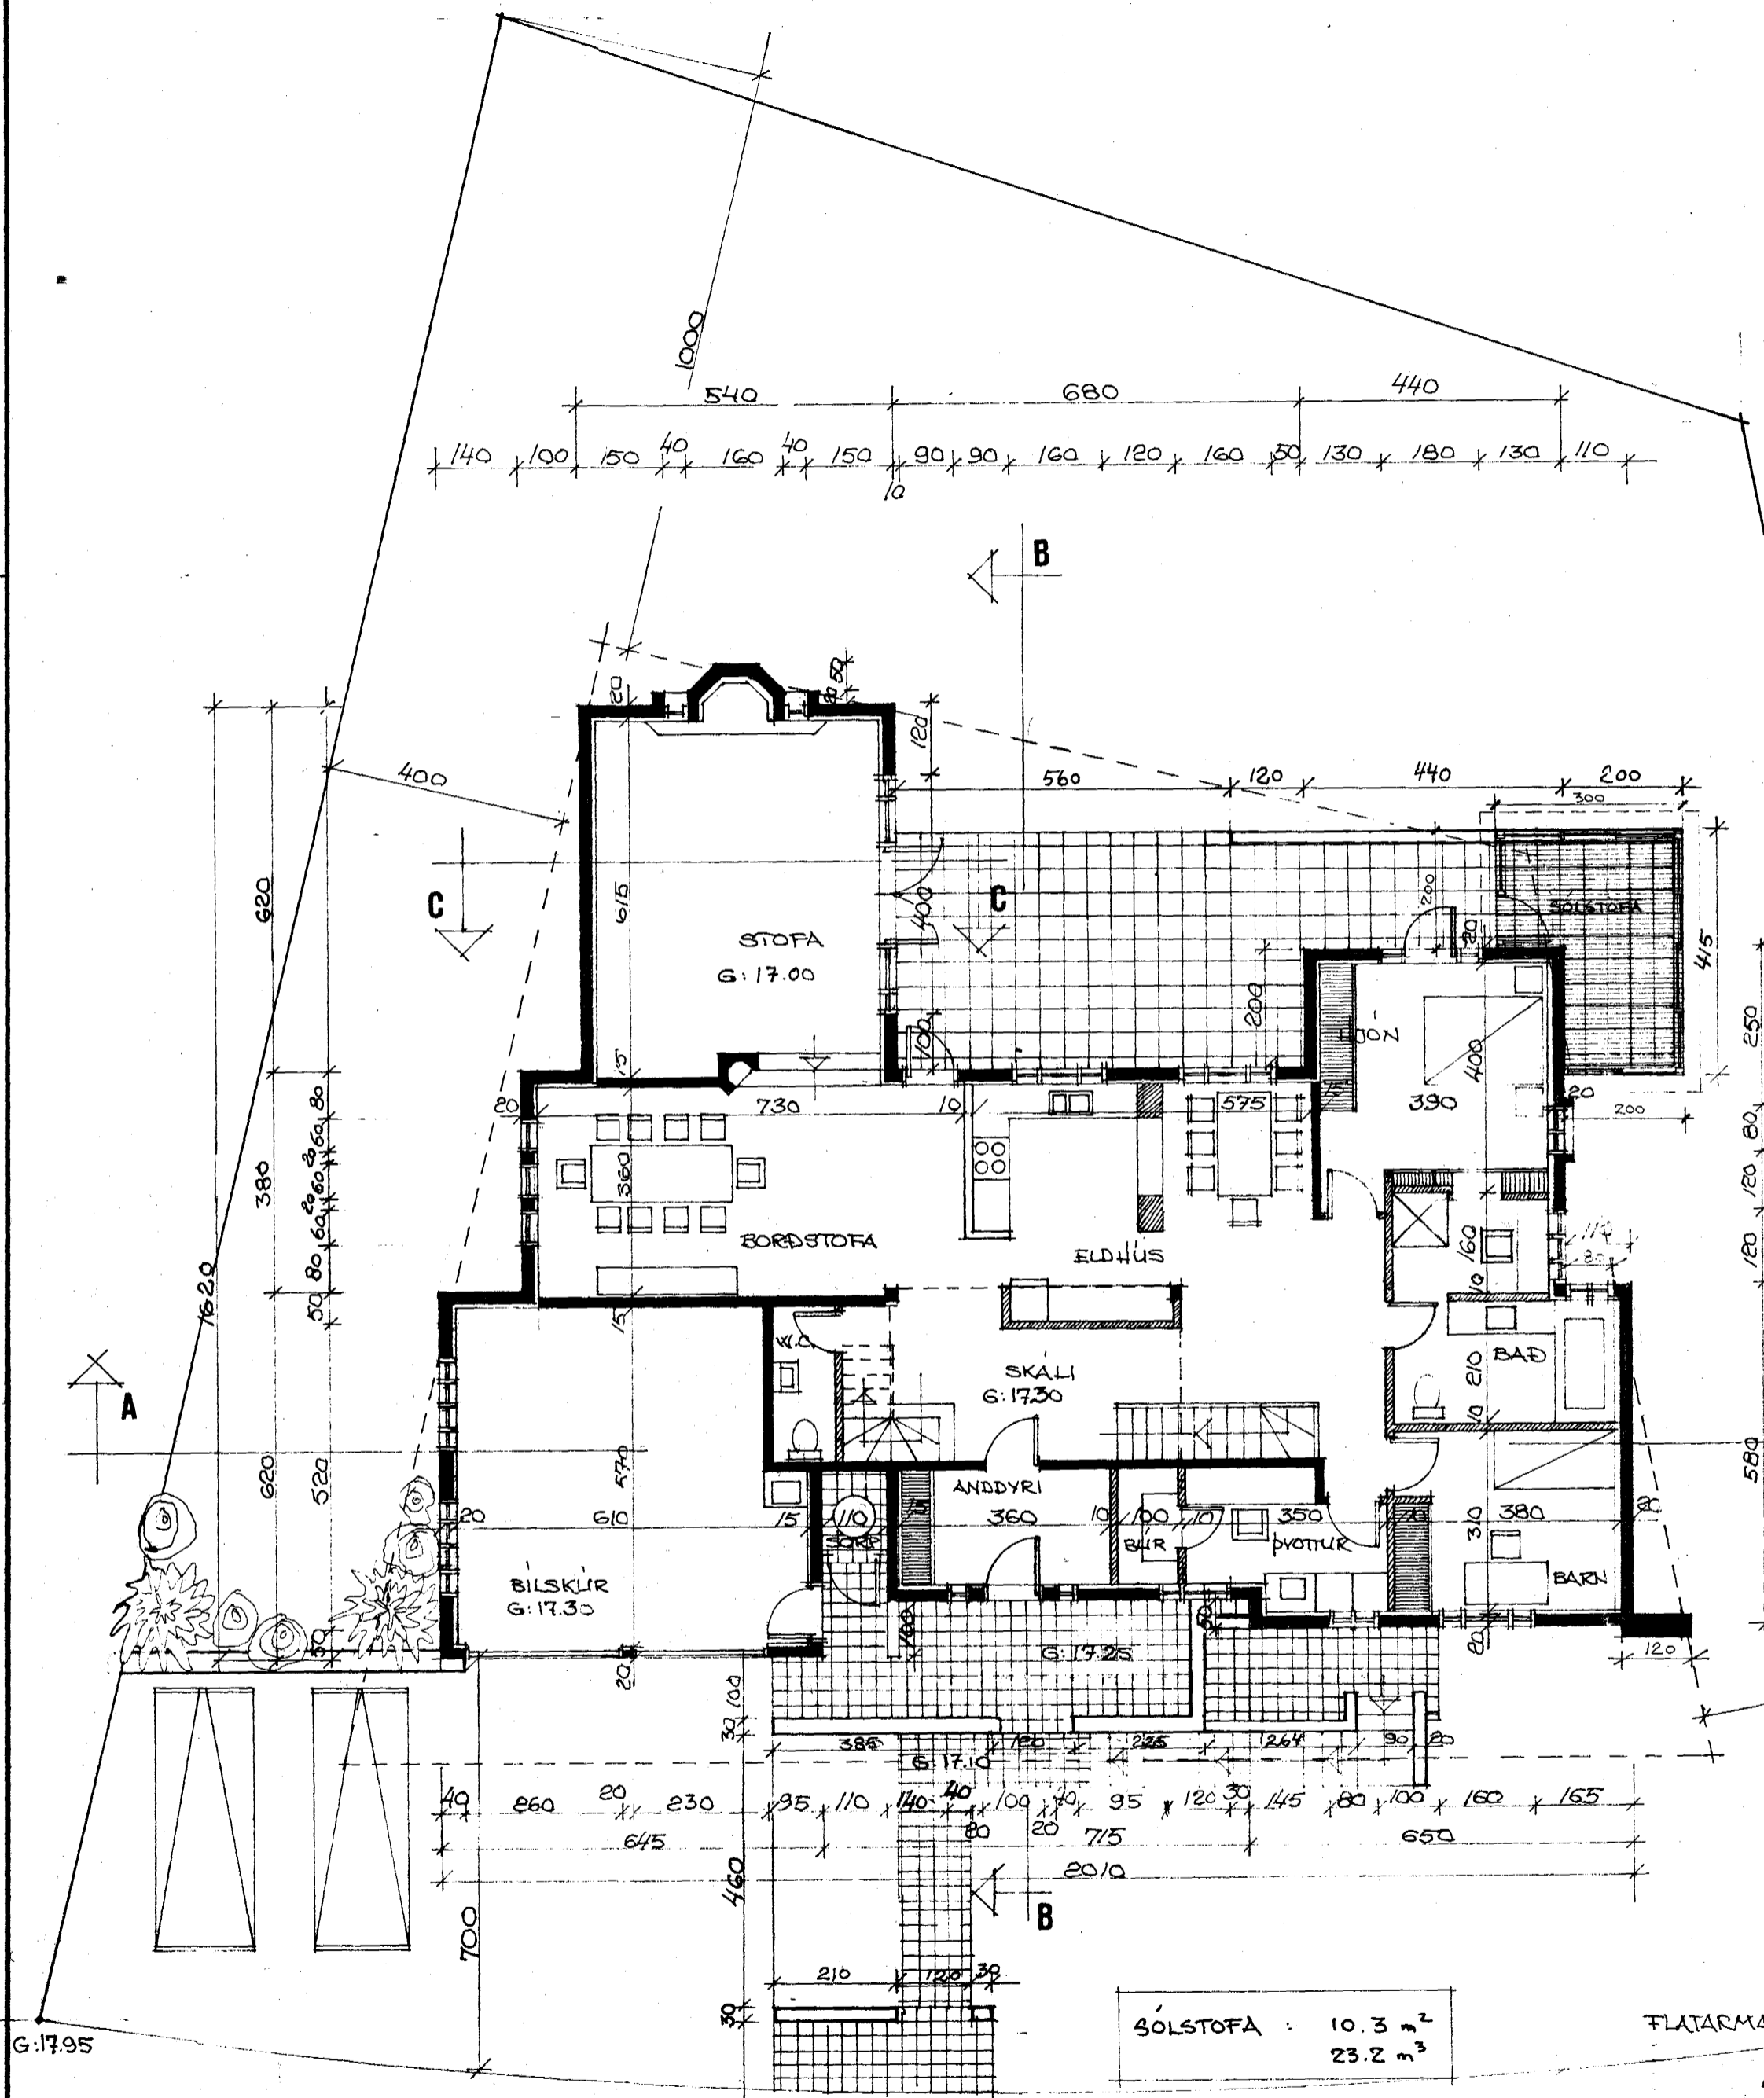

AFSTÖÐLUMYND  
 MKV. 1 : 500

ADALHÆÐ

BREYTING Í APRÍL '91  
 SOLSTOFA BYGGD YFIR SVALIK Á SUBURHLÍÐ

SOLSTOFA : 10.3 x 23.2

FLATARMÁL:  
 KJALLARI : 79.3 m<sup>2</sup>  
 ADAL HÆÐ : 180.5 m<sup>2</sup>  
 RISHERBERGI : 26.2 m<sup>2</sup>  
 BILSKLUR : 37.5 m<sup>2</sup>  
 SAMTALS : 323.5 m<sup>2</sup>  
 HEILDARRÚMMÁL : 1006 m<sup>3</sup>

heiti SÆVANGUR 50  
 eign ÞÓRAR SIGURÐSSONAR  
 teikn GRUNNMYNDIR mkv 1:100  
 TEIKNISTOFA TÚNGÖTU 6 SÍMI 16404  
 VÍFILL MAGNÚSSON ARKITEKT  
 teiknad SEPT. '83 breytt KÓTAR HEKKADIR LMV  
 30 cm. OKT. '83.

1  
*[Signature]*