


KALT VATN HEIMED Ø32 PLAST

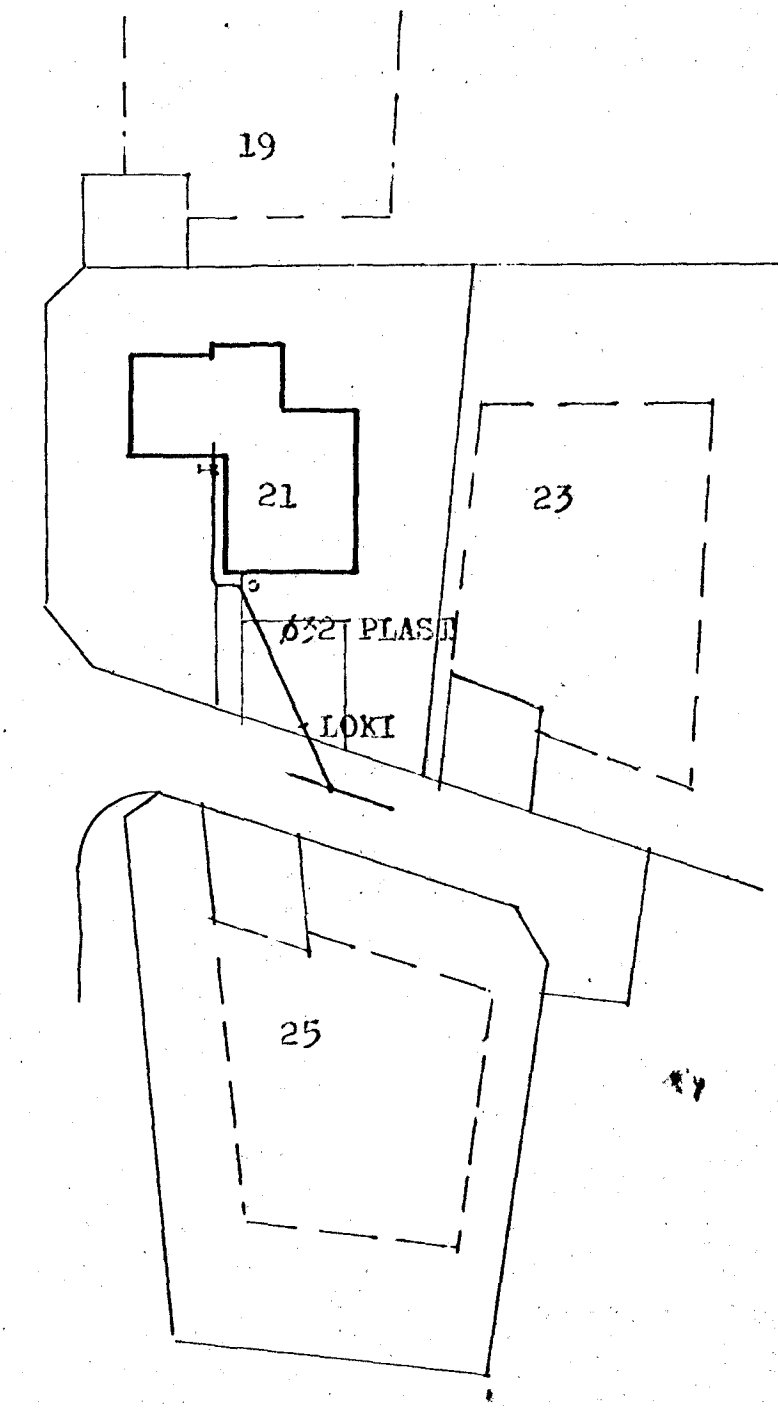

AFSTÖEUMYND 1:500

Breytt 20/73

STEINGRÍMUR TH. ÞORLEIFSSON MFPI		
SEVANGUR NR. 21 HAFNARFIRDI		
MÁL	1:500 1:50	VATNSLAGNIR - GRUNNMYND KJALLARA - AFSTÖEUMYND
DAGS.	MÁI 1978	
BLAD	4	<i>Steingrímur Þorleifsson</i>