

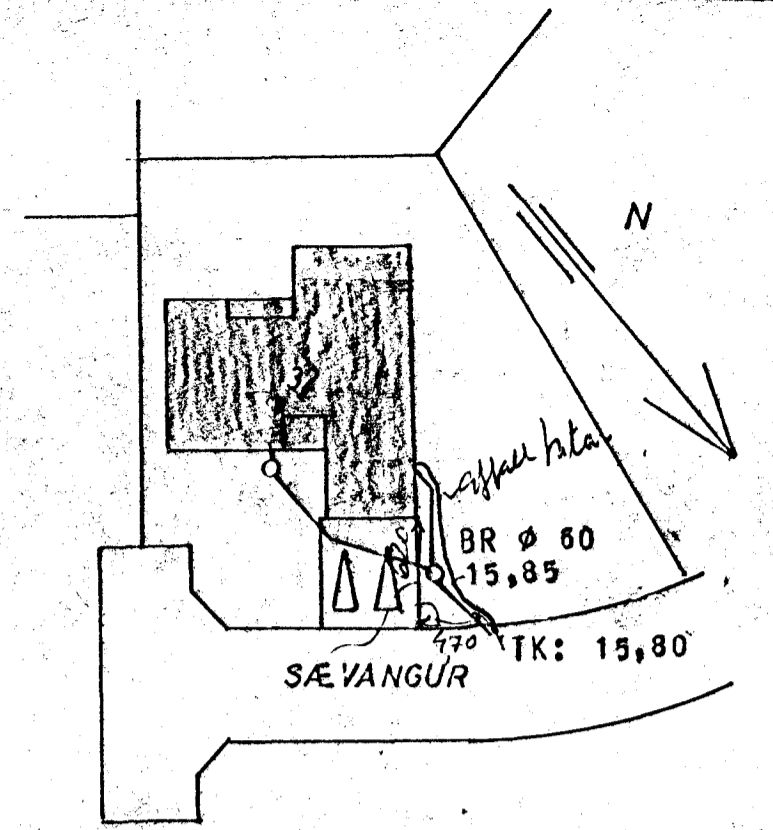


GRUNNMYND 1:50

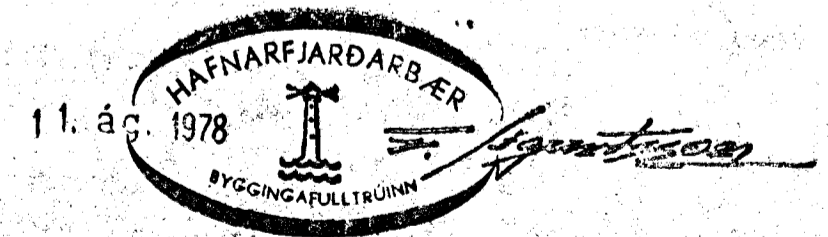

AFSTADA 1:500

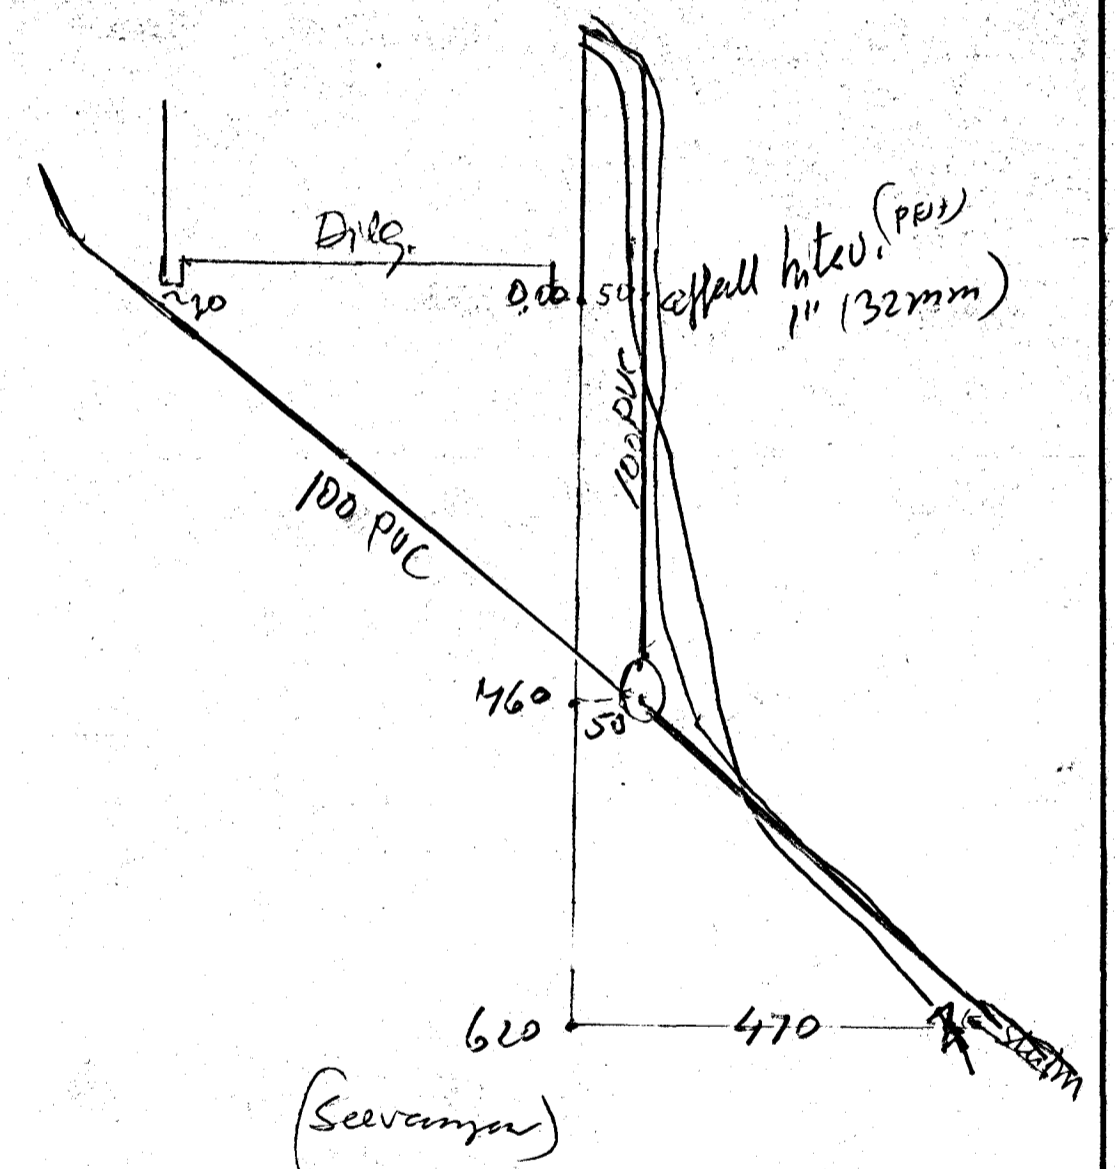

SKÝRINGAR SJÁ TEIKN NR. 20.

SÆVANGUR 32, HAFNARFIRDI.	MÆLIKVÁRDI 1:500 1:50	VERK 1803	TEIKN NR. 2.1
FRÁRENNISLISLÖGN - GRUNNMYND	Hannað: VJ Teiknað: VJ	Yfirfarð: Samb: JGB	DAGS APRIL '78
JÓHANN GUNNAR BERGÞÓRSSON STRANDGÖTU 11 - HAFNARFIRDI - Sími 53319	BREYTT ÁGÚST '78	VERKFR MVFI	