

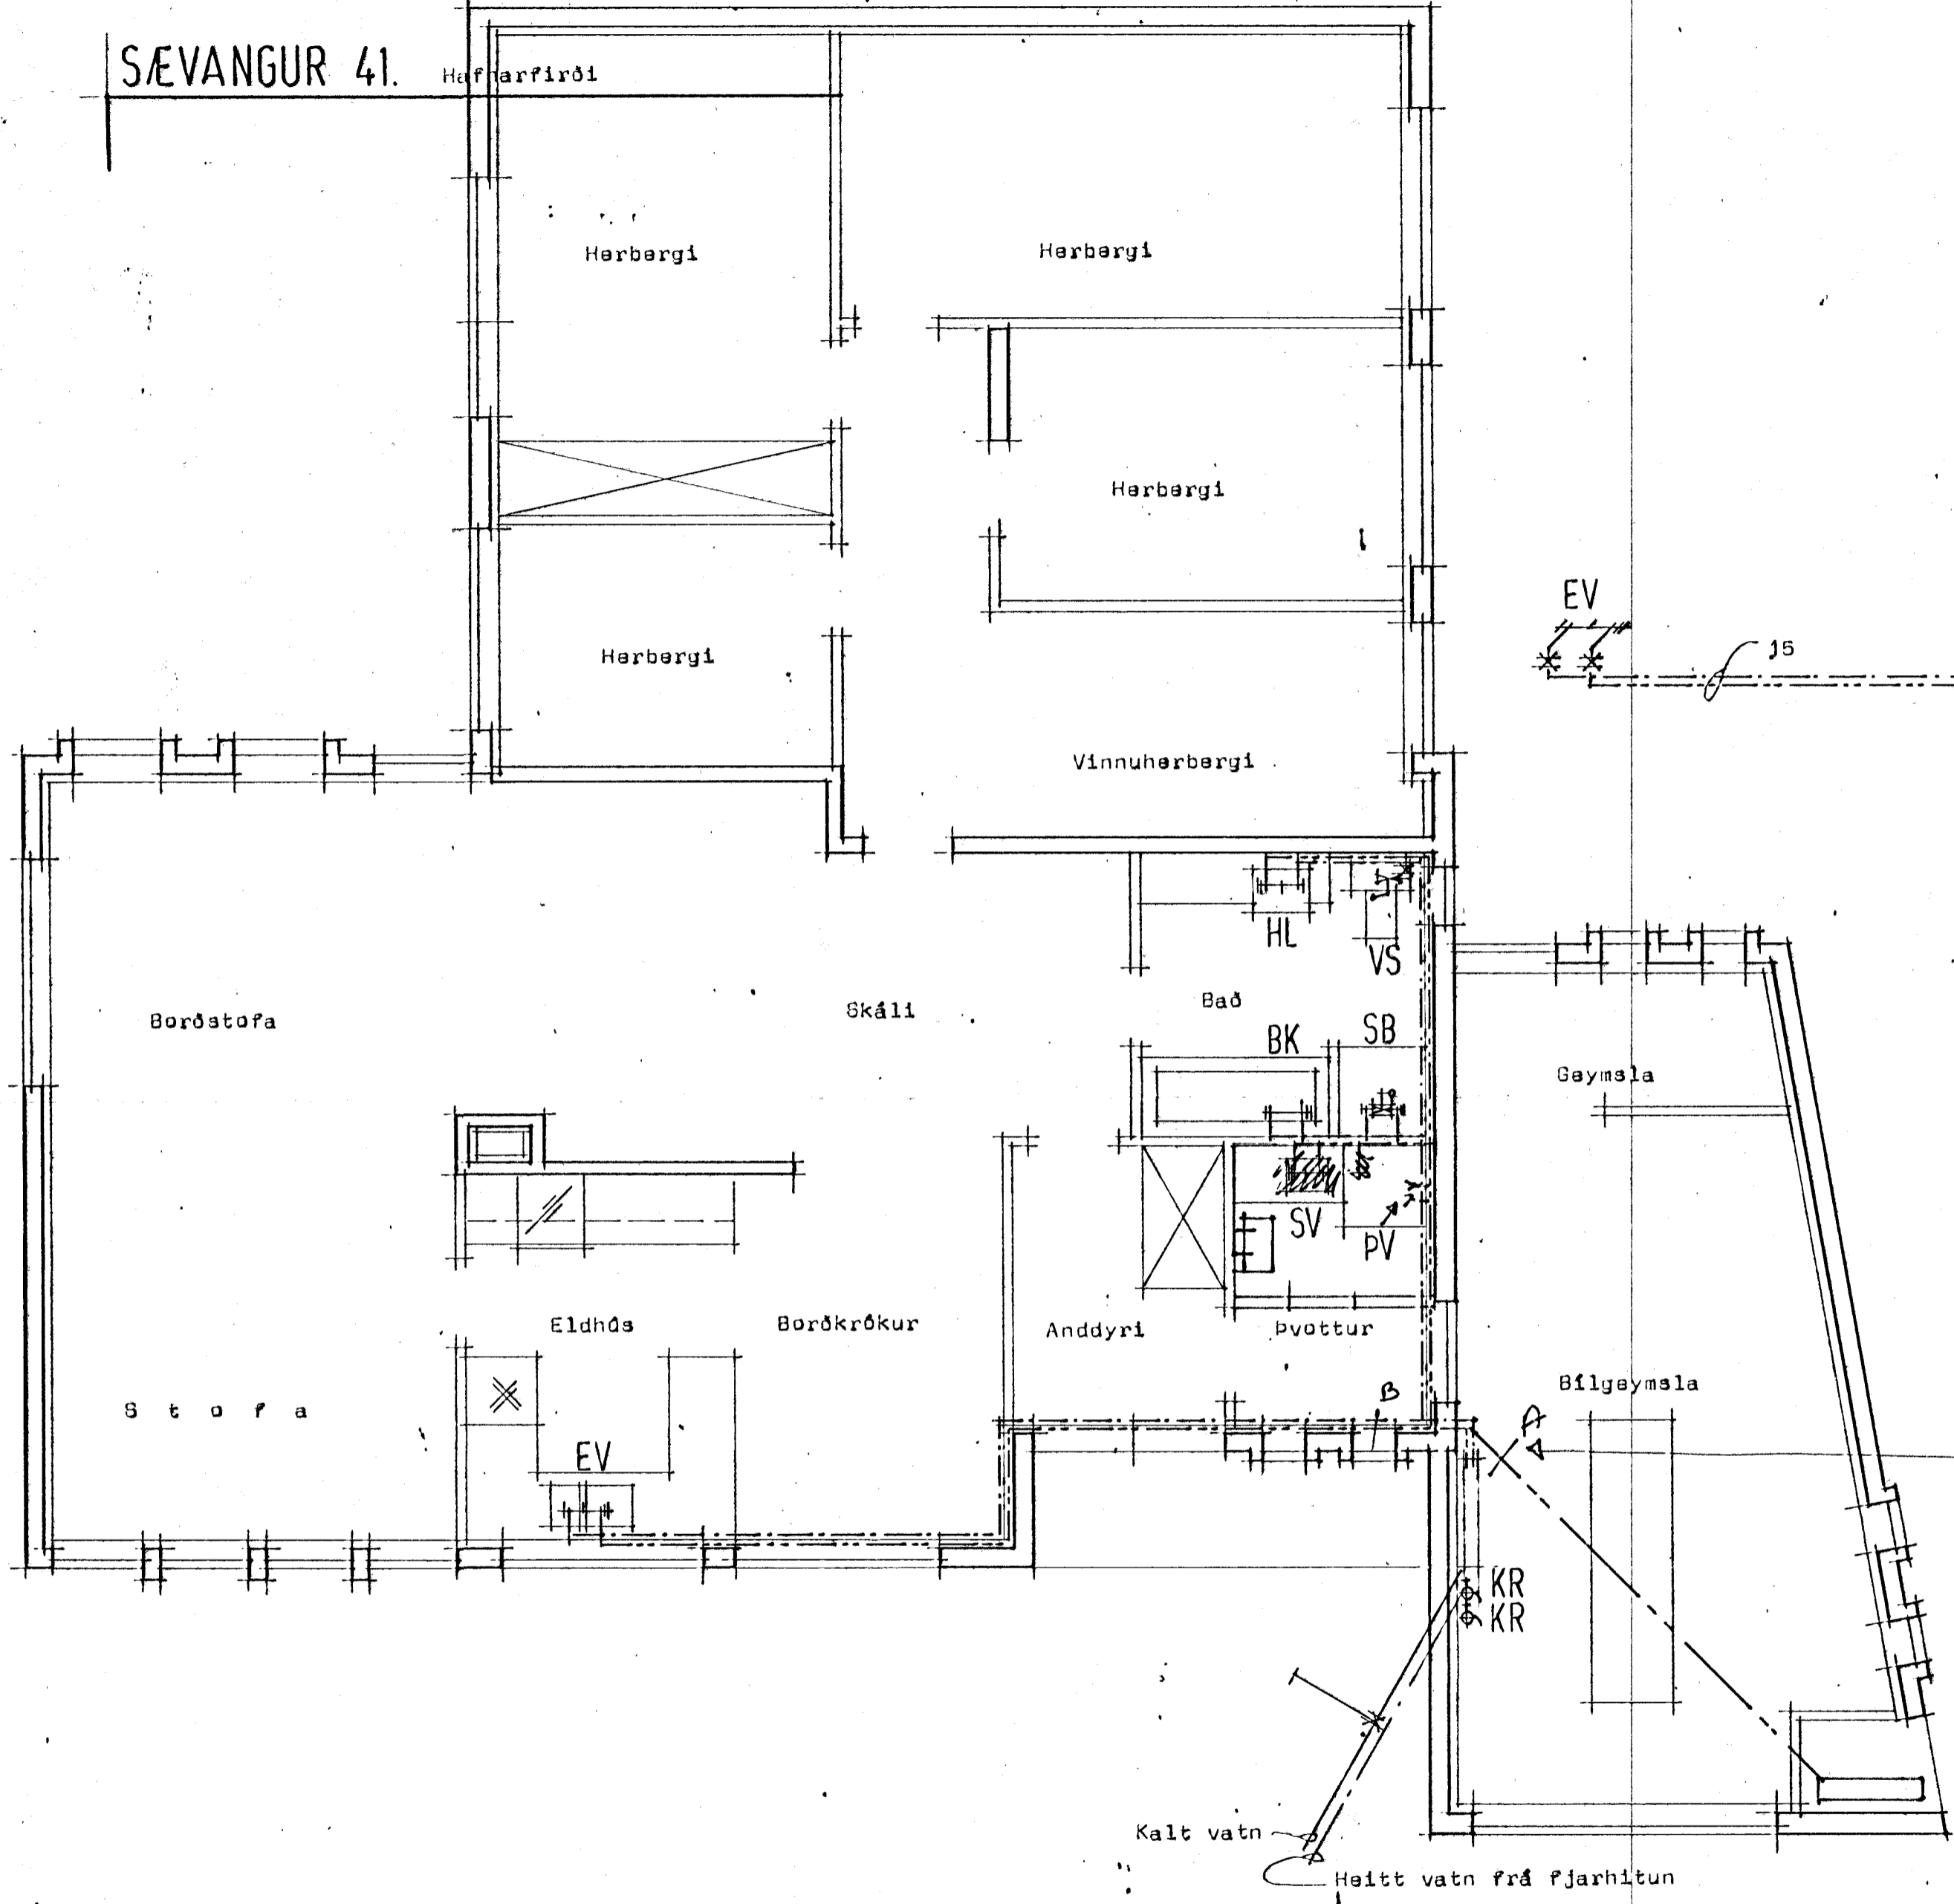


SÆVANGUR 41.

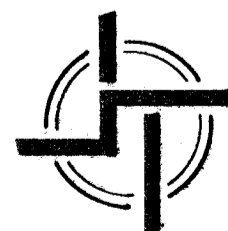

Grunnmynd.

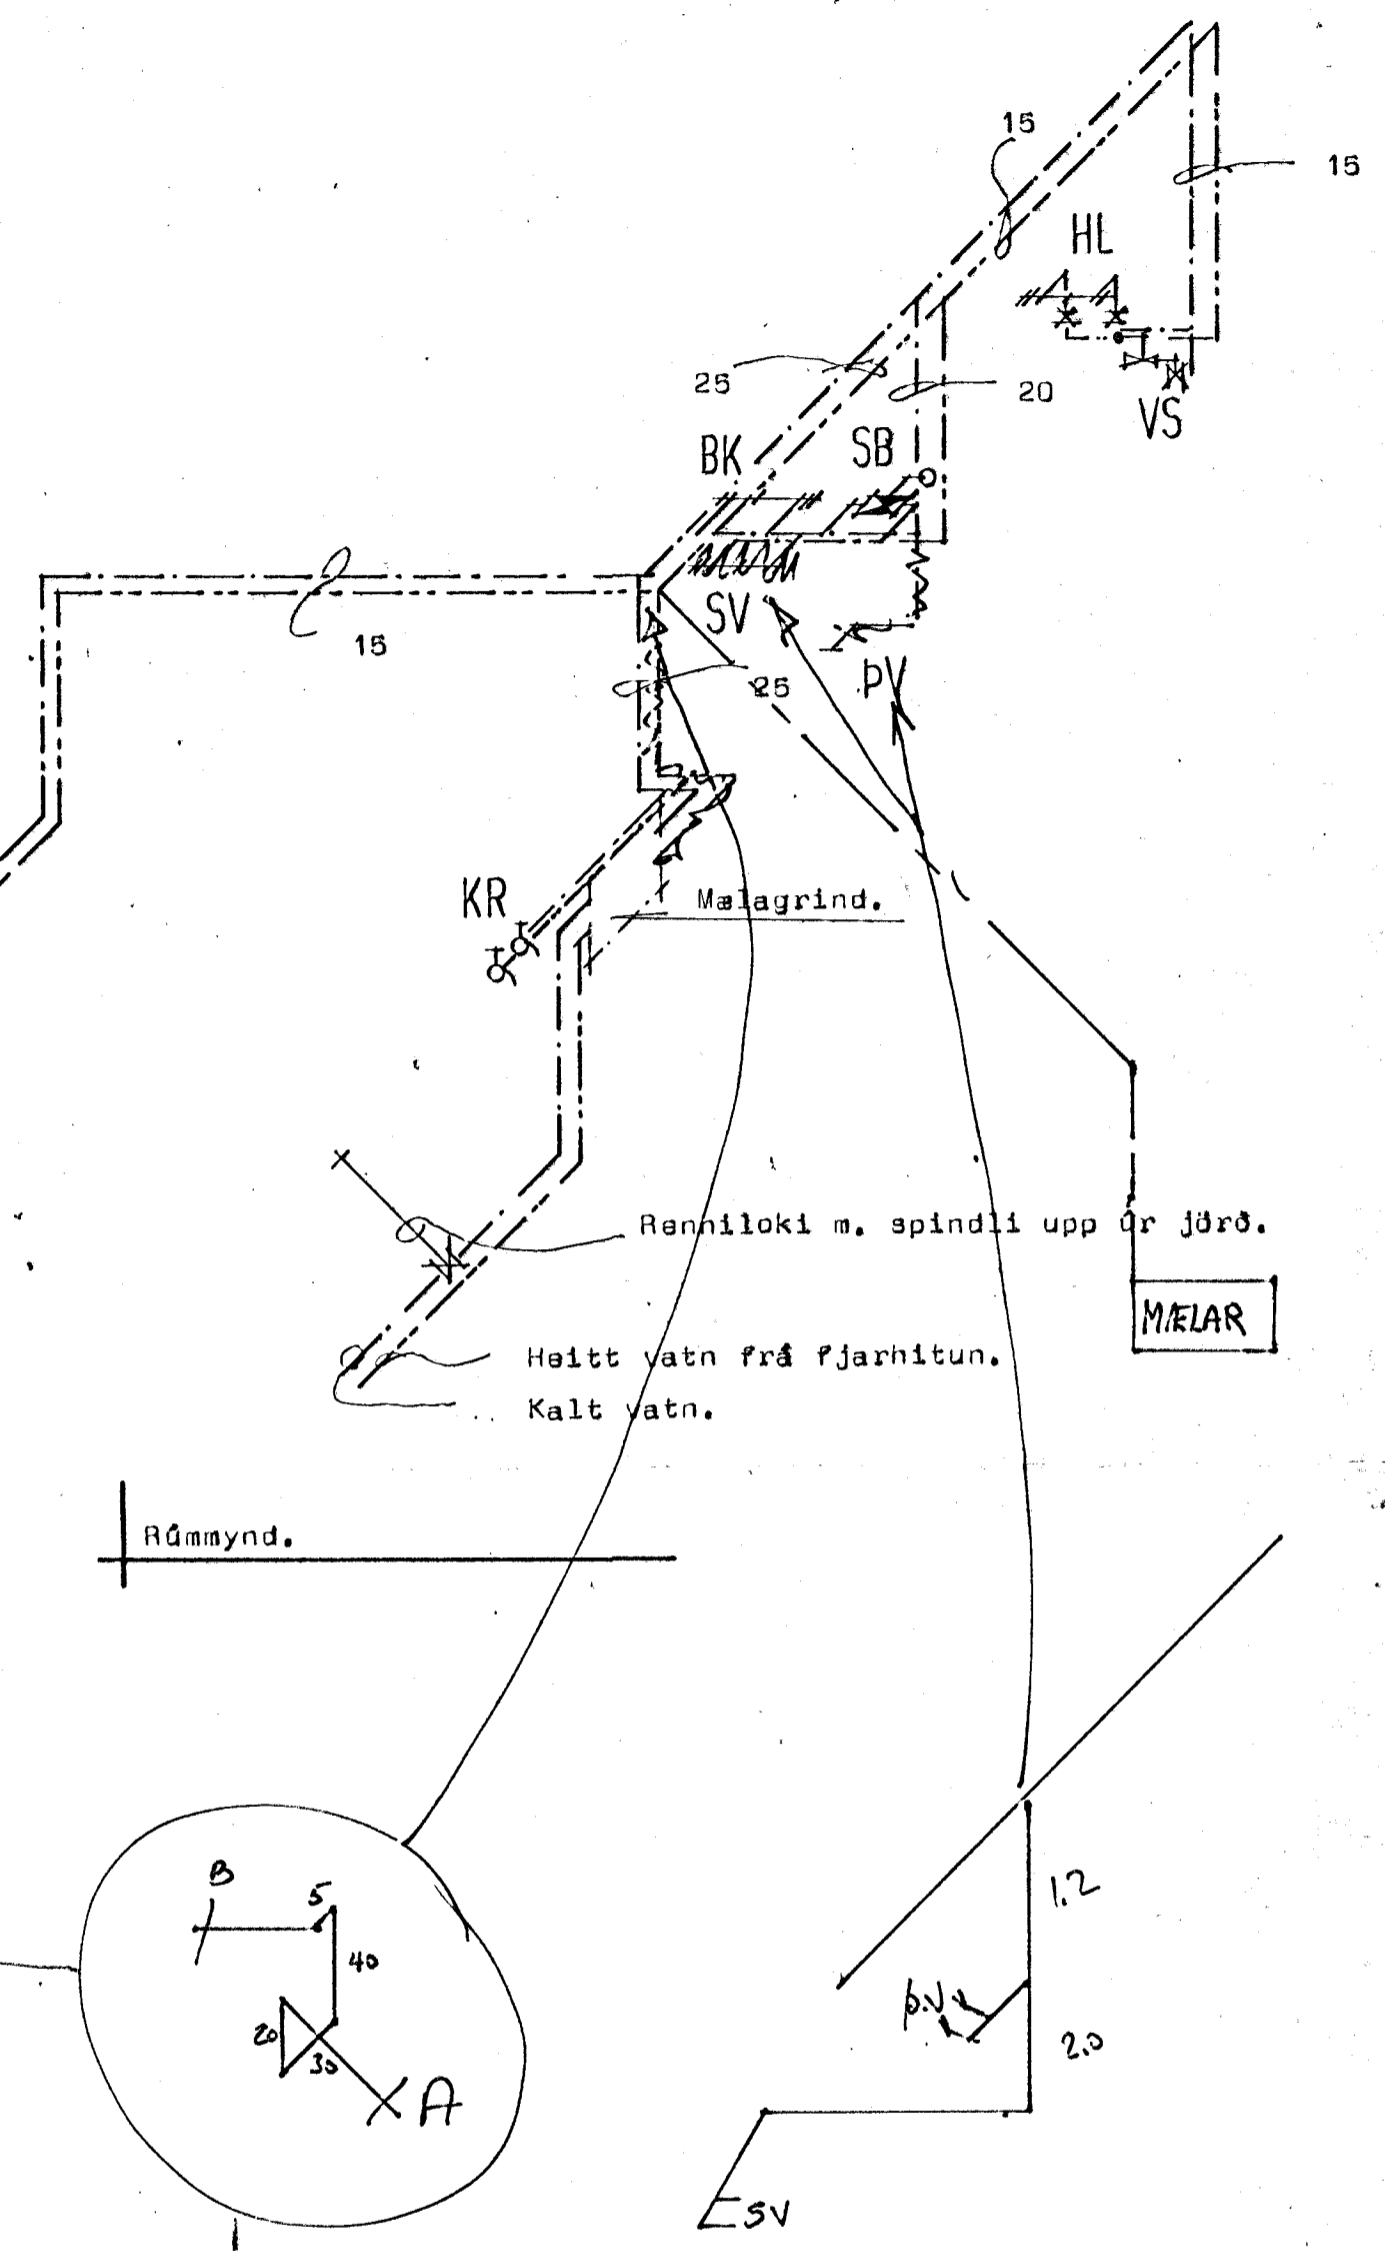

**STÖÐALHÚS** TÍÐ

TEIKNISTOFA SUDURLANDSBRAUT 20 SIMI (3141)

VERKEFNI	DAGS.	1978	VERK NR
Vatnslagnir	MKV.	1150	S 44
Grunnmynd og rúmmynd.	BR.		
	BLAD NR		

SIGURDUR GUÐMUNDSSON      SIGURDUR P KRISTJÁNSSON      PTFI