

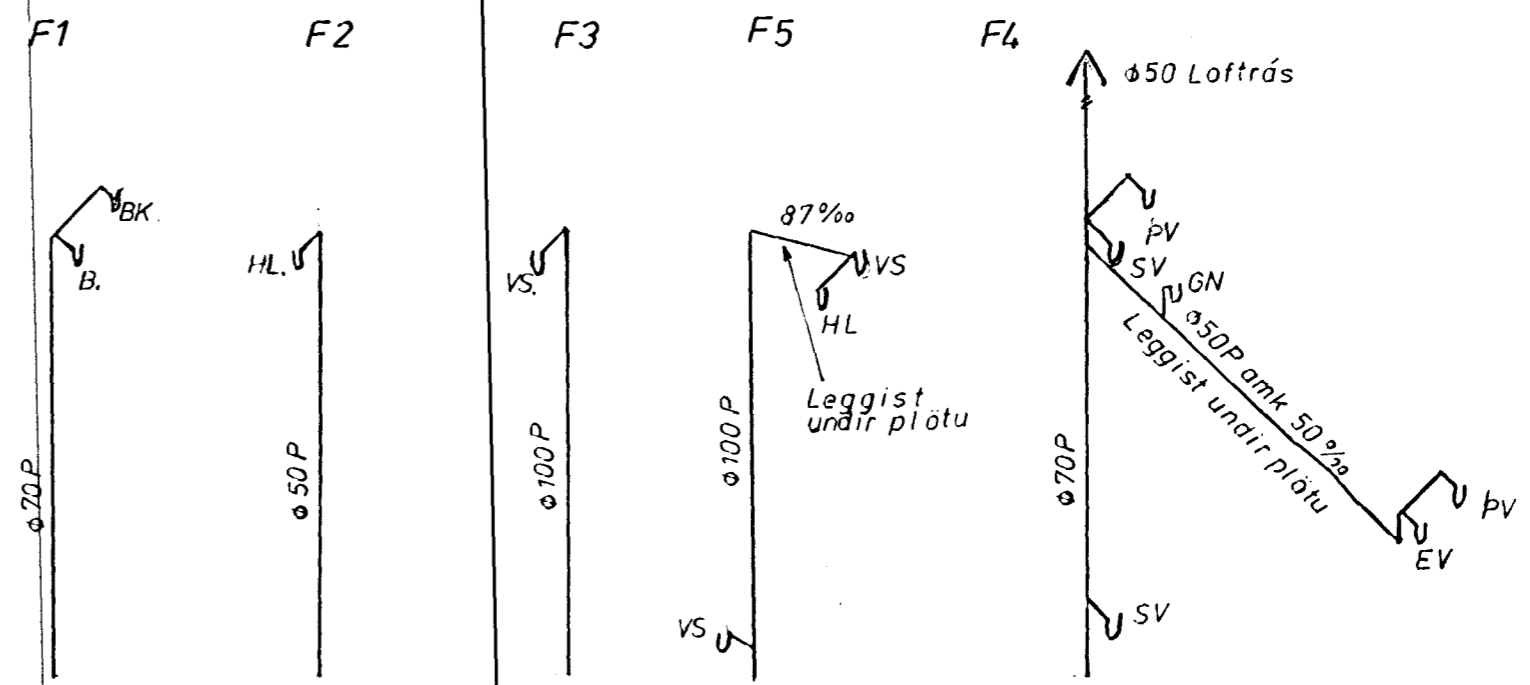
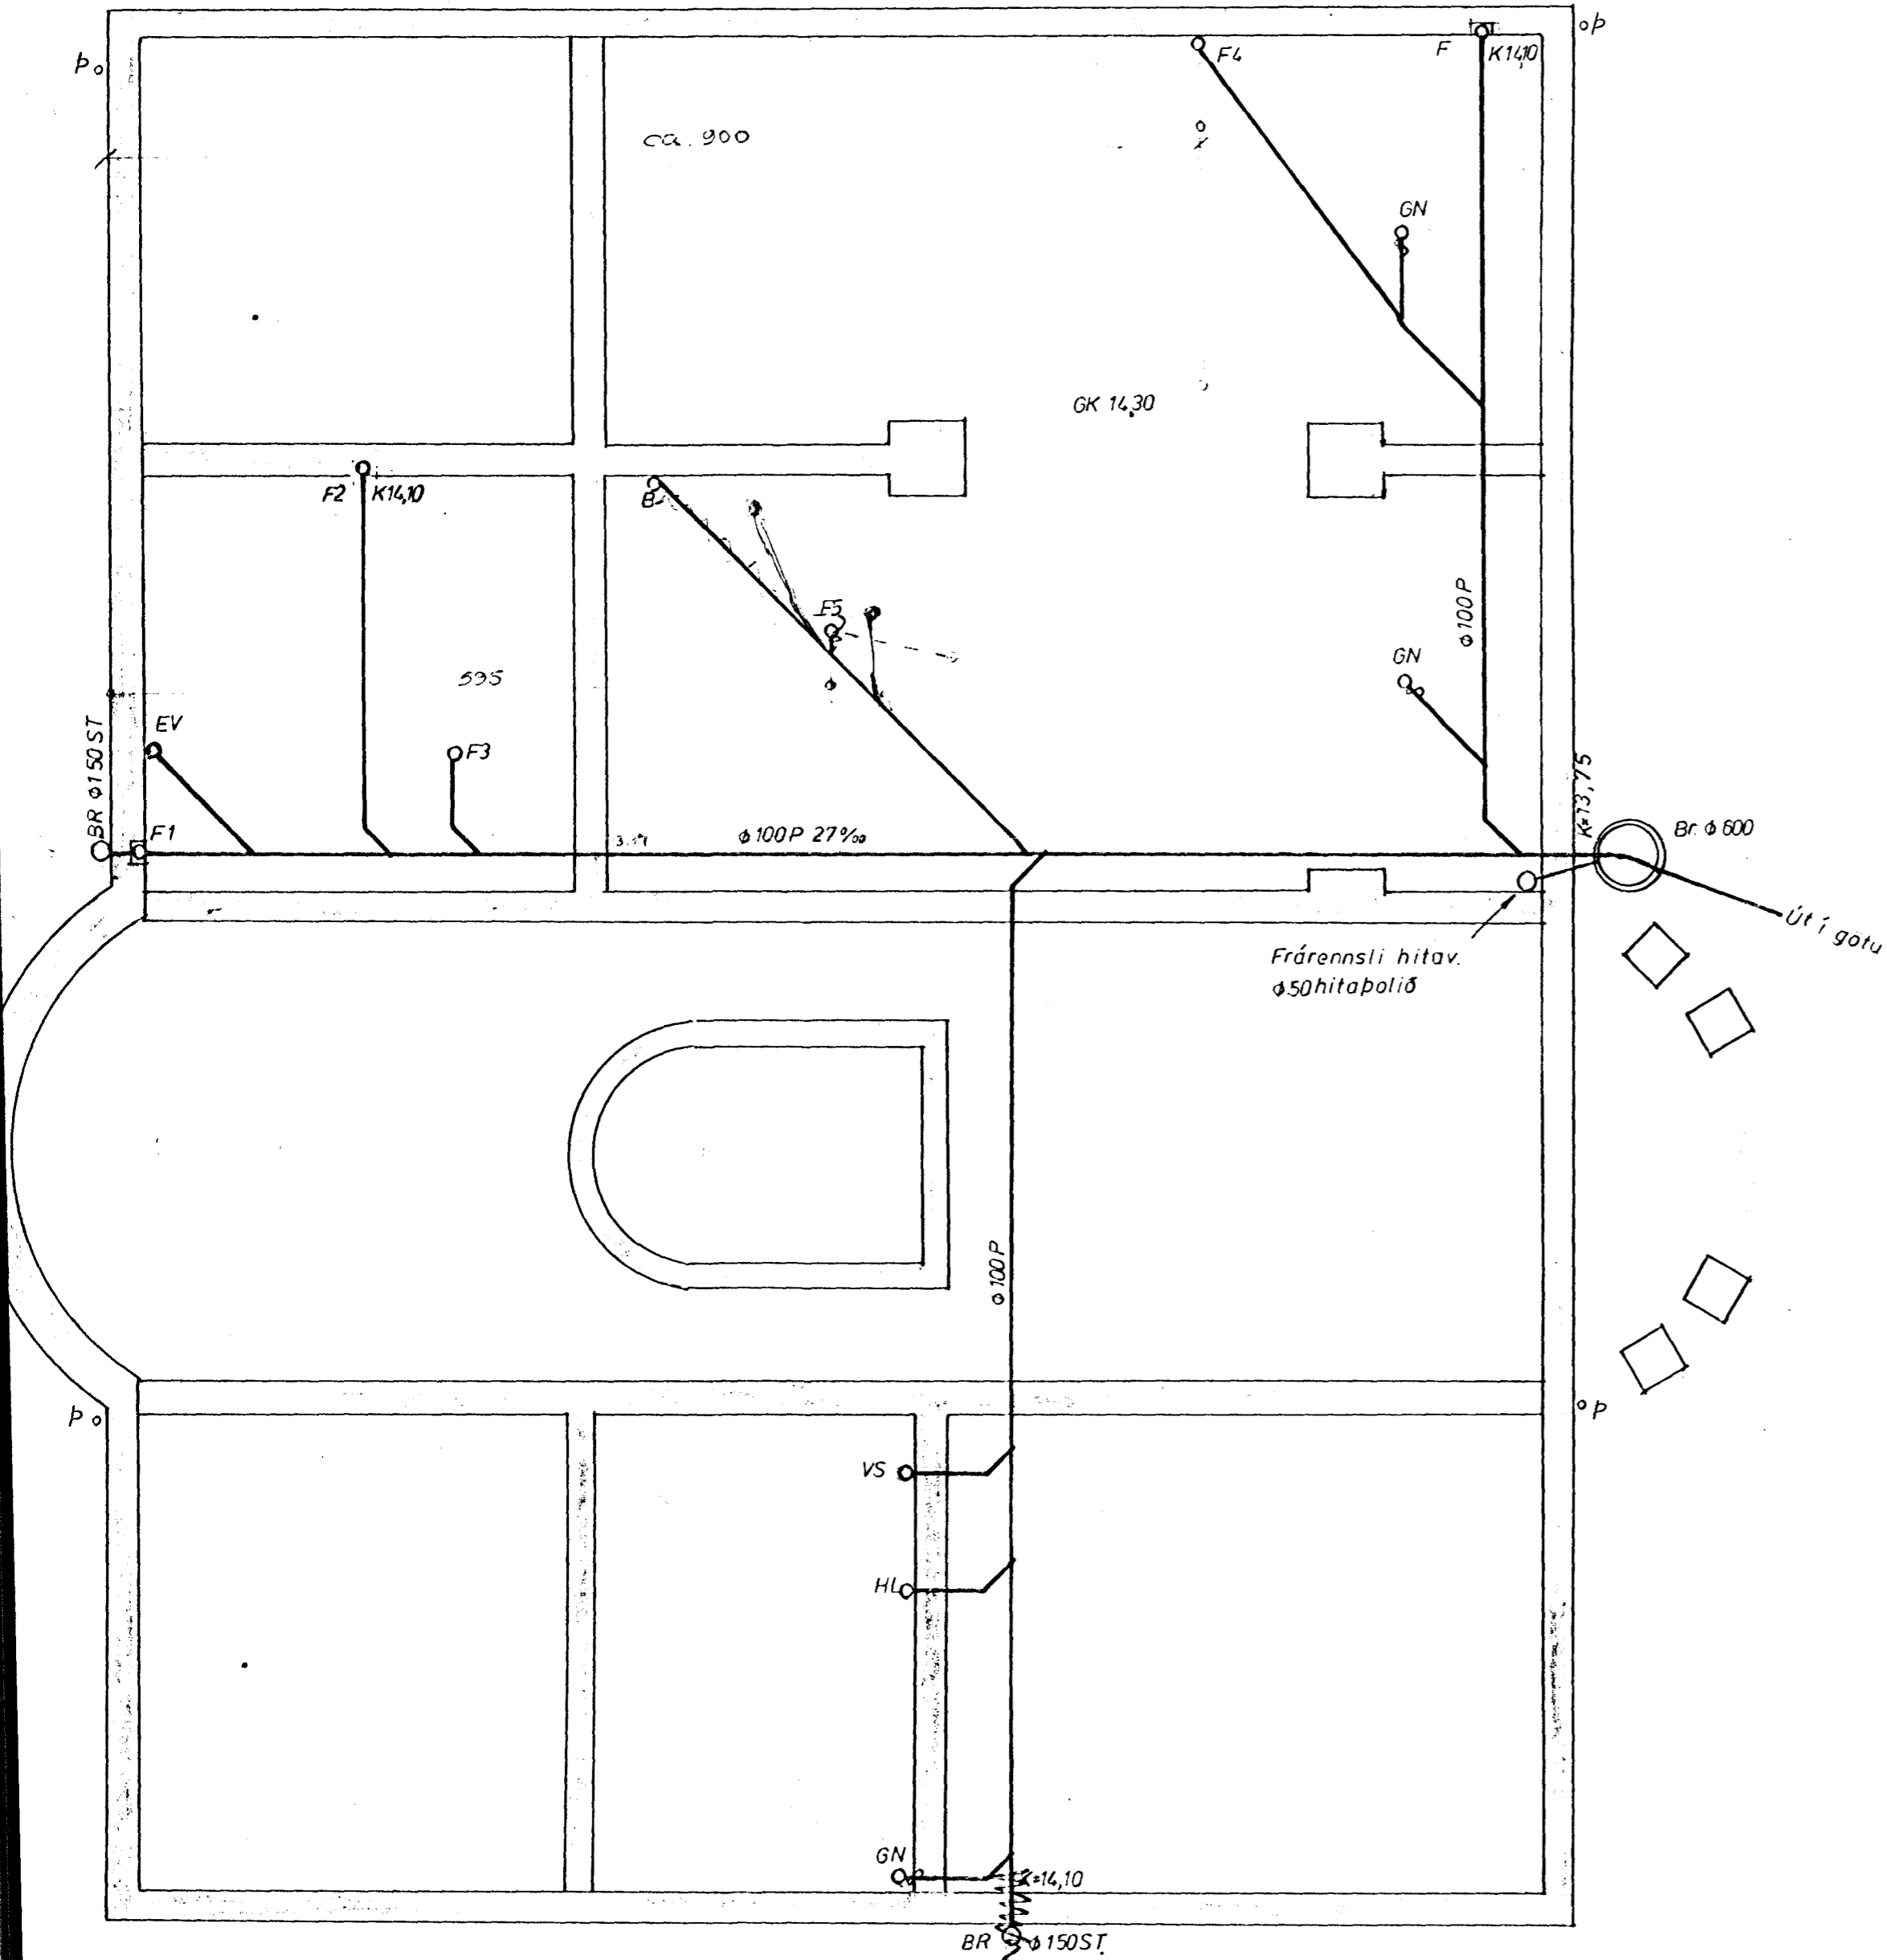


# Frárennslislagnir m=1:50

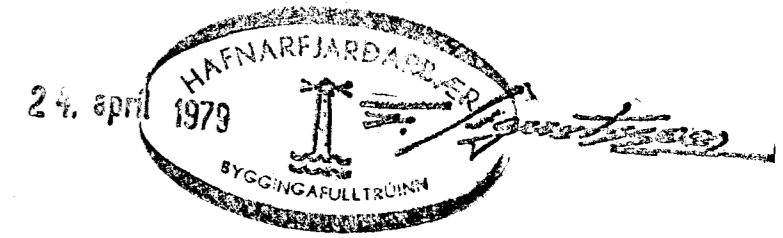

Afsöðumynd 1:500

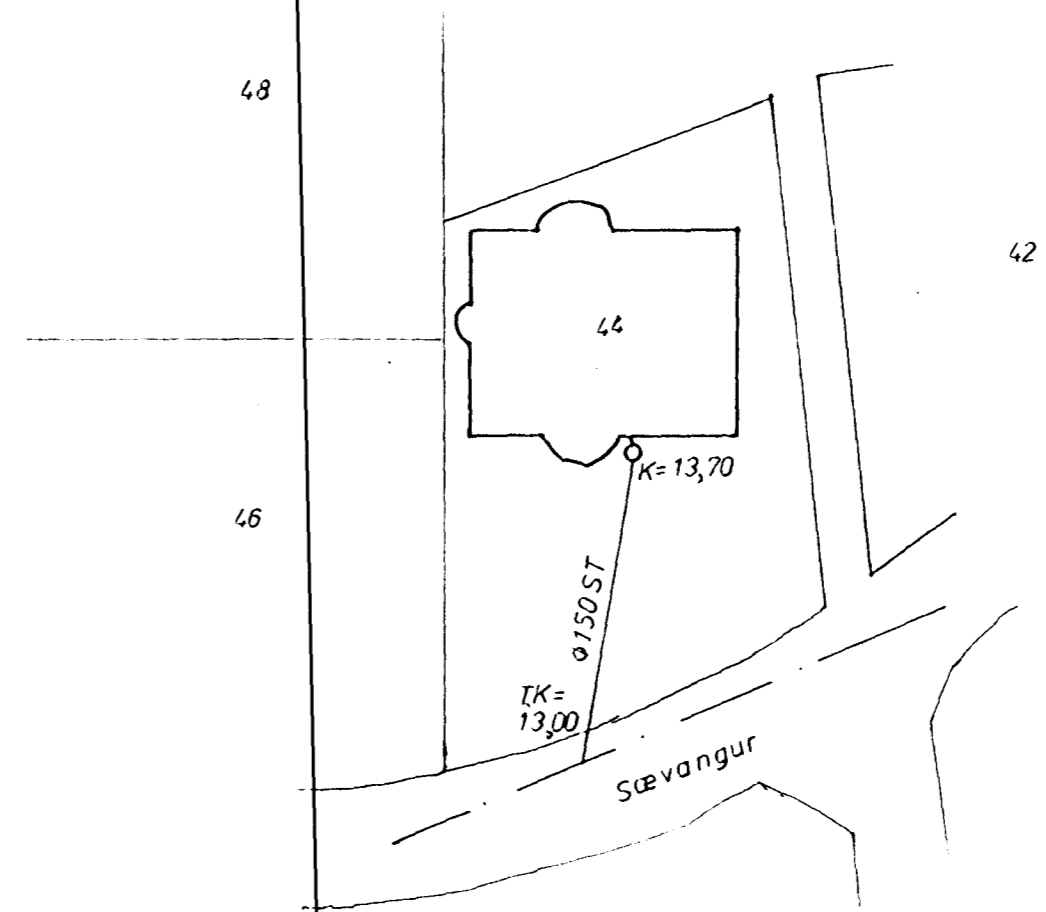

Br. mars '79 PA

ÞORVALDUK ÁNGERS ALFASKEIÐI 32 - 101 Reykjavík - T. 53502	
Verkefni: Sævangur 44	7801102
Frárennslislagnir	1978
Mækk. 1:50	1979