



SNID D
1:50 L04

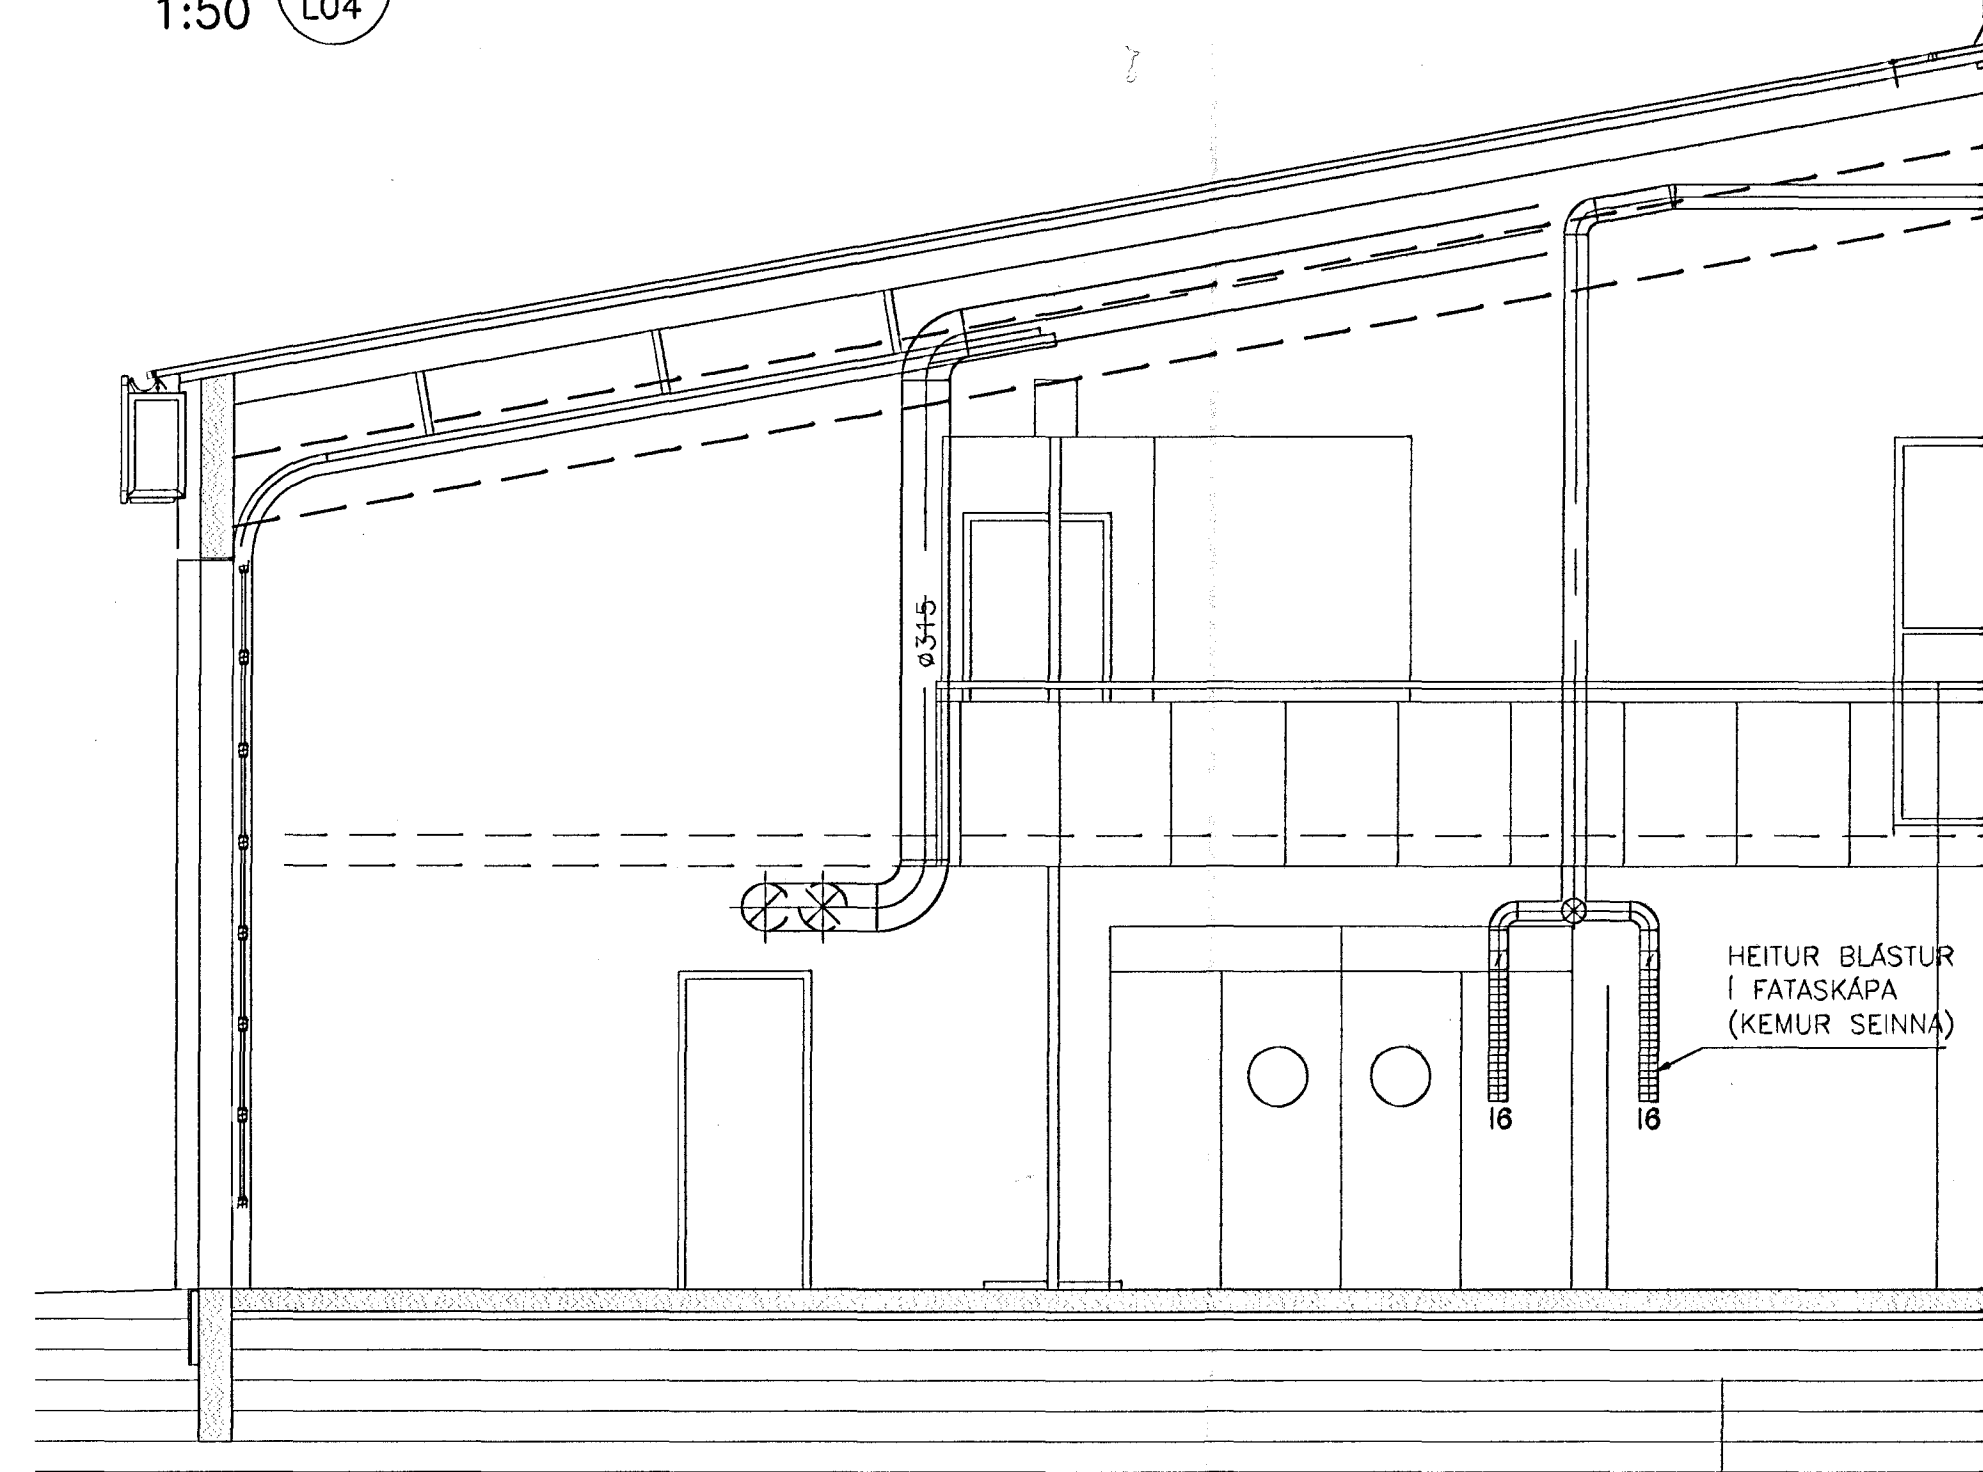

SNID A
1:50 L01

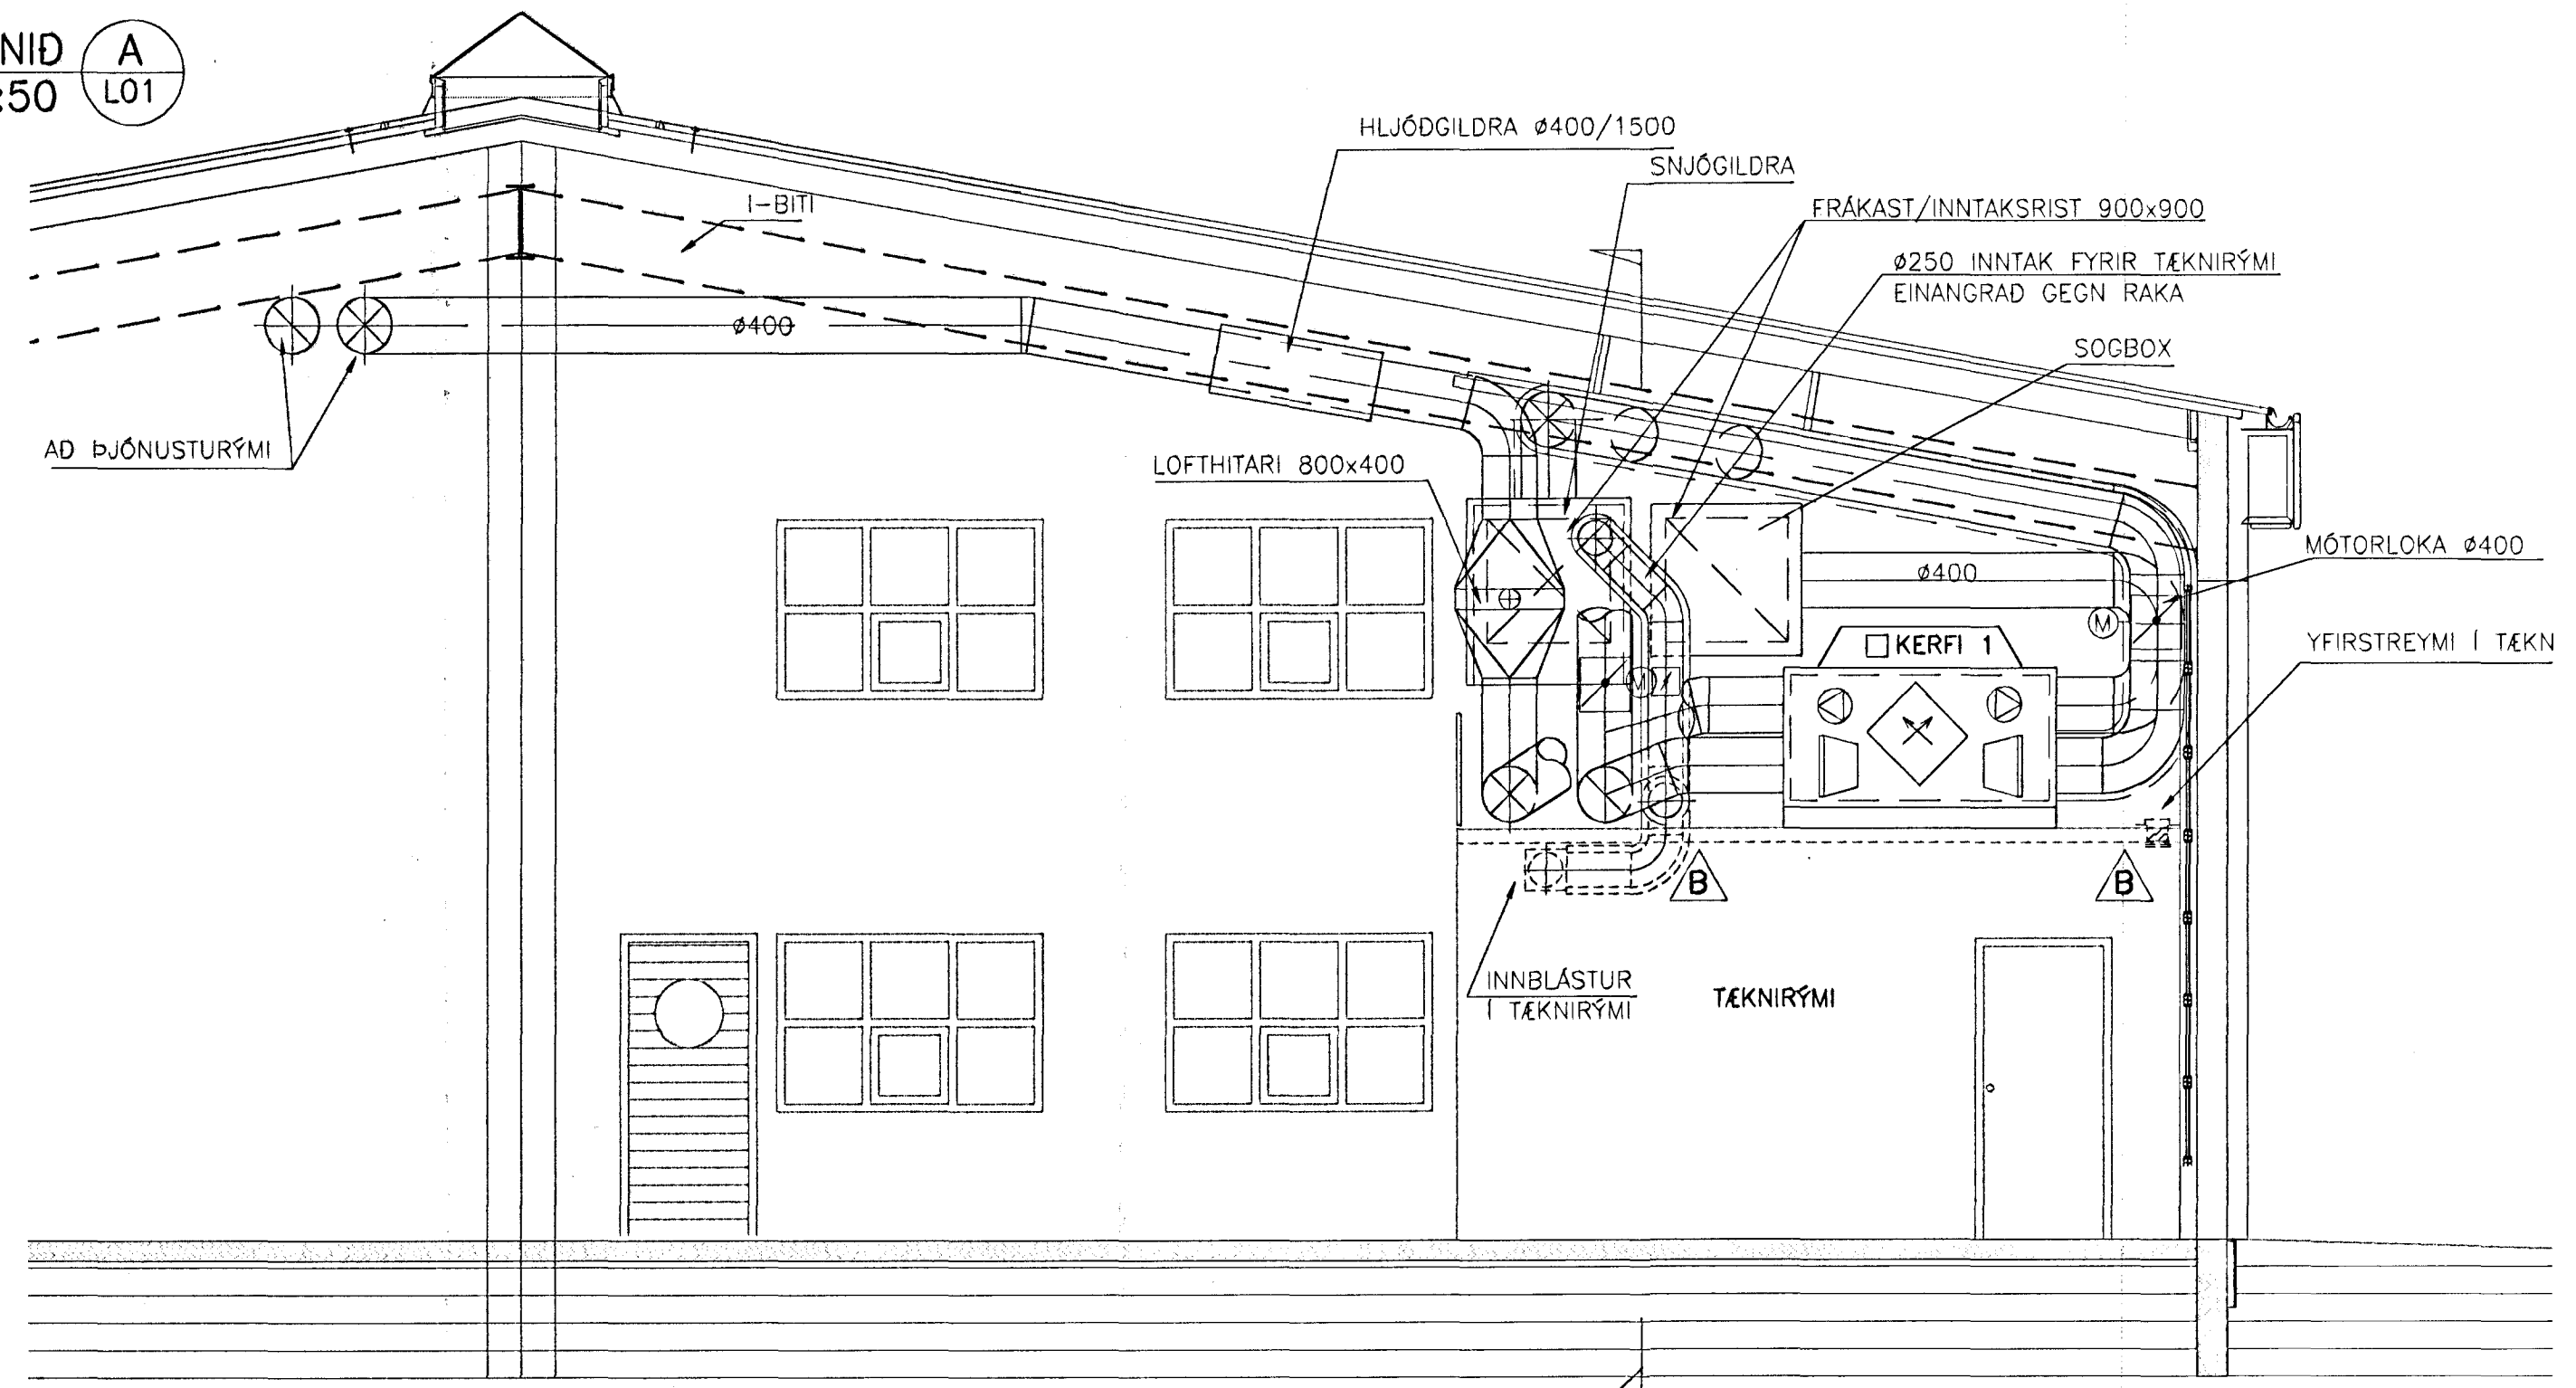


G
L01


SNID E
1:50 L03

SNID C C
1:50 L04 L02


TVÖFÖLD SKÁBLADARIST
STÁRD: 900x900
BLÖÐ GR ALI 1,25 MM
FLUGNANET

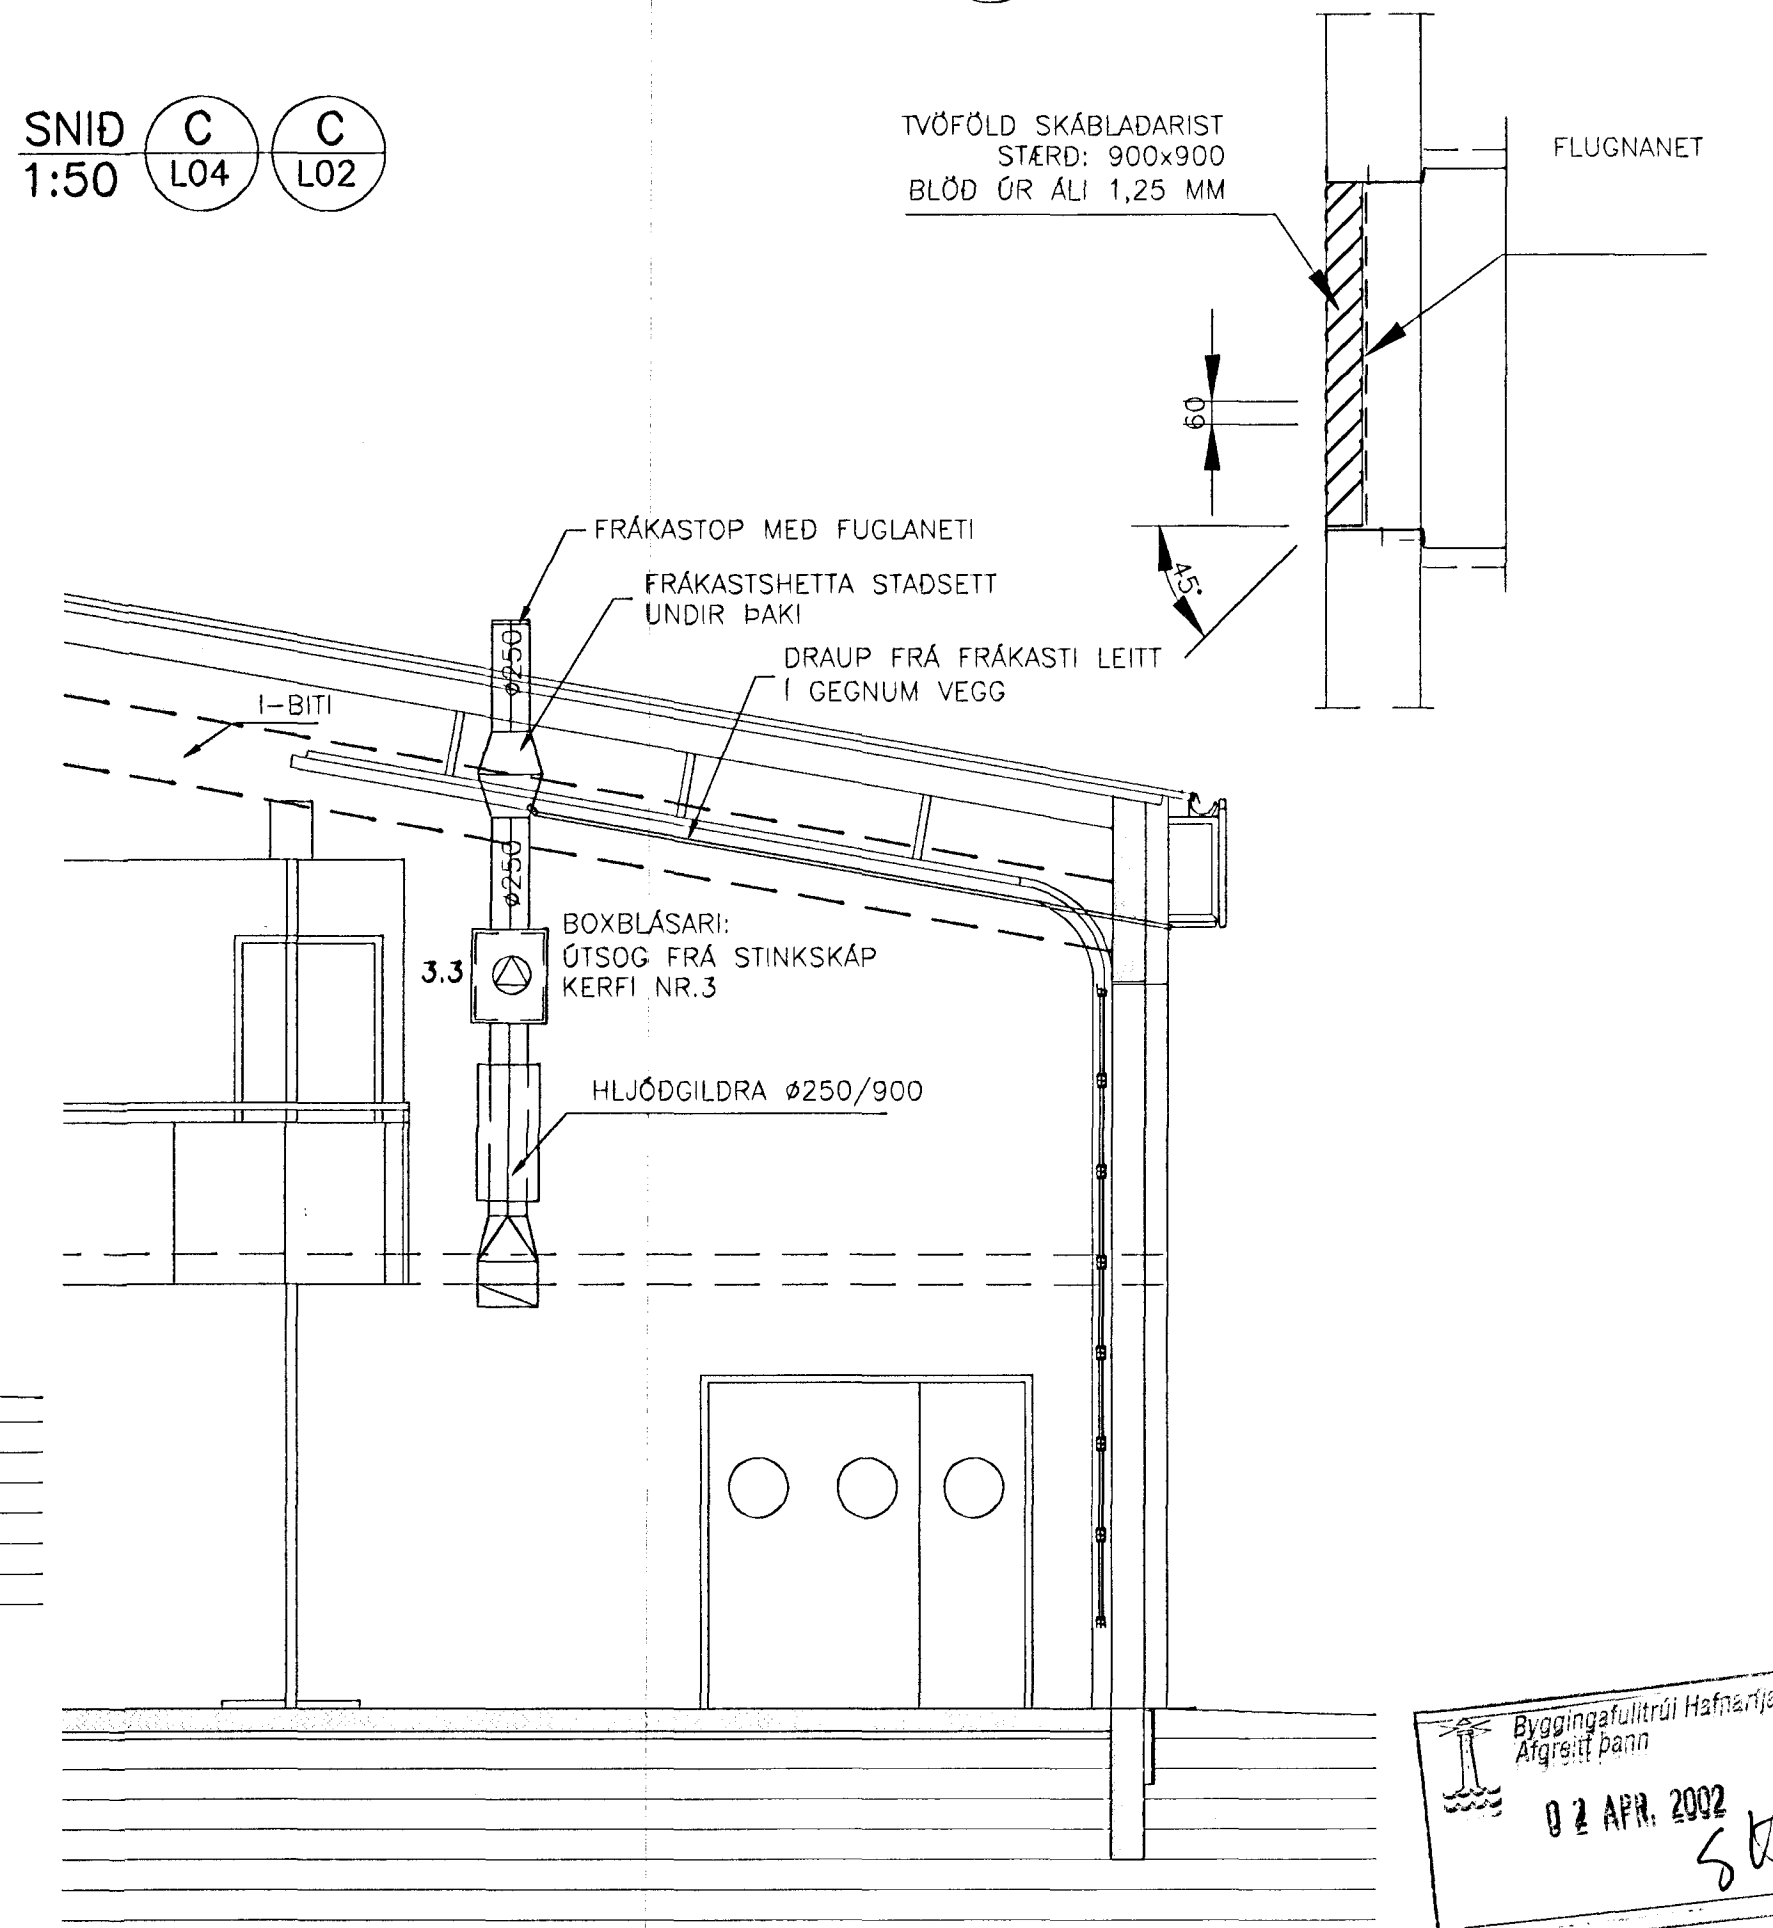

SNID B
1:50 L04

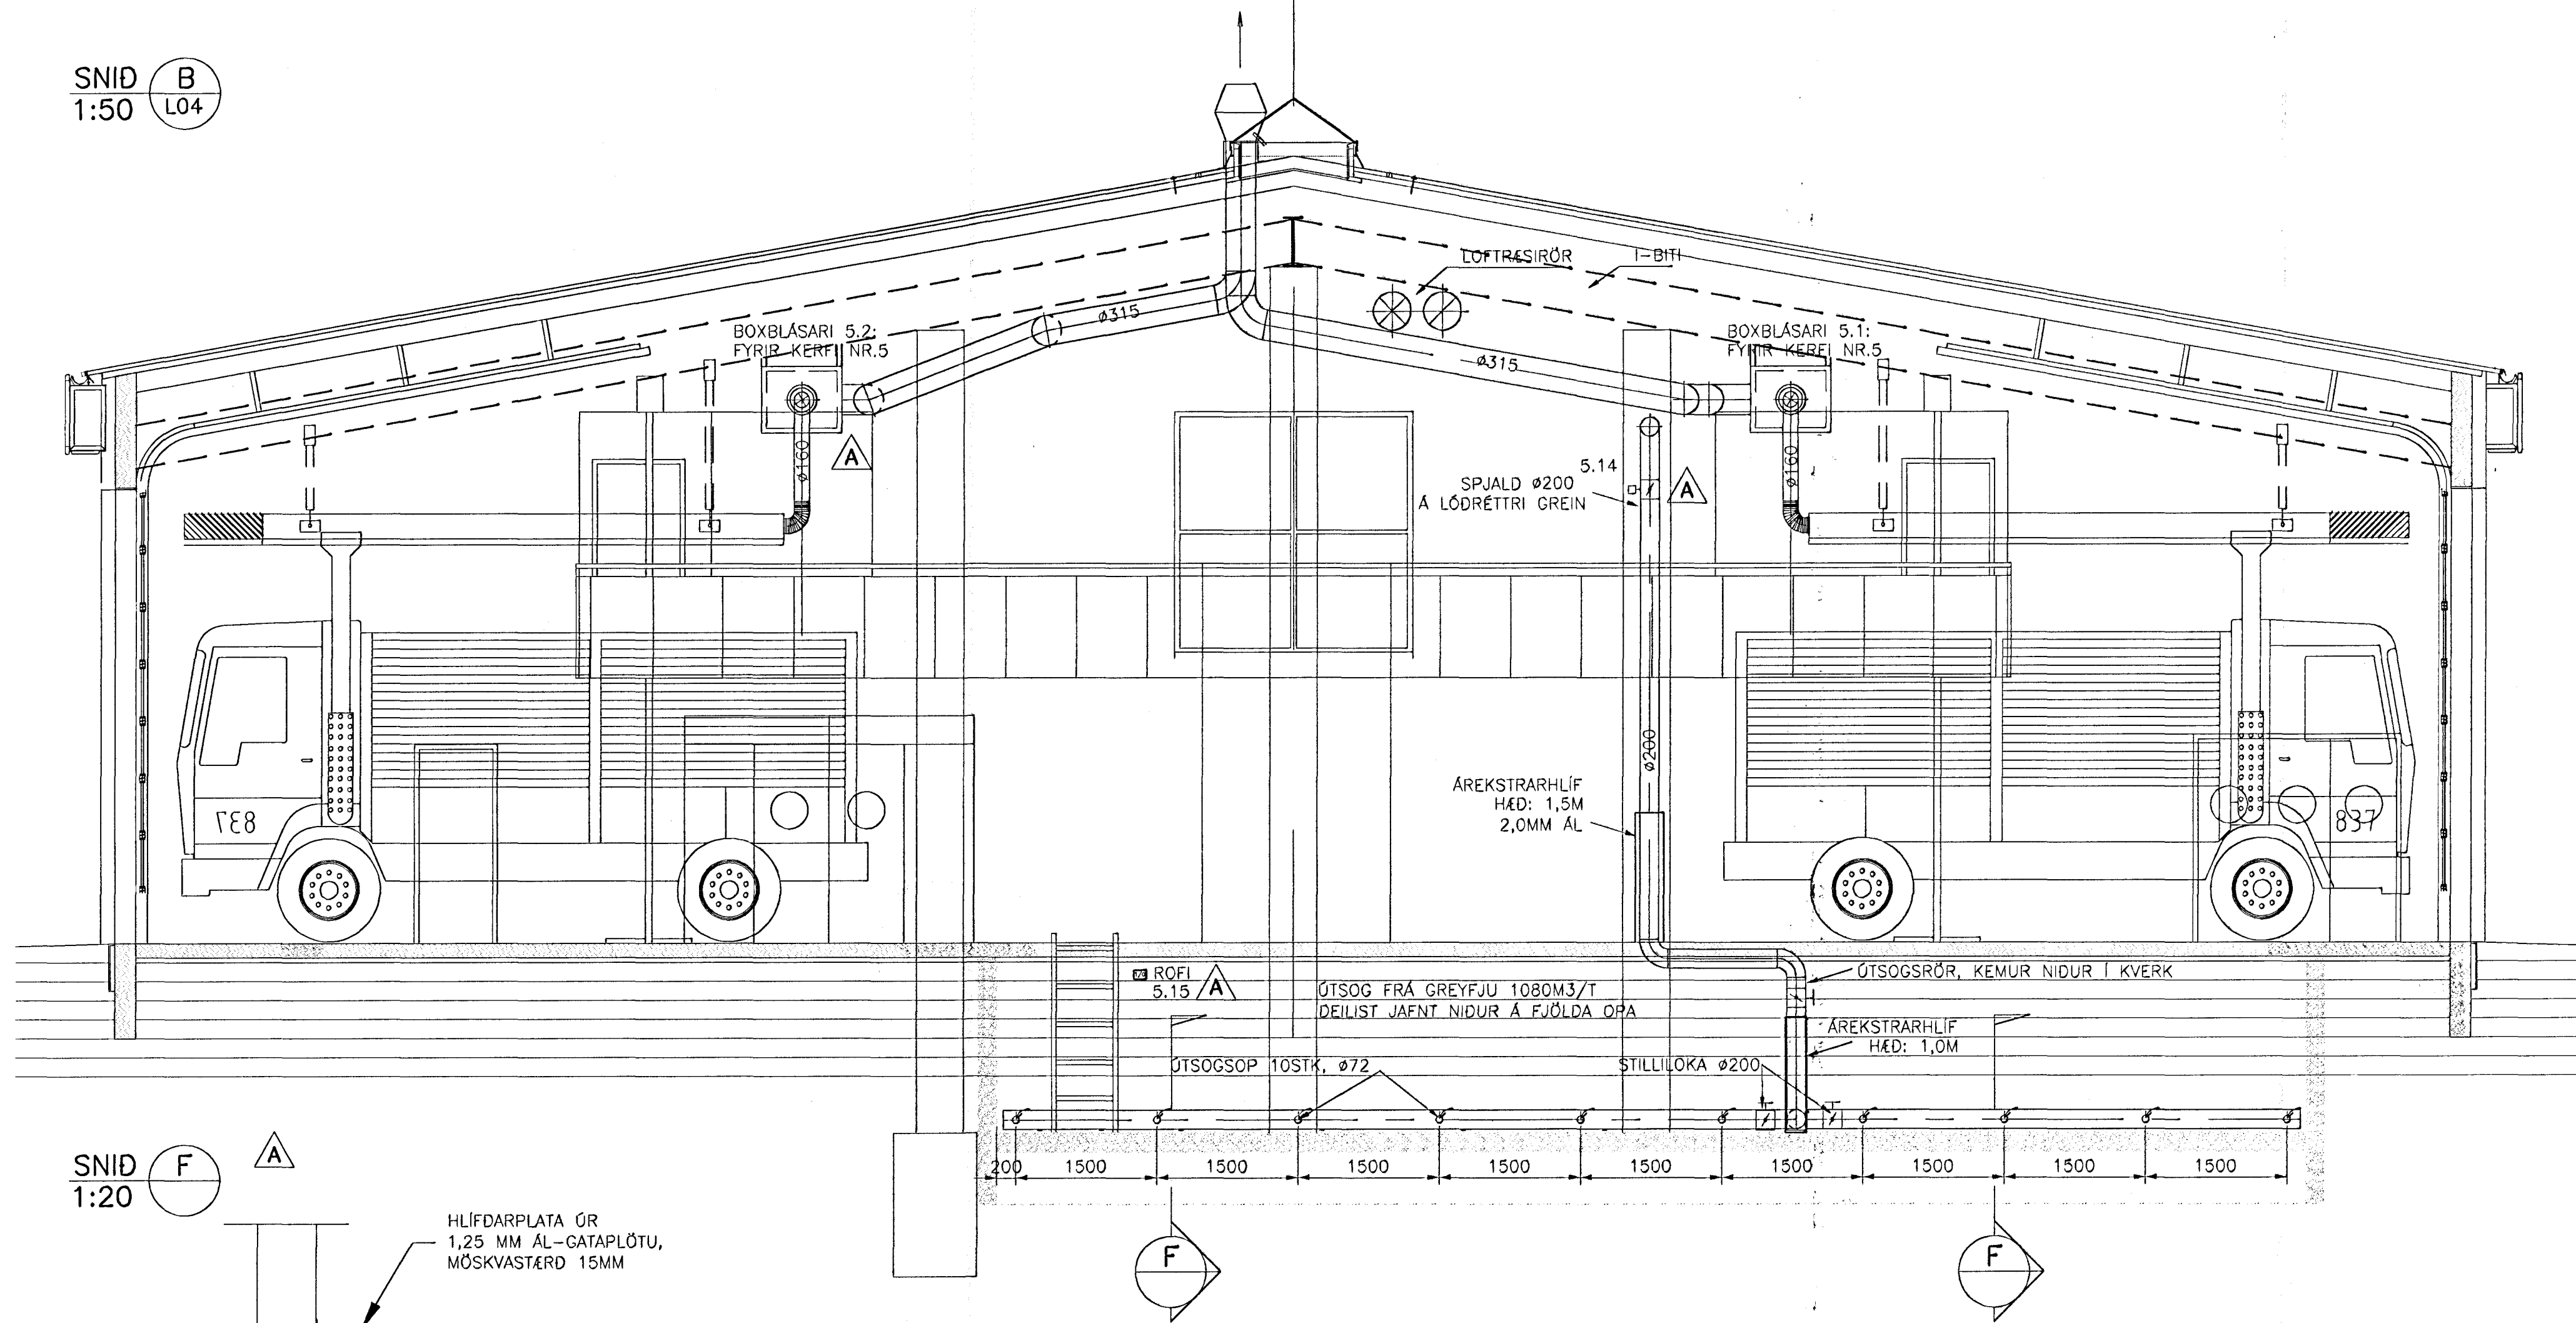

SNID F
1:20

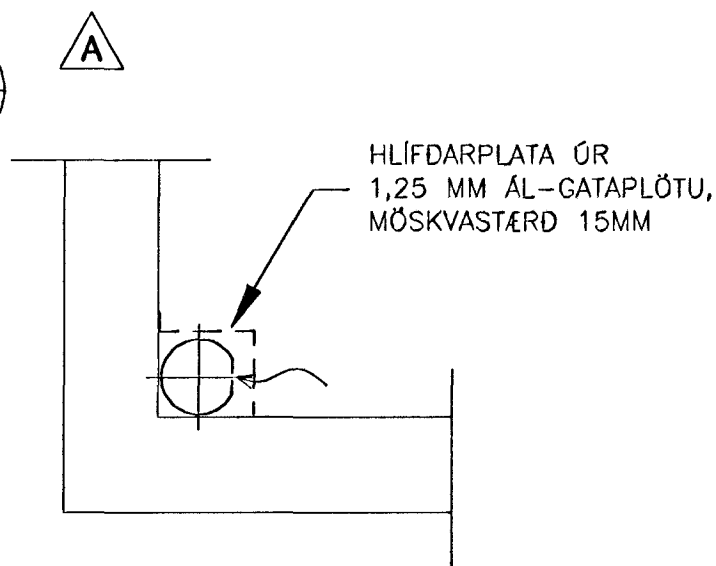

Byggingafræðingur
Alfreitur Þann
02 APR. 2002
SBJ

| | |
|----------------------------------|----------------------------------------------|
| SKÚTAHRAUN 6, HAFNARFIRÐI | |
| LOFTRÆSING SNIDMYNDR | |
| V S B VERKFRÆÐISTOFA | B: 19.03.02 INNTAK F. TÆKNIRÝMI/FRÁKASTSRIST |
| | Bræfing: A: 21.02.02 SNID B OG F |
| | Sémb.: Elfm Gústafsson |
| | Hannað: GHJ |
| | MKV: 1:50 |
| | Teknað: GHJ |
| | Daga: 18.03.01 |
| | Nr: 00812-L06B |

ANZIL302
SJB