



29/66

- FLATARMÁL 1. HEDAR BRÚTTÓ = 130,67 M<sup>2</sup>
- FLATARMÁL 1. HEDAR NETTÓ = 108,50 M<sup>2</sup>
- FLATARMÁL 2. HEDAR BRÚTTÓ = 135,67 M<sup>2</sup>
- FLATARMÁL 2. HEDAR NETTÓ = 108,50 M<sup>2</sup>
- FLATARMÁL KJALLARA BRÚTTÓ = 18,60 M<sup>2</sup>

BYGGINGAUFULTRUINN  
 HAFNARFIRÐI  
*Ólafur Þ. Þorgeirsson*

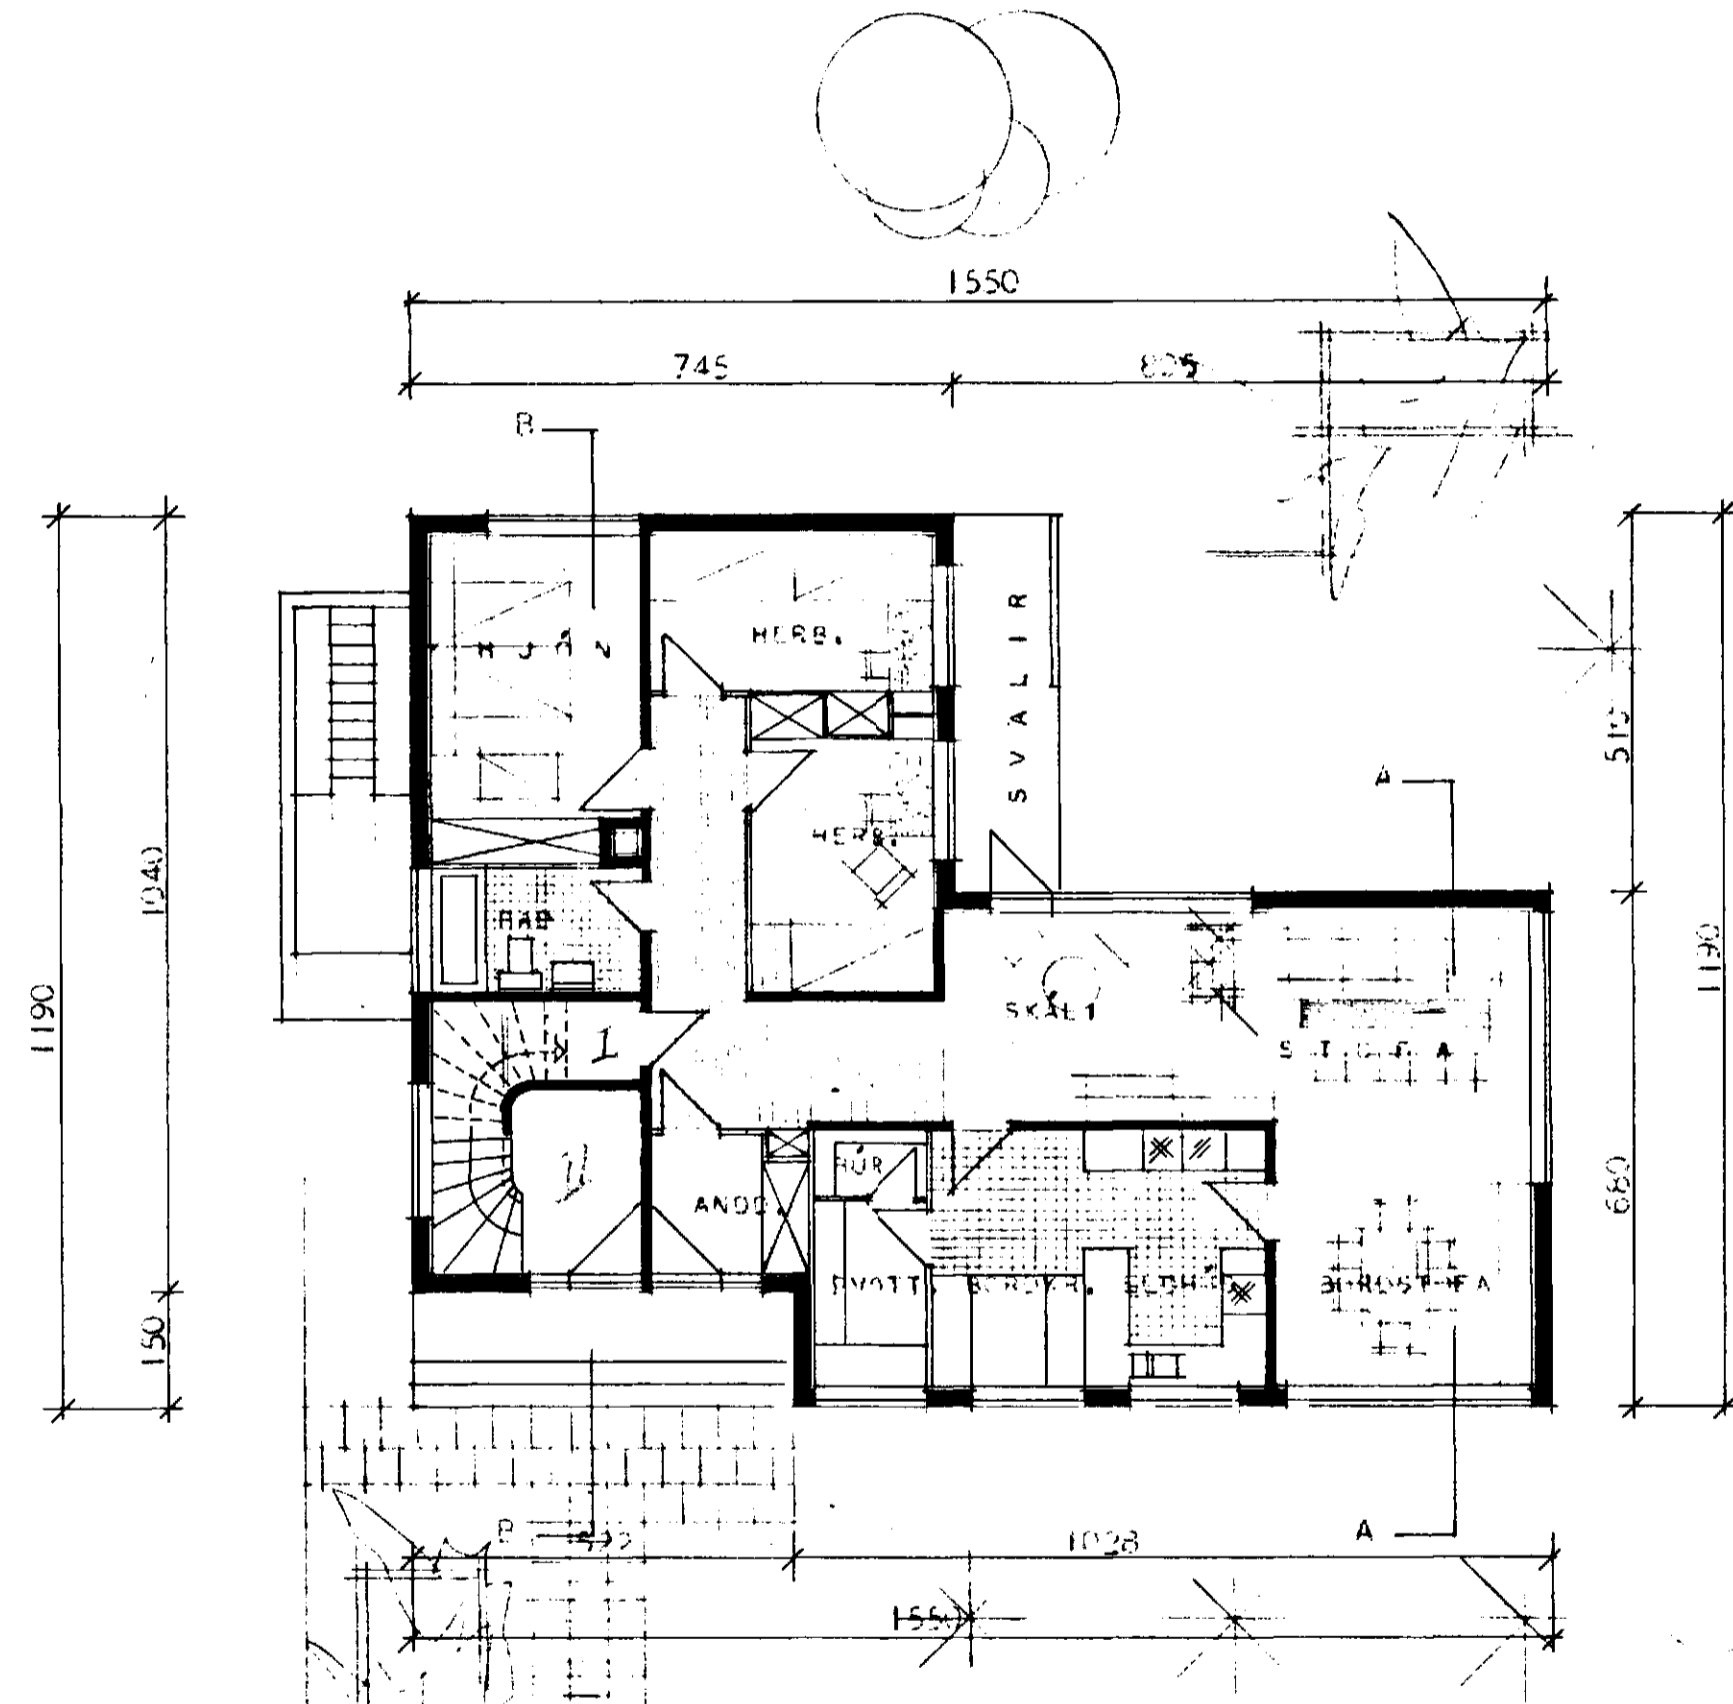

GRUNNMYND 1. HEDAR

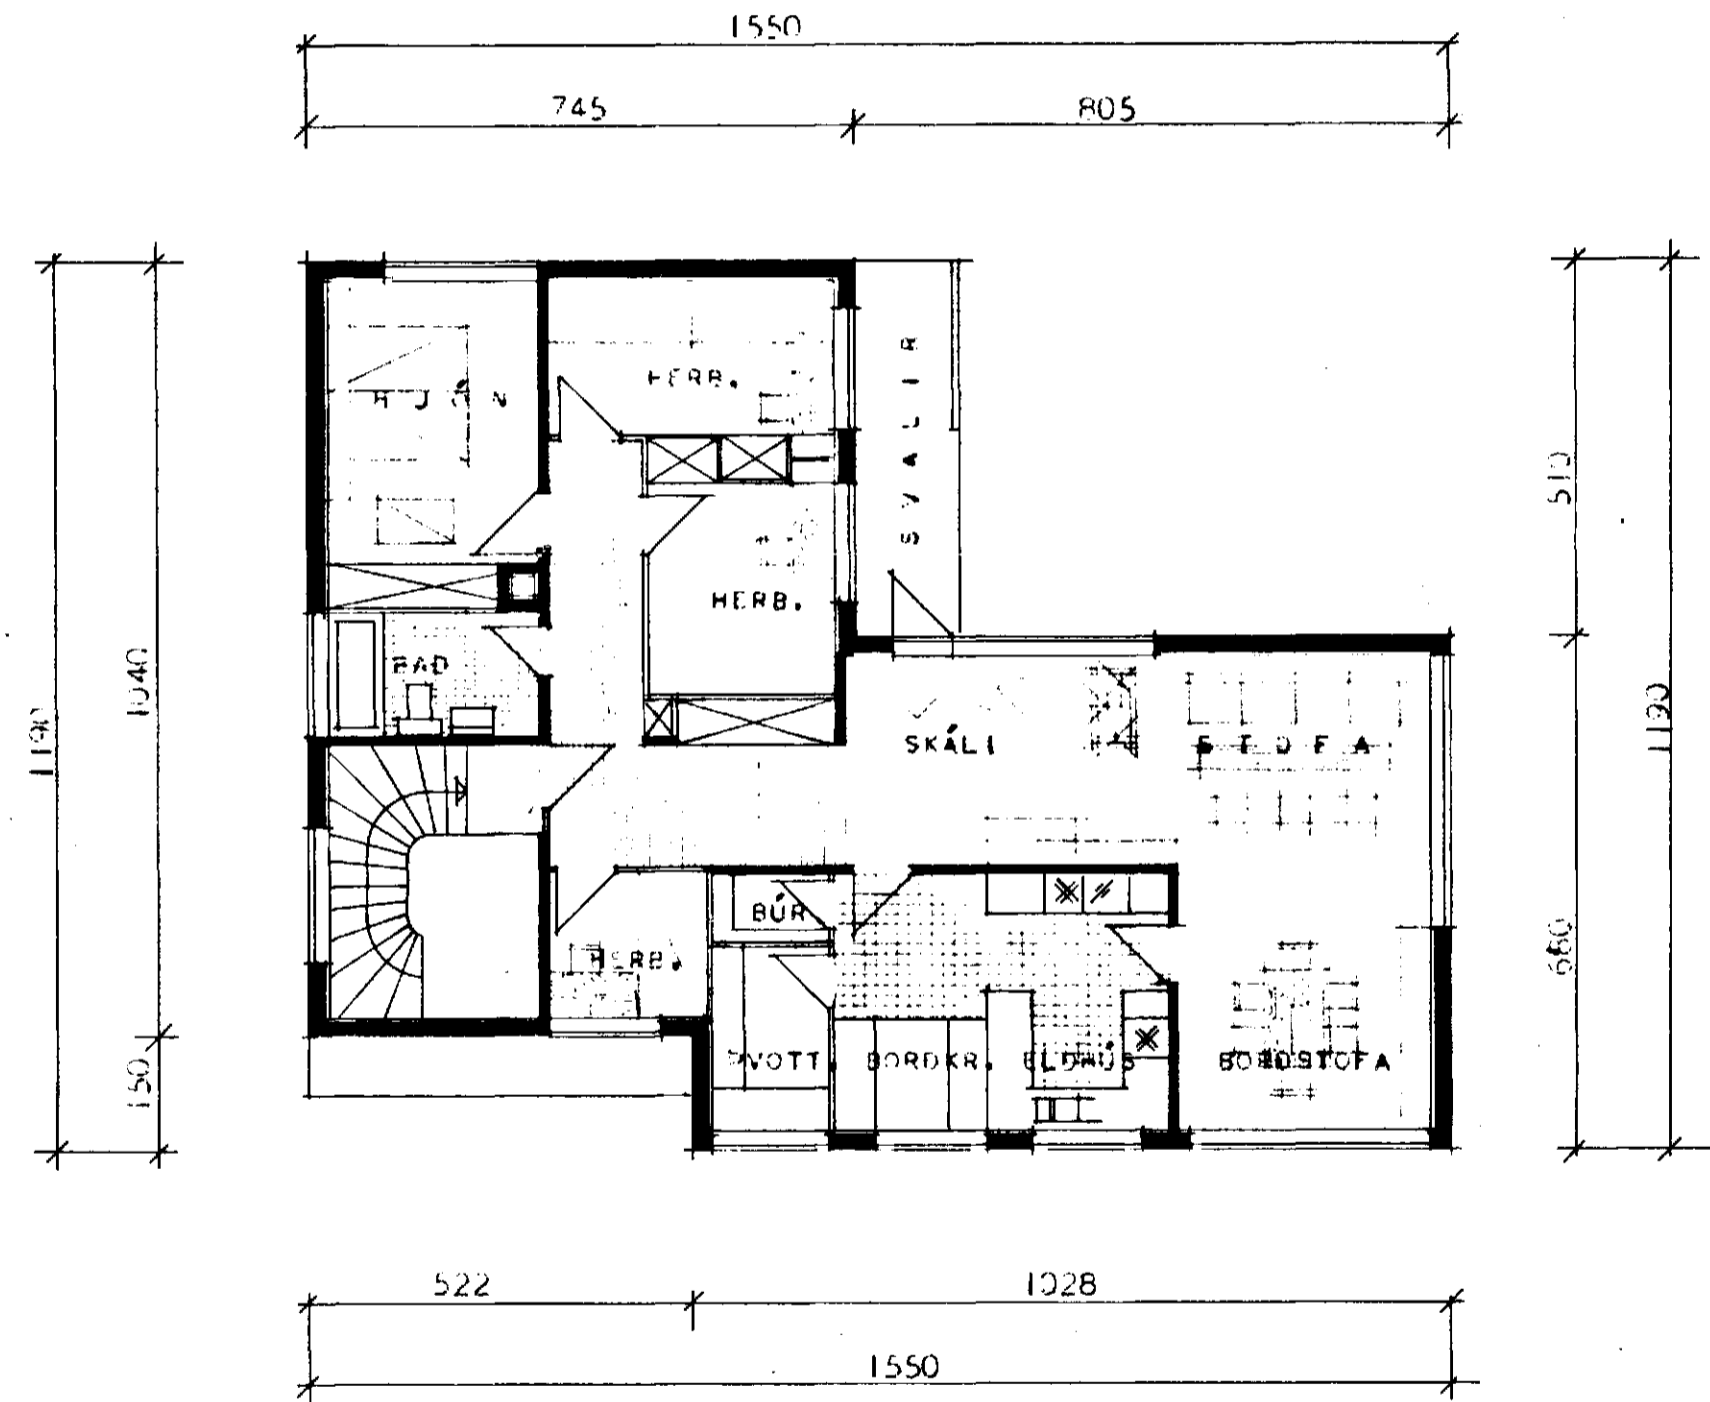

GRUNNMYND 2. HEDAR

BREYTT 1 APRÍL 1966

HÖSNÆÐISMÁLASTOFNUN RÍKISINS	
GRUNNMYNDR MÁL 1453 1/100	TVÍBYLISHÚS VERK <b>128 A</b> BLAD NR. 1 FEBRÚAR 1966
<i>Ólafur Þ. Þorgeirsson</i>	
<i>Raeldís Halldóttir</i>	