


OFNASKRA

OFN	LENGD	HÆÐ	VARMA	STAD	GERD OFNA	LENGD	HÆÐ	ÞYKKT	TAKV FRAM	OFN	MEG	VARMA	STAD
	cm	cm	kg/m	STUVA	cm	cm	cm	cm	LEIÐANDA		cm	kg/m	STUVA

Stuvar
CD
CD
AB
AD


STADSETNING STUVA

 


SKÝRINGAR:

- FRAMRENNSLI
- BAKRENNSLI
- MAGNMELIR
- SJA
- TÆMING
- RENNLOKI
- EINKSTREYMSLOKI
- HEMLE
- MOTORLOKI
- ORIGGULLA
- BLANDNAÐUR
- DANÐOSS SKAFTLOKI
- HJABTILLING

- PIPUR SVART HILDRERIN STALON
- FLETING SVARTUR RANÐFITTING
- EINANGRAN 20MM OLEMLAÐHOLKAS VAFN SJALVAPPA
- OFNLOKAR A FRAMRENNSLI O DANÐOSS HANNA SJALVAPPA HILDRERIN
- BAKRENNSLI O DANÐOSS EINN O SKYRST AF HITASTAR BAKRENNSLI
- OFNAR STALONIAN PROFURUM O O KOSTUM LOKISKILUM O OLLUM VAFNA
- PROFURUM LOKUM VAFN VAFNA O O KOSTUM SEM SKA STADUR O TÆMING
- AN. BÆÐ O TÆLLA

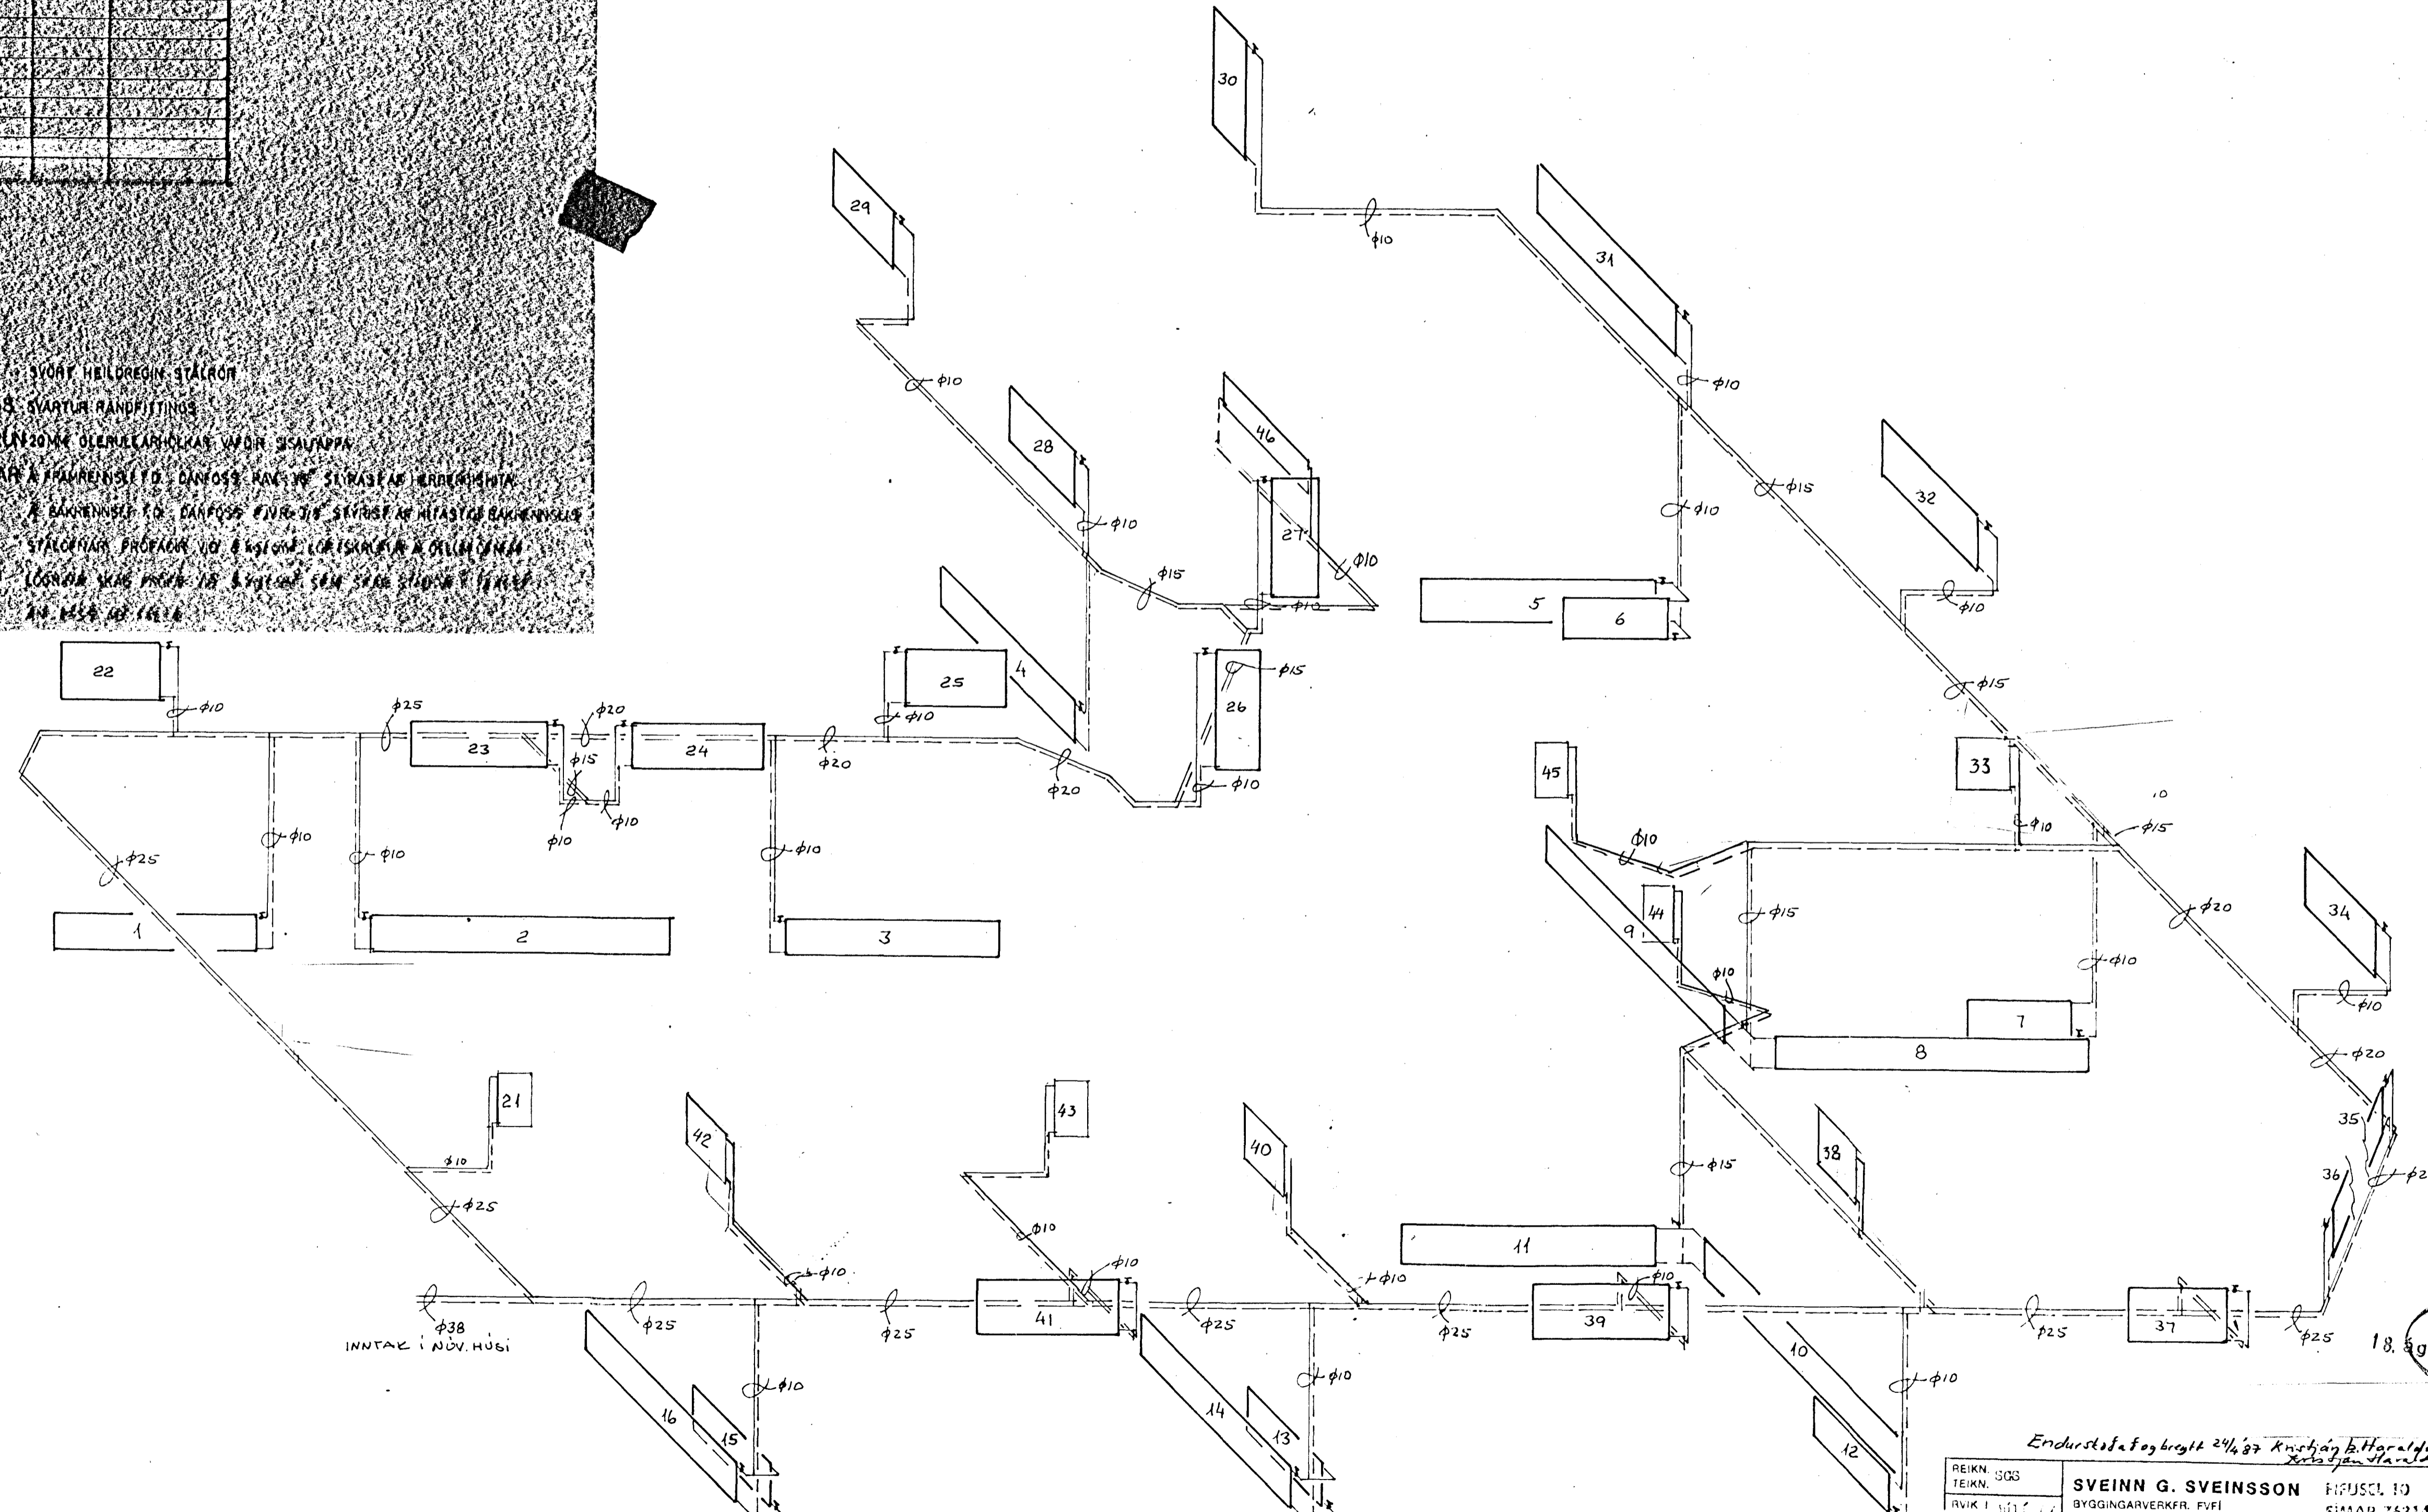

INNTAK I NOV. HUGI

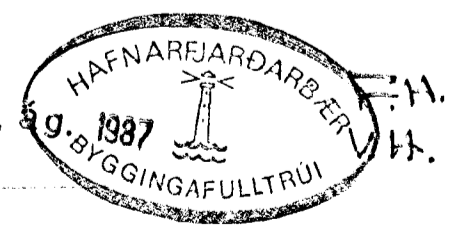


REIKN. SÖS	SVEINN G. SVEINSSON	FRJUSCL. 10	BR.
TEIKN. 1. 11. 87	BYGGINGARVERKFR. FVFI	SÍMAR 76214, 56660	VERK. HIL.
	SMARINAVÖRUR 2, HAFNARFIRÐI		MELKV. 1:50
	nitalsg., rúmynd		TEIKN. HIL. 27