



SÉRMYND A + 1:10

GRUNNMYND + 1:50


Sjá skilningu B í bláh. m. 103

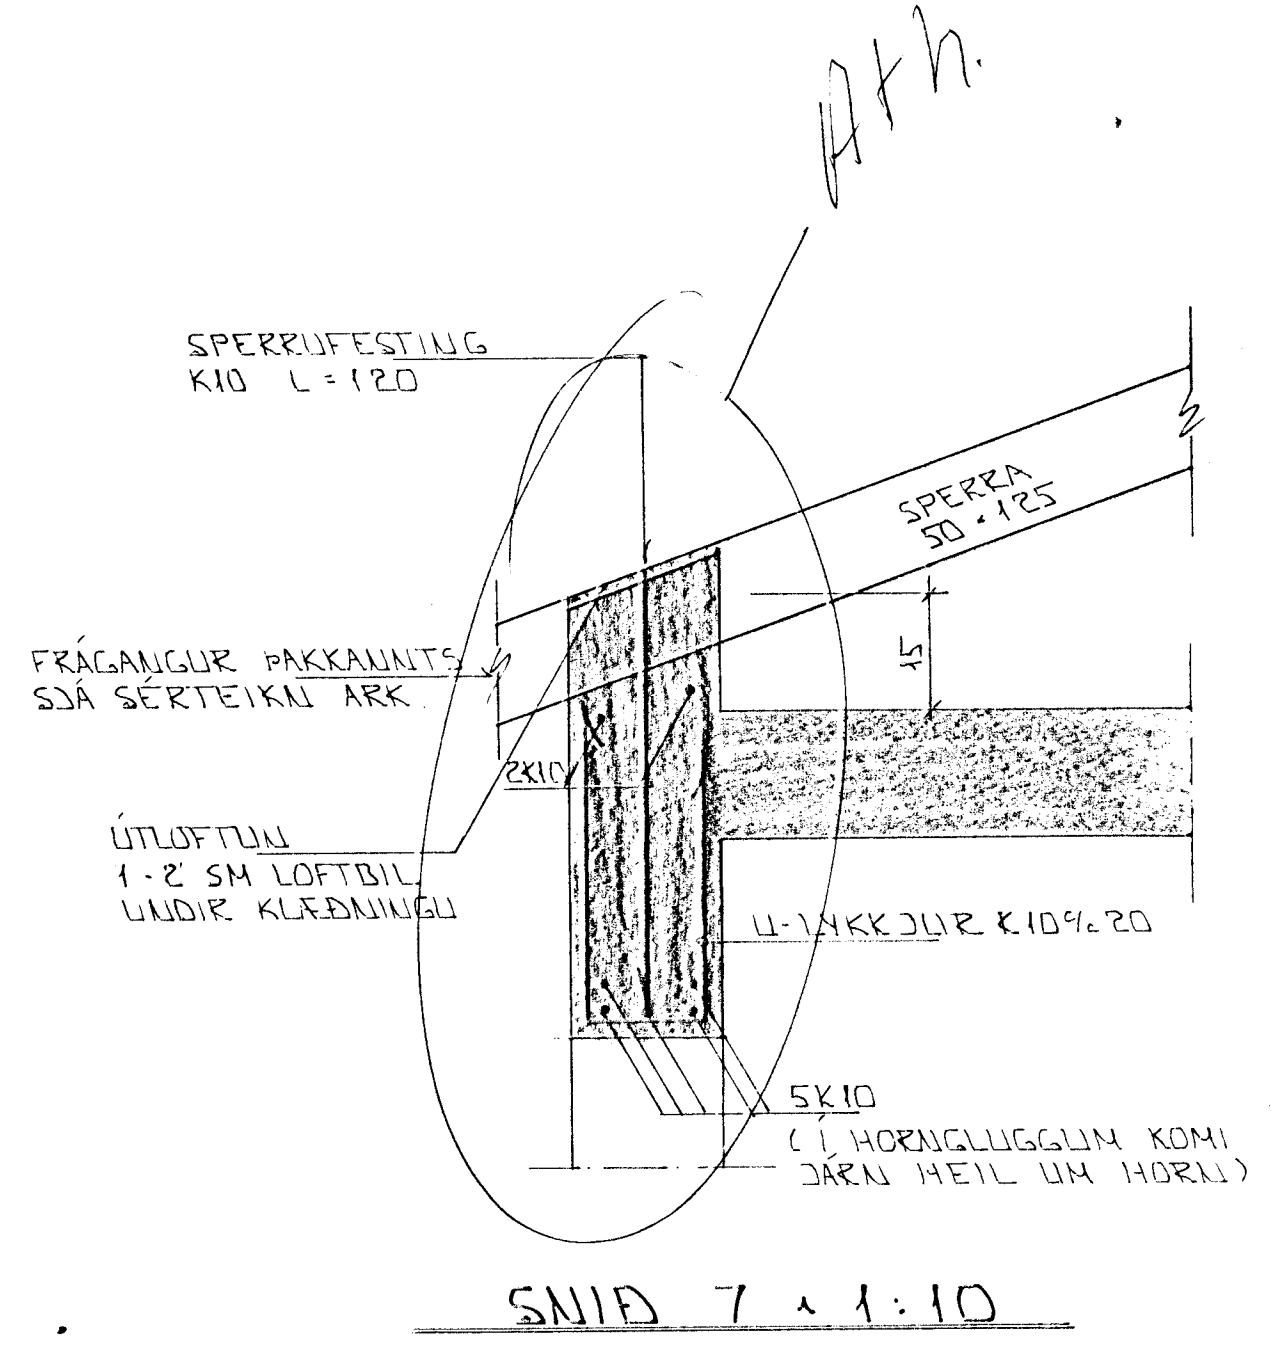

SNID 7 + 1:10

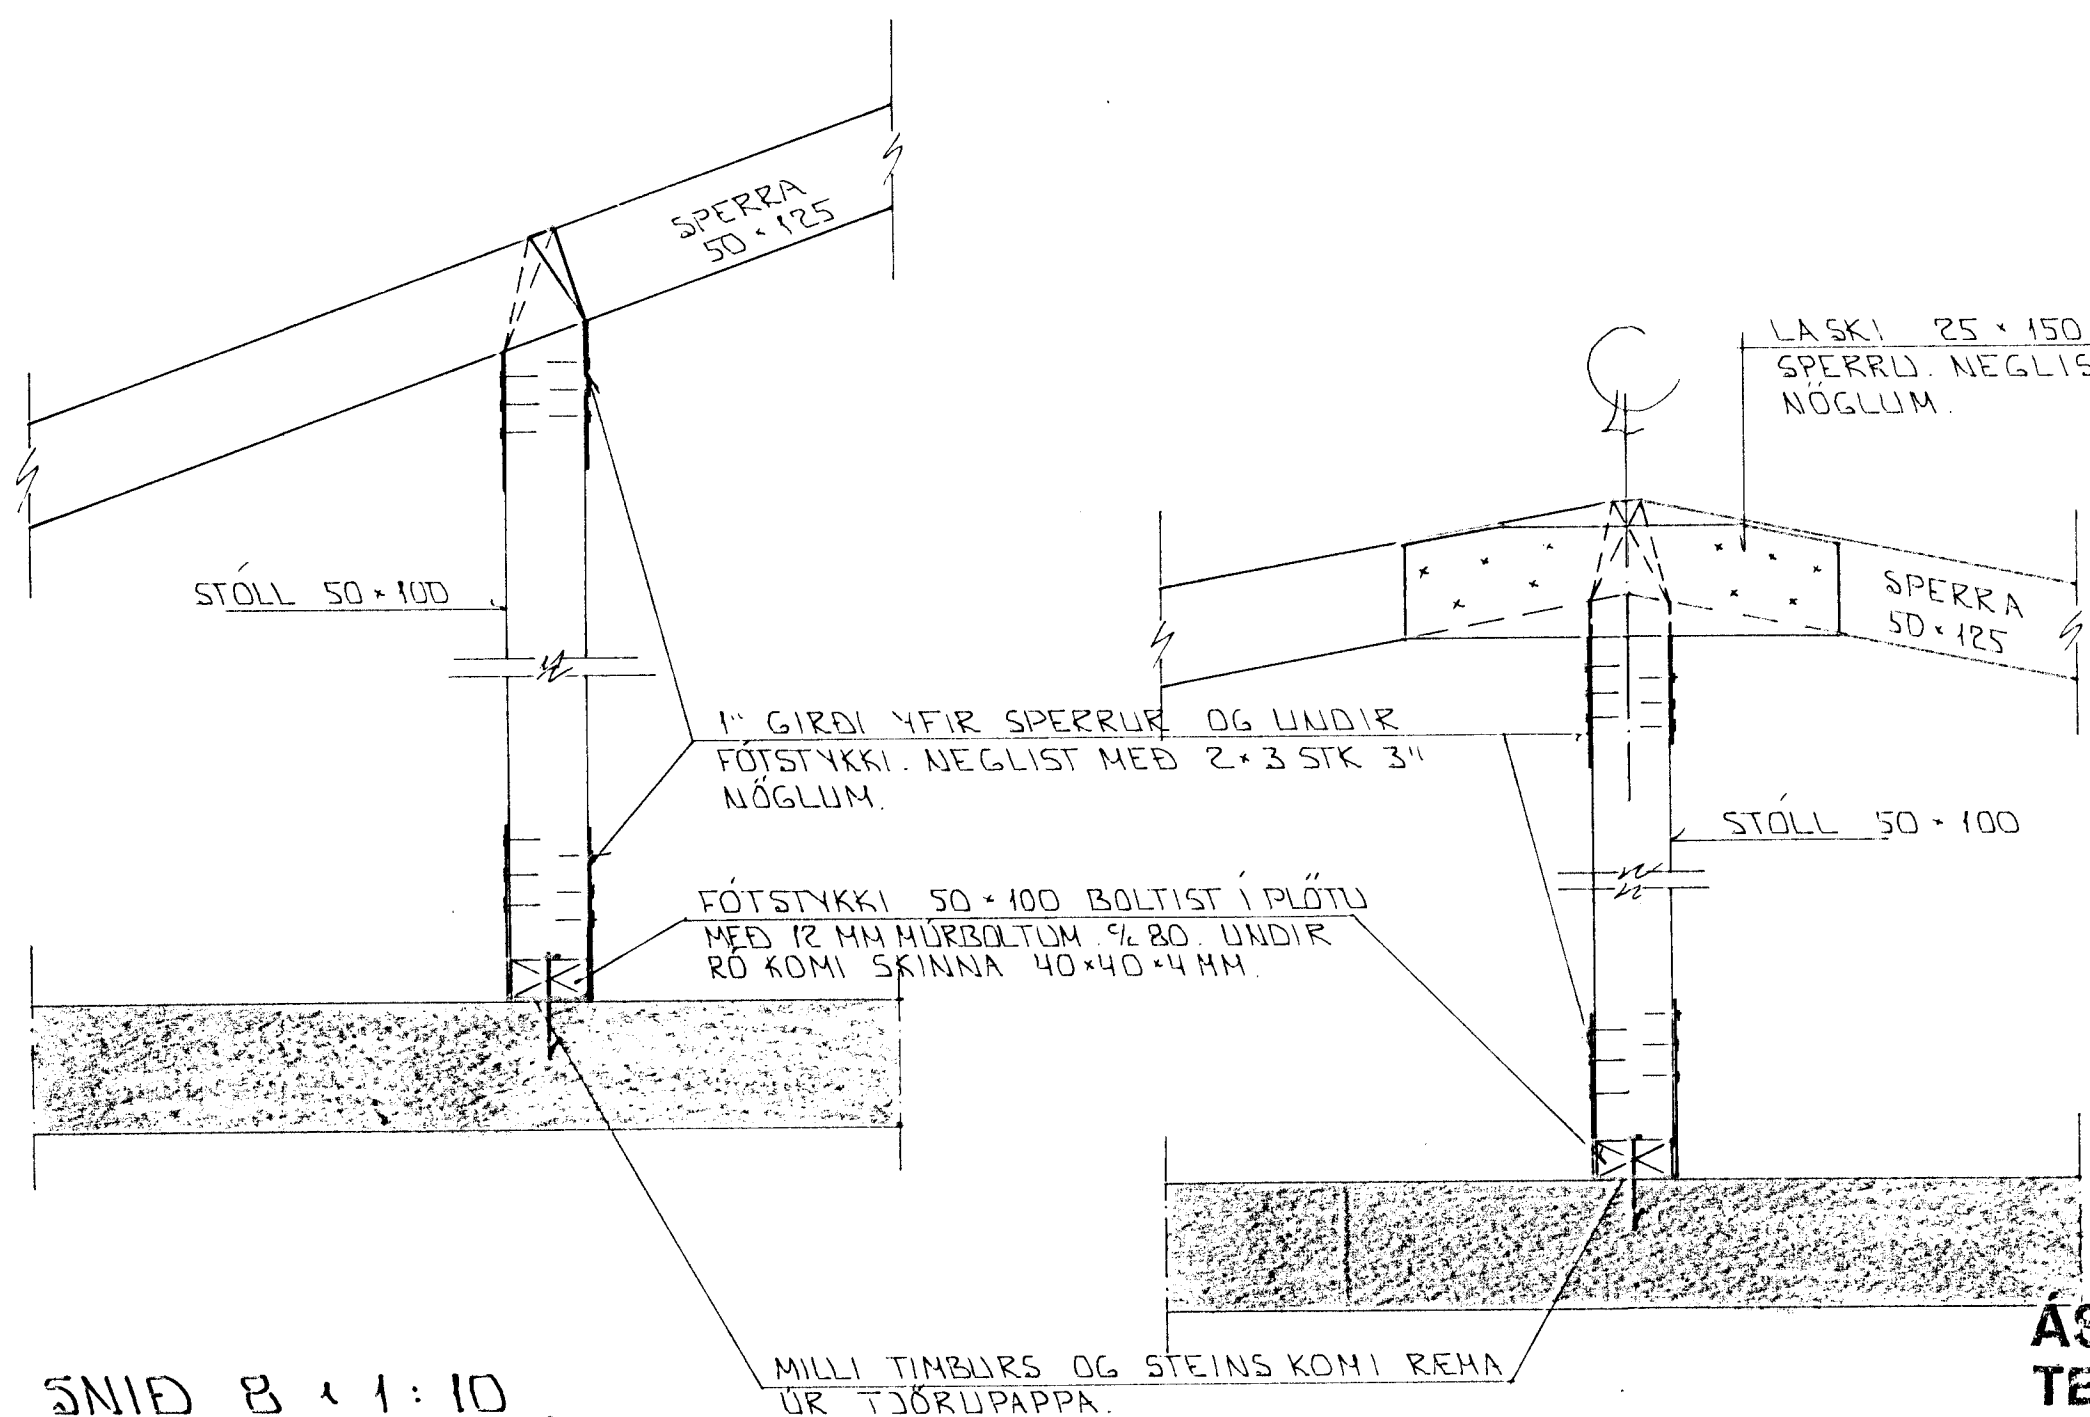

SNID 8 + 1:10

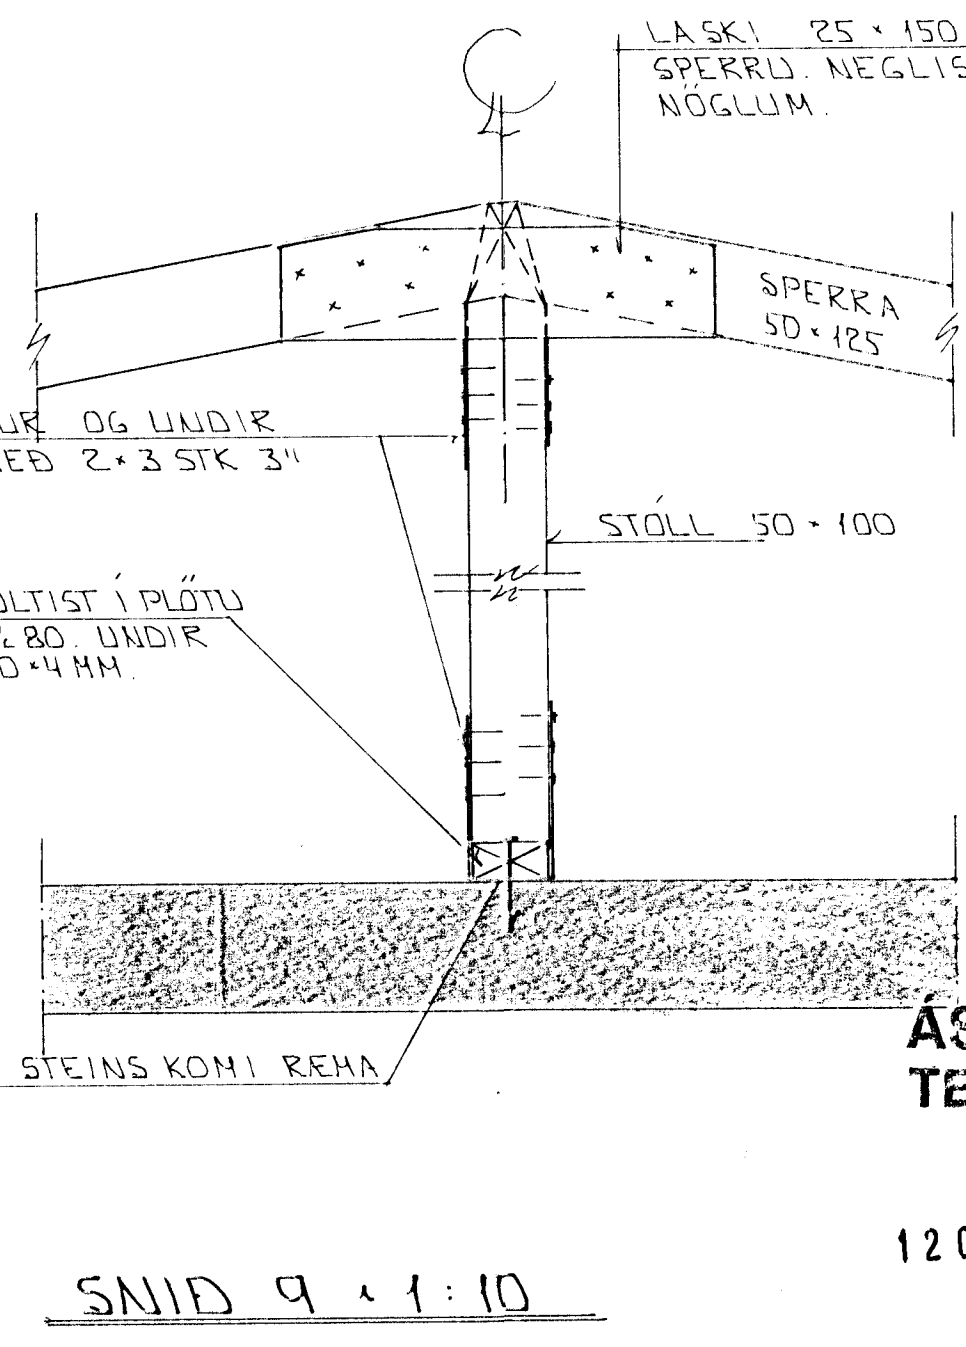

SNID 9 + 1:10

ASKILID, ELÐRI
TEIKNING ÓGILD
HAFNARFJÓRÐUR
BYGGINGAFLUTRUM
12 OKT. 1994

DI	04.10.94	SNID 7 SF	GH
BR	DAGS	EDLI BR	SIGN
SÓLEYJARHLÍÐ I HAFNARFIRÐI			
PAKVIKKI - SNID			
MKV + 1:50			
DAGS SEPT 94			
VERK NR. 9434			
TEIKN NR. 1-6			
HANNAD			
TEIKNAD GH			
YFIRFARIÐ			
STRANDGÖTU 11 - 220 HAFNARFJÓRÐUR - Sími 54255 - FAX 652875			