


1. HÆÐ GRUNNMÝND, 1:50

ÁSKILIÐ, ELÐRI  
TEIKNING ÓGILD

16 SEPT. 1994

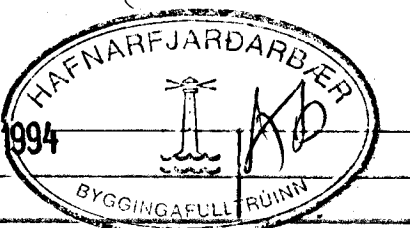

BR.NR.	DAGS	EDLI BREYTINGAR	SIGN.
			DAGS. ÁGUST 93
			HAUNAD <i>PH</i>
			TEIKNAD <i>GT</i>
			VERK NR. 9334
			BLAD NR. 2-03

MELIKV. 1:50

SIGURÐUR ÞORLEIFSSON TEKNIFRÆÐINGUR F.T.F.I.

STRANDGÖTU 11 HAFNARFJÖRÐI SÍMI 54751/54255