


*Sigurður Ólafsson 071070-5069*

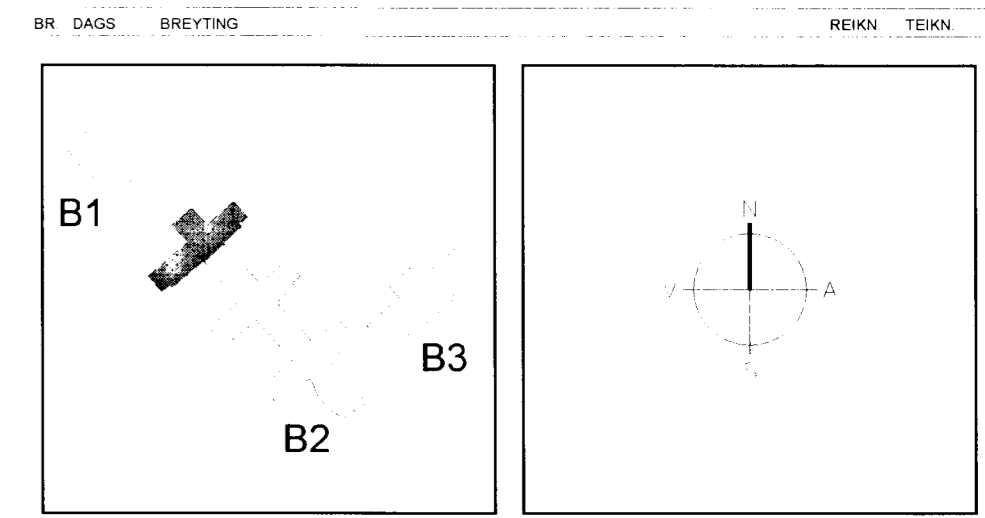

**ARKITEKTAR**  
 HINNAR E. SÆMUNDSEN  
 INGBLÖG KRISTJANSDÓTTIR  
 MARGRÉT SIGURDÓTTIR

**LANDMÖTUN**  
 VÍSÓ

**SÖLVANGSVEGUR 4  
 LÆKJARSKOLI**

SKÓLABYGGING  
 1. ÁFANGI, REYNDARTEIKNING  
 GRUNNMYND 1. HÉÐAR

HANNADEIKN SÓUS  
 ATH. FB  
 SAMÞYKKT  
 KT 662589-1399  
 REYKJAVIK 02.08.2002