





Samþykkt þann

15 FEB. 2000


Byggingafulltrúinn í Hafnarfirði
Erlendur Hjálmarsson

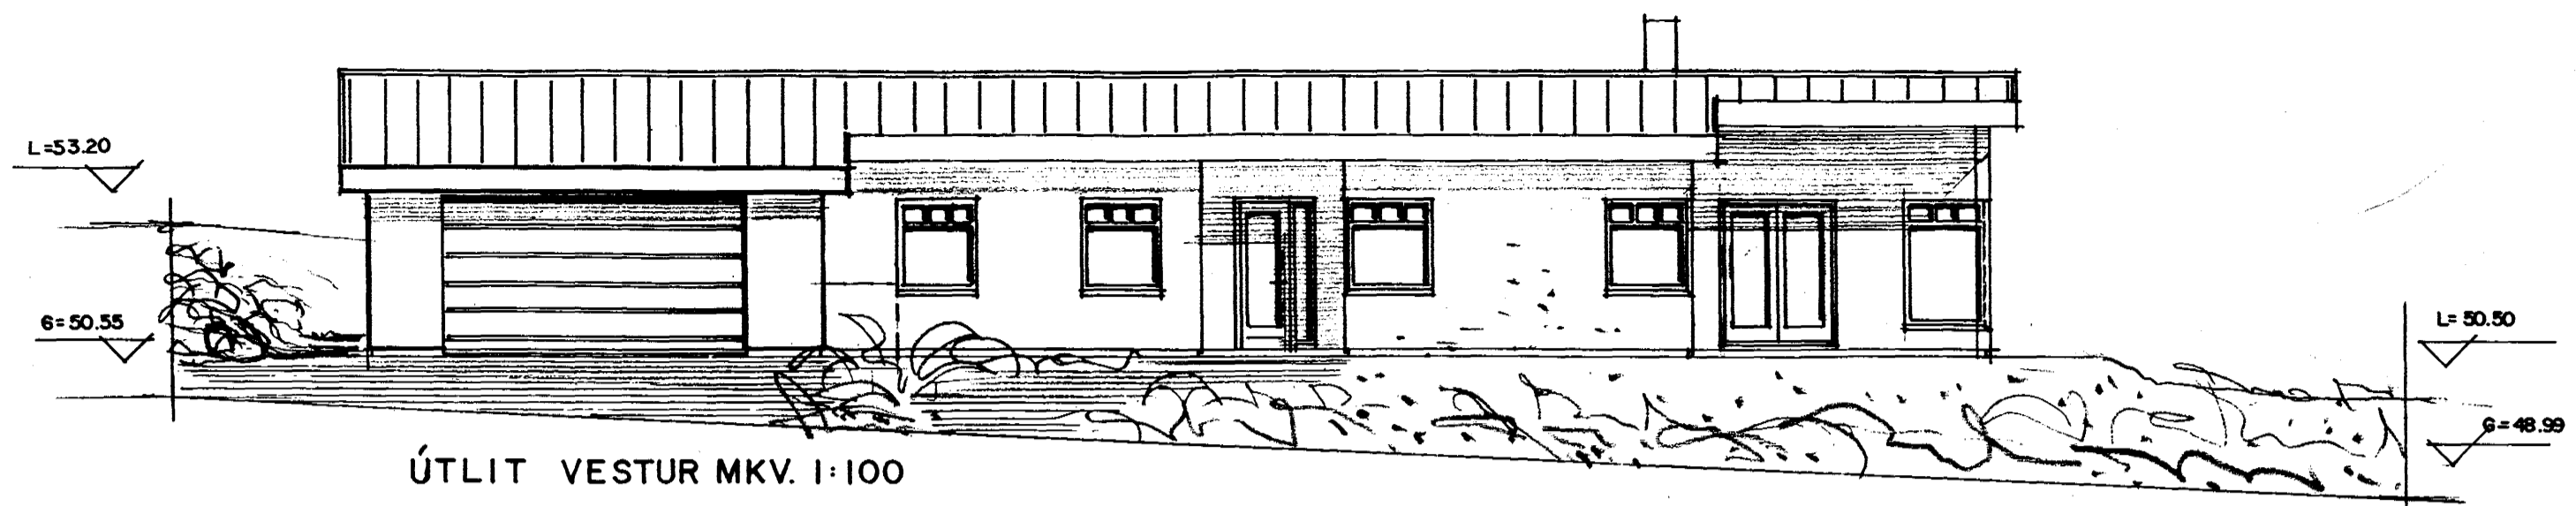


ÚTLIT VESTUR MKV. 1:100

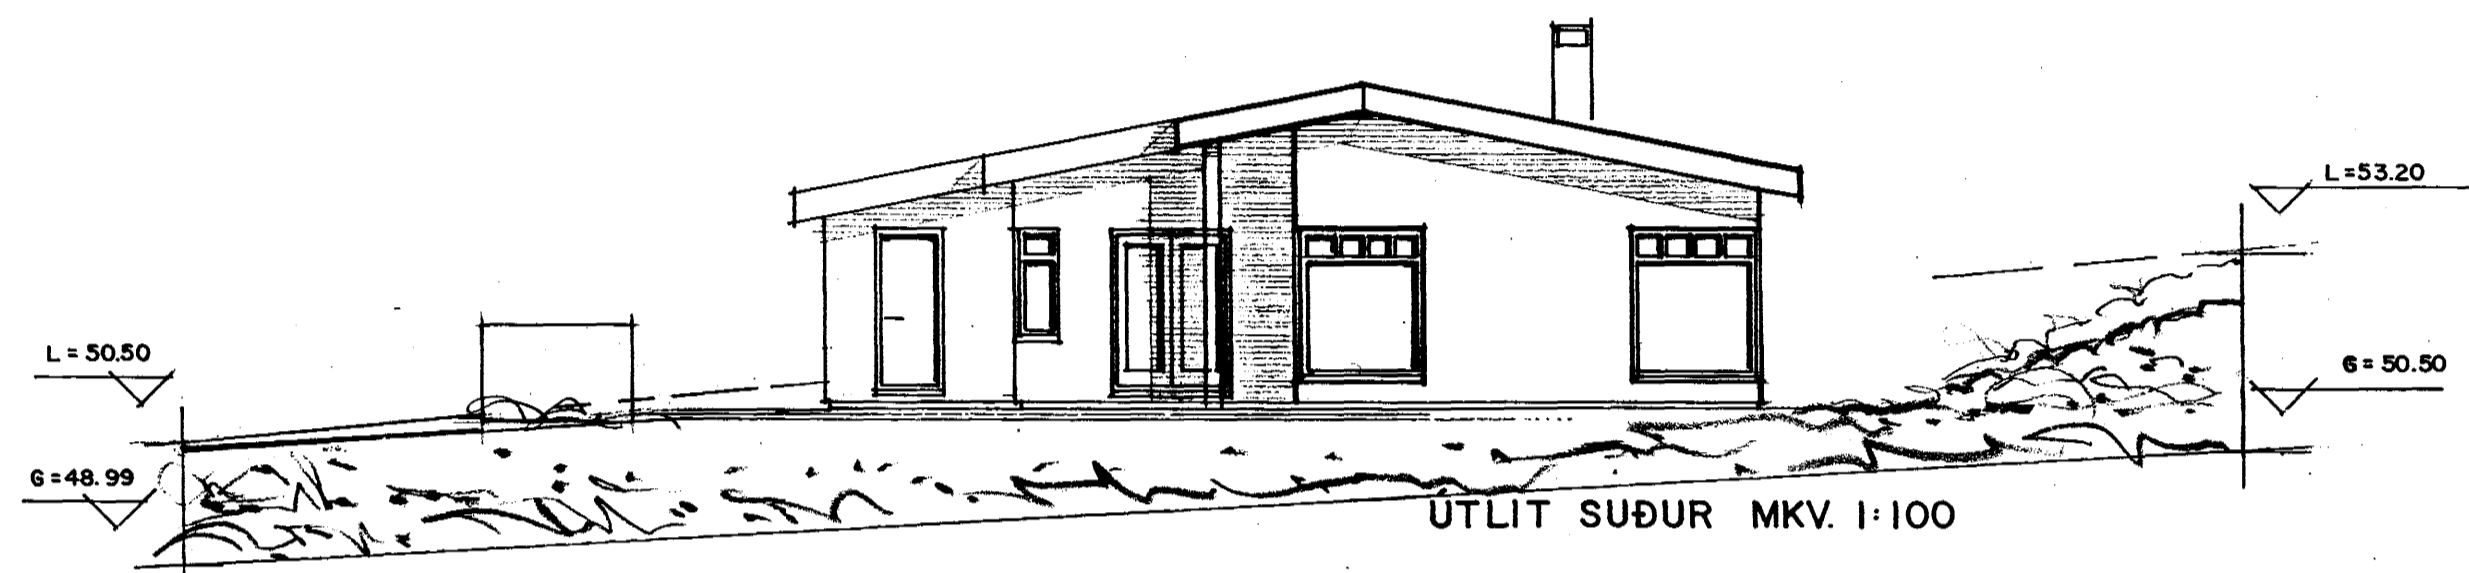

ÚTLIT SUÐUR MKV. 1:100

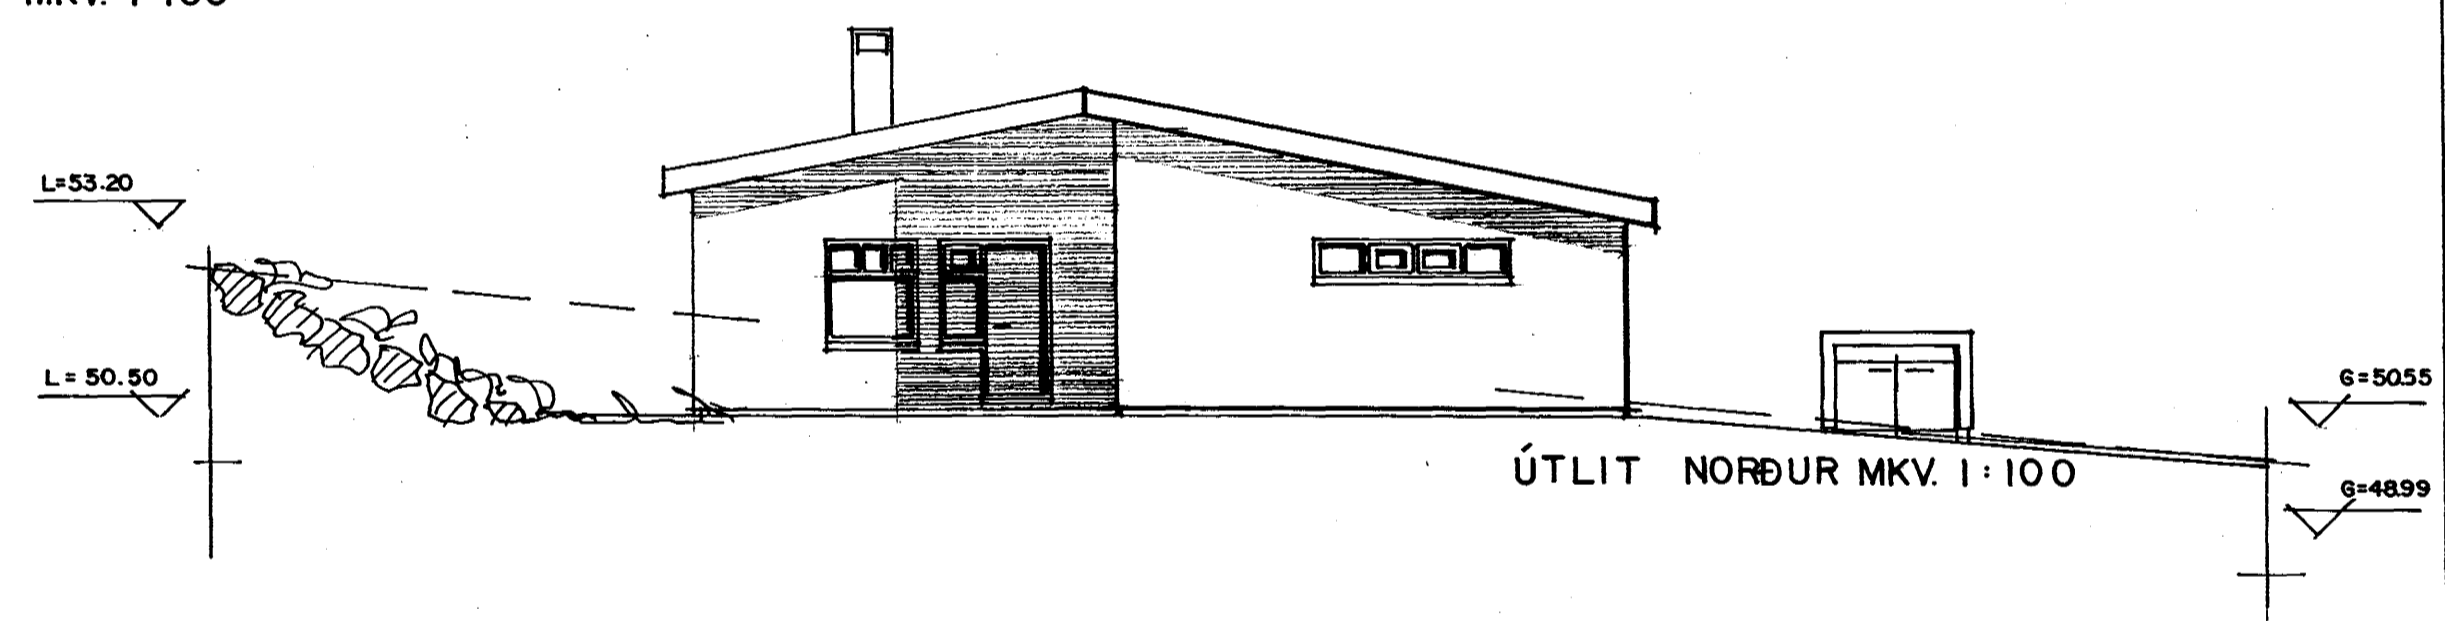

ÚTLIT NORÐUR MKV. 1:100

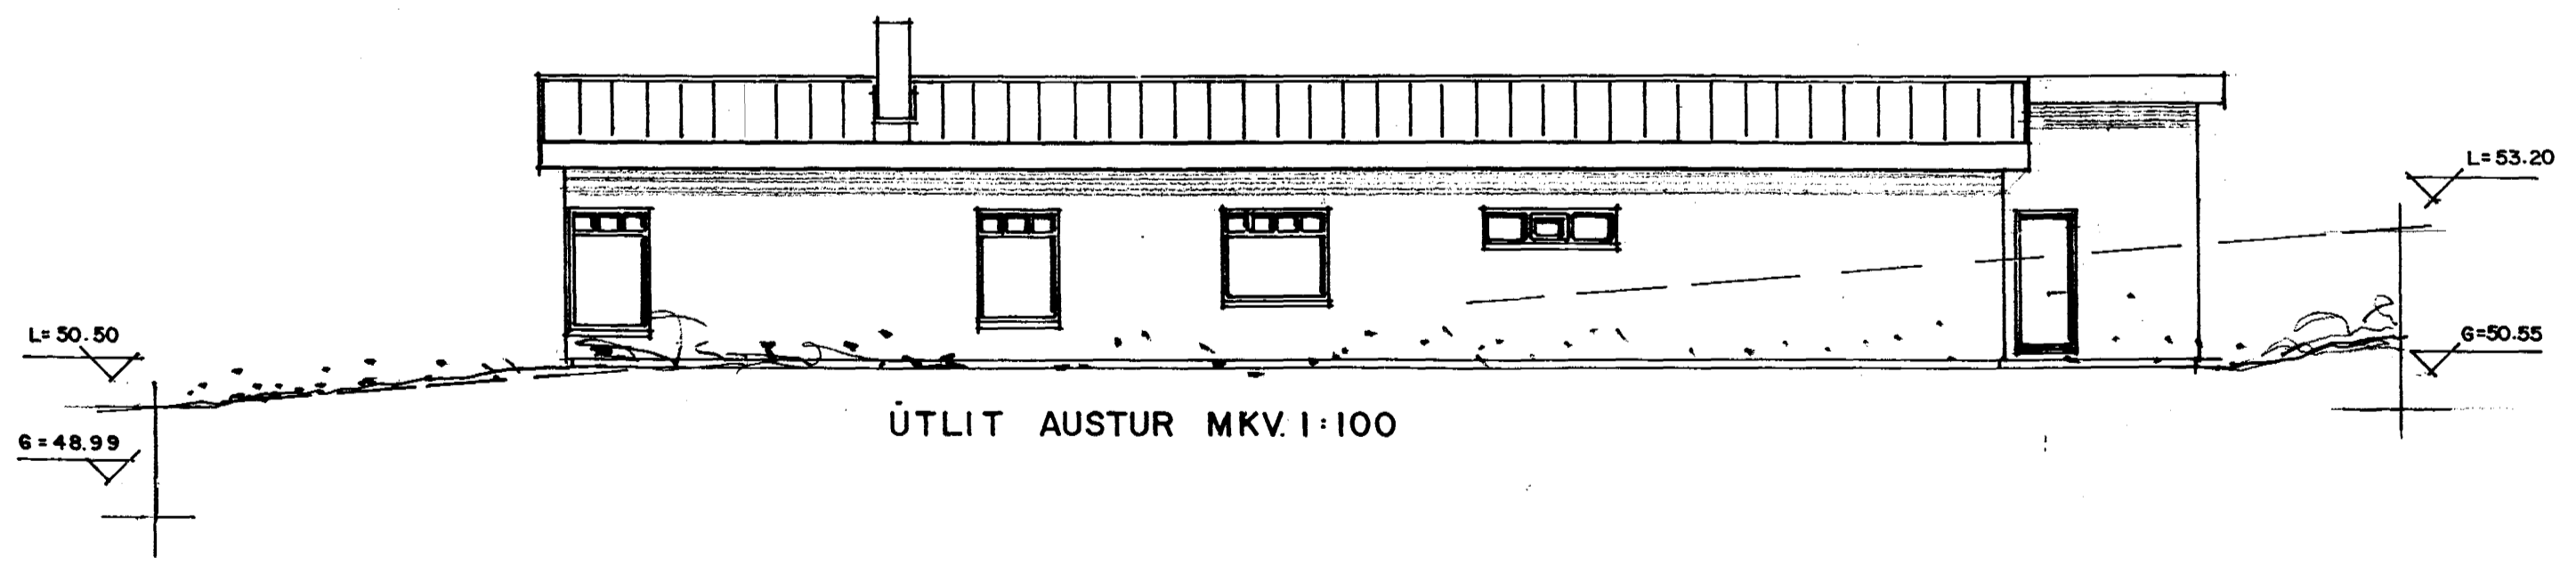

ÚTLIT AUSTUR MKV. 1:100

1) BREYTT STÆRÐUM, ÚTLITI OG HÆÐARKÓTA *GH*

Spóaás nr. 24

Dags. Okt. 1999

Breytt: (3,02,2000 1)

Útlit Mkv.1:100.

Gústaf B. Ólafsson m.b.f. kt. 200759-7619

Ólafsson 14.02.2000