




**A** A\* SNID  
02 03 M. 1:20

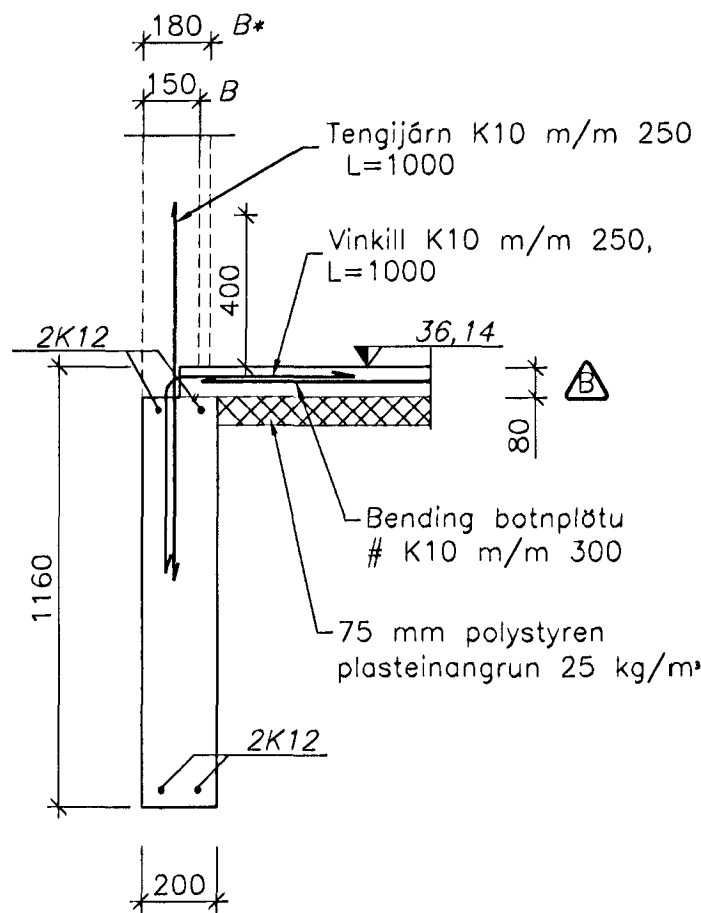


**B** B\* SNID  
02 03 M. 1:20

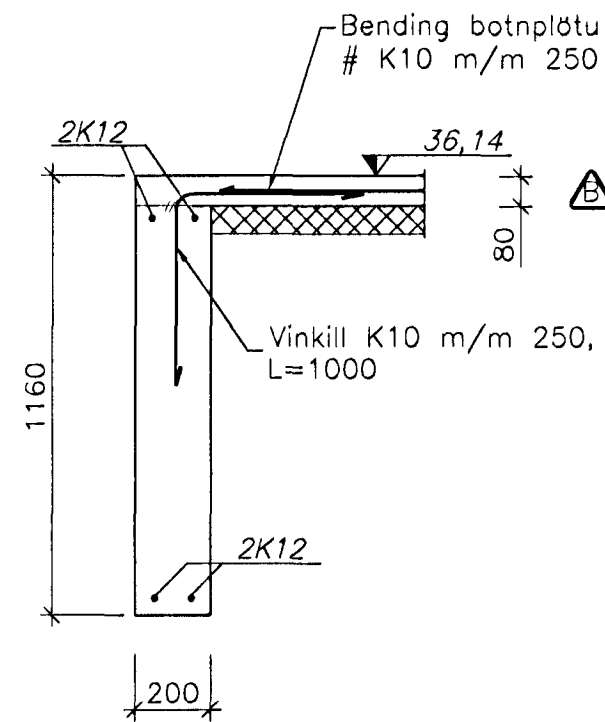

**C** SNID  
02 03 M. 1:20

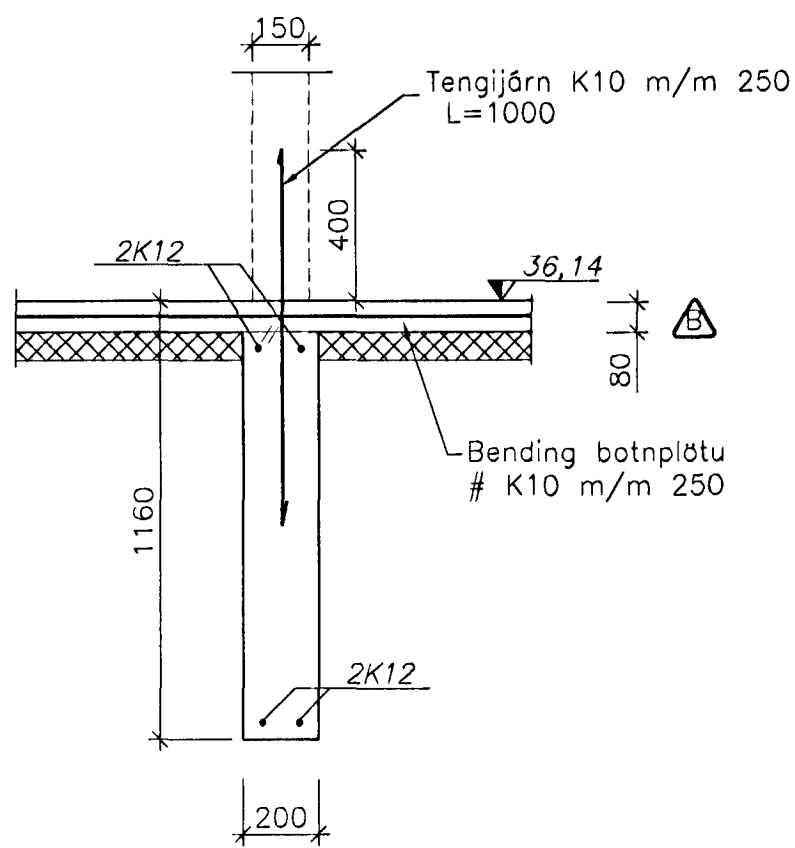

**D** SNID  
02 03 M. 1:20

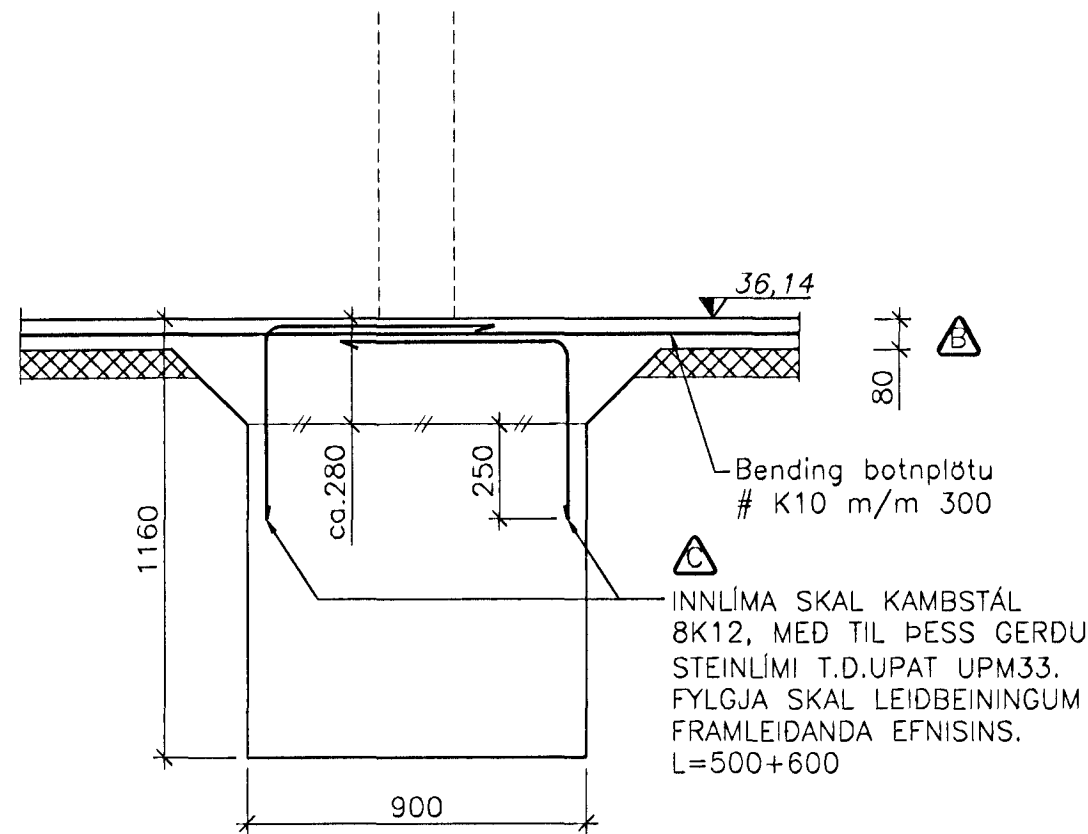

**E** SNID  
02 03 M. 1:20

Byggingaútlitun Hafnarfjarðar  
Algreitt þann  
28 MARS 2000  
Sigurbjartur Halldórsson

SKÝRINGAR OG FLEIRA SJÁ BLAÐ NR. 01

	SPÓAÁS 8, HAFNARFIRÐI		
	UNDIRSTÖÐUR SNID		
VERKBJÓNUSTA KRISTJÁNS EHF			
Reykjavíkurvegur 68, 220 Hafnarfjörður Sími 5652100 Fax 5654050			
Hannað: KS	Teiknað: ASP	Mælikv.: 1:20	Verk nr.: 901
Nr.	Dags:	Breyting:	Af: Samb.
		Dags.: 3.11.'99	Flokkur: B SU Blað nr.: 03C

C	5.2.2000	Breytt sniði	ASP
B	24.1.2000	Breytt plötubykk og kóta	ASP
A	16.11.'99	Einangrun utan á sökkla	ASP
Nr.	Dags:	Breyting:	Af: