

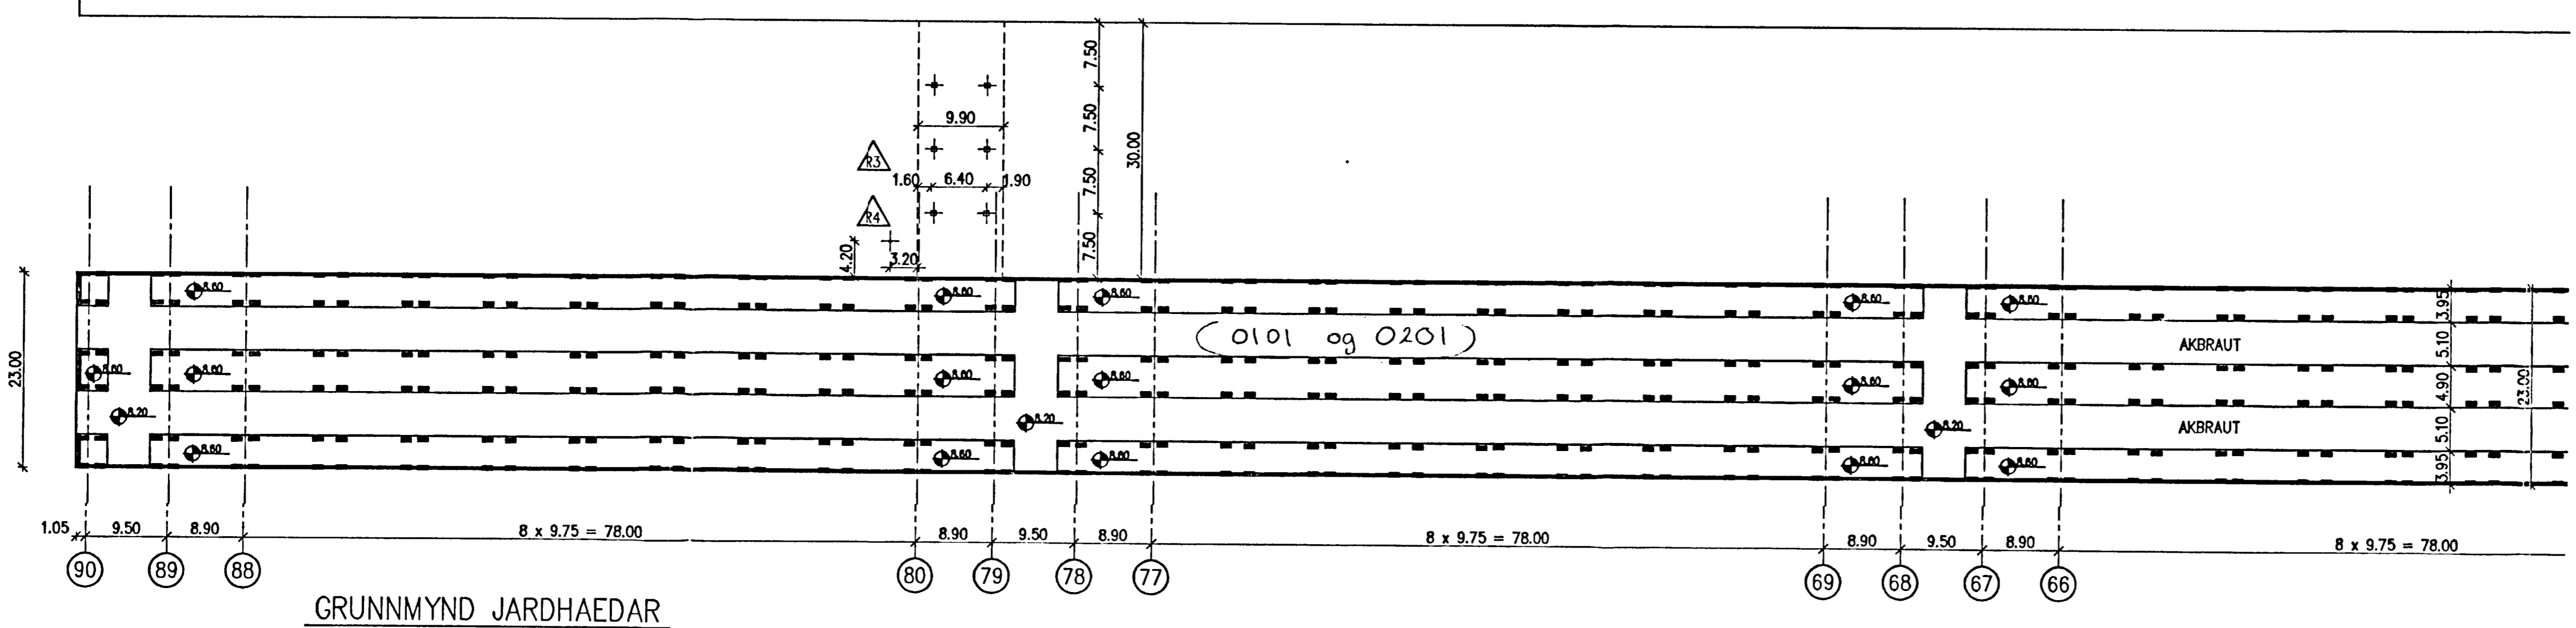



Samþykki þann  
 9. 6. SEPT 2003  
 Erlingur Þorvaldursson

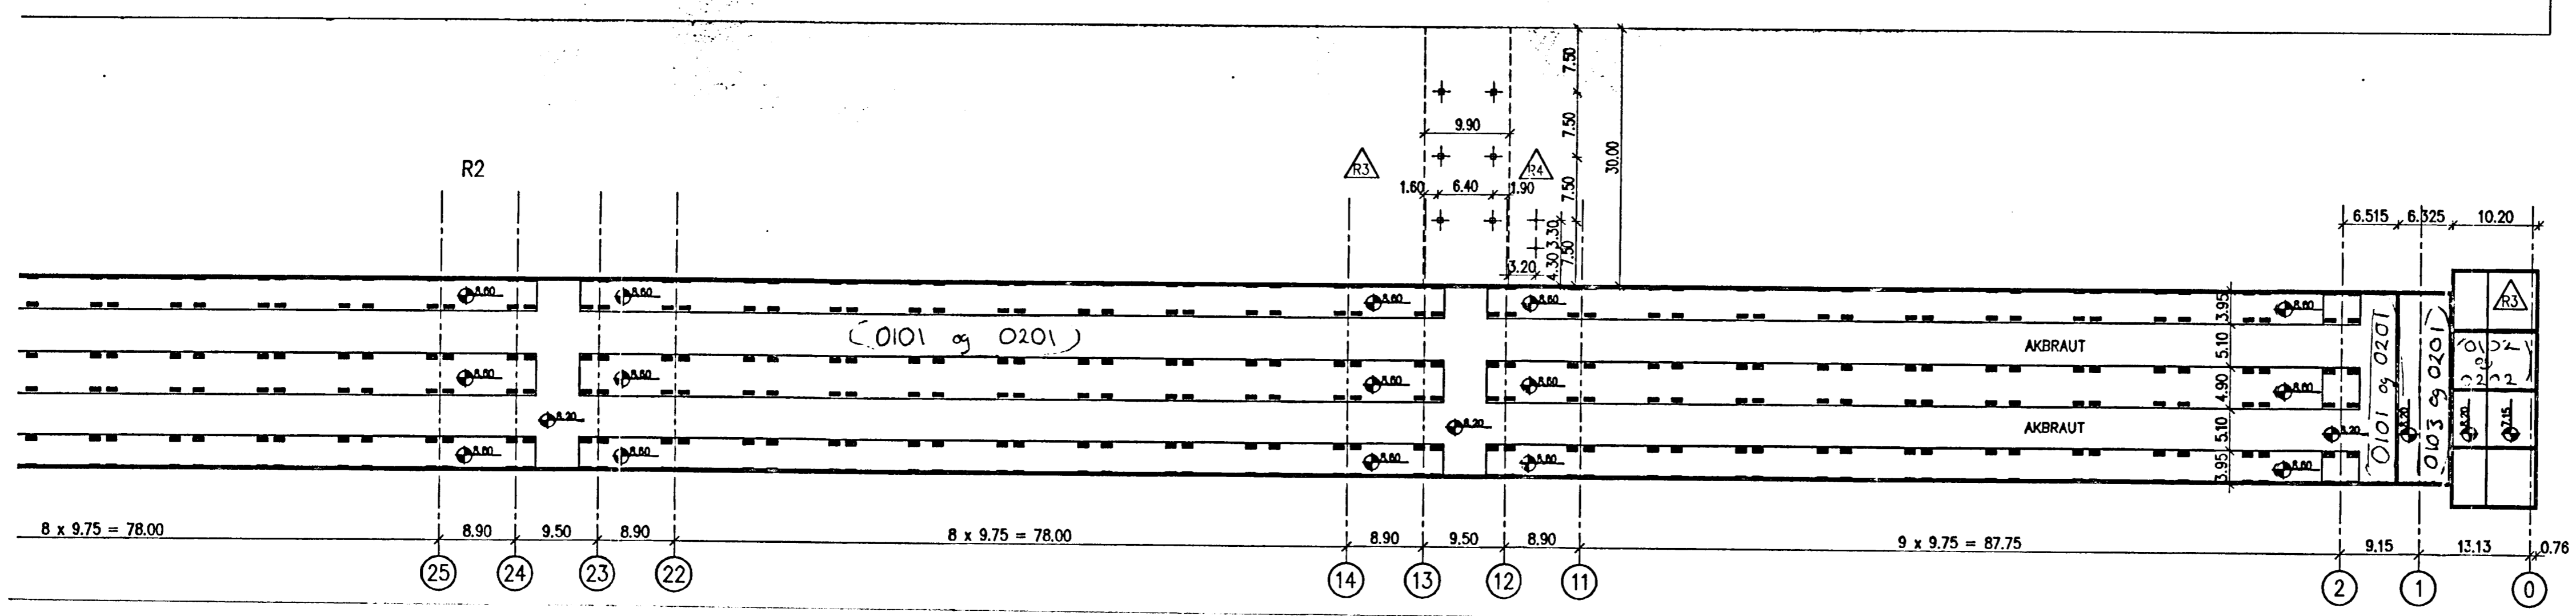

GRUNNMYND JARHAEDAR

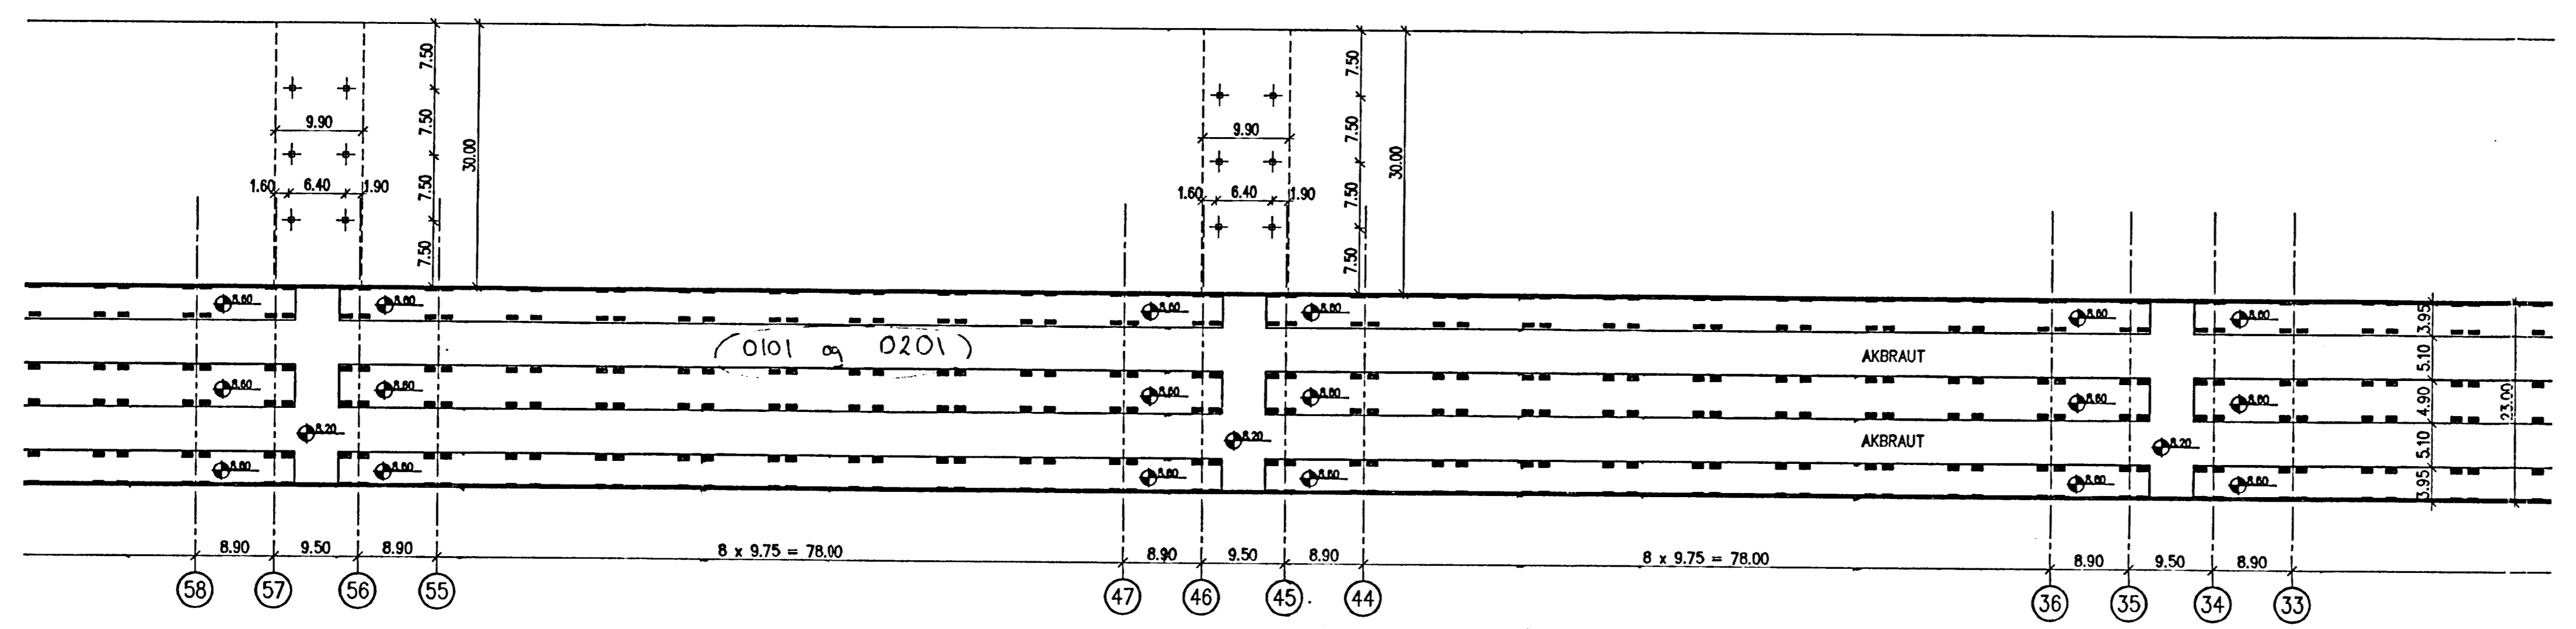

L total = 867.34  
 L 0101 (Keraskali) = 510.765  
 L 0102 (af-blettur) = 10.2  
 L 0103 (Lofur) = 6.325  
 L 0201 (Lofur) = 87.209  
 L 0202 (Lofur) = 10.2  
 L 0203 (Lofur) = 6.325

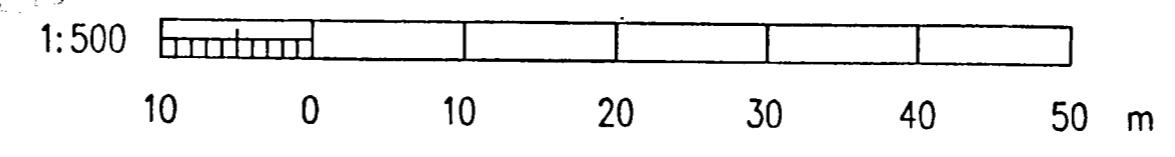

<b>Alcan á Íslandi hf.</b>			
Skráning matshluta bygginga í Straumsvík			
KERSKÁLI 3	123154	97	
<small>Heiti byggingar</small>	<small>Fastanúmer</small>	<small>Landnúmer</small>	<small>Matshlutanúmer</small>
<b>VST</b> Verkfræðistofa Sigurðar Thoroddsen hf. kt. 611276-0289			
<i>Niels Indriðason M</i>		2003-09-23	
<small>Niels Indriðason kt. 181144-3949</small>		<small>Dagsetning</small>	

REV. NO.	DATE	REVISION	BY	APP.	REV. NO.	DATE	REVISION	BY	APP.	NOTES	REFERENCE DRAWING	DRAWING NUMBER
4	1996.04.23	LOCATION OF SANITARY FACILITIES	NI									
3	96.03.01	LOCATION OF CORRIDORS/TENGINGANGAR FAERDIR. RECTIFIER.	NI									
2	1996.02.10	MINOR REVISION	NI									
1	1996.01.20	TENGINGANGAR	KS									

<b>VST</b>	VST CONSULTING ENGINEERS LTD. Armula 4 108 Reykjavík Iceland Tel: +354 569 5000 Fax: +354 569 5010			95.120 - 13.196	
	DRAWN NOV. 1995	APPROVED 6. NOV. '95	THIS 6. NOV. '95	POTROOM NO. 3 KERSKALI 3 ARCHITECTURAL WORK GROUND FLOOR JARHAED PLAN GRUNNMYND	
<b>ICELANDIC ALUMINIUM COMPANY LTD.</b>			79000-32696		
SCALE 1:500 FORMAT A1			ALUSUISSE ENGINEERING LTD. ZURICH SWITZERLAND		REVISION 4
ALUSUISSE ALESSA			ICELANDIC ALUMINIUM CO. LTD		22.186.594 Afrit af rafrænni útgáfu