


ATH!
SJA NÁVAR AFSTODUMYND
HAFNAR FÖRÐARÞÆÐAR
DAGSETT 1 JUNI 1989

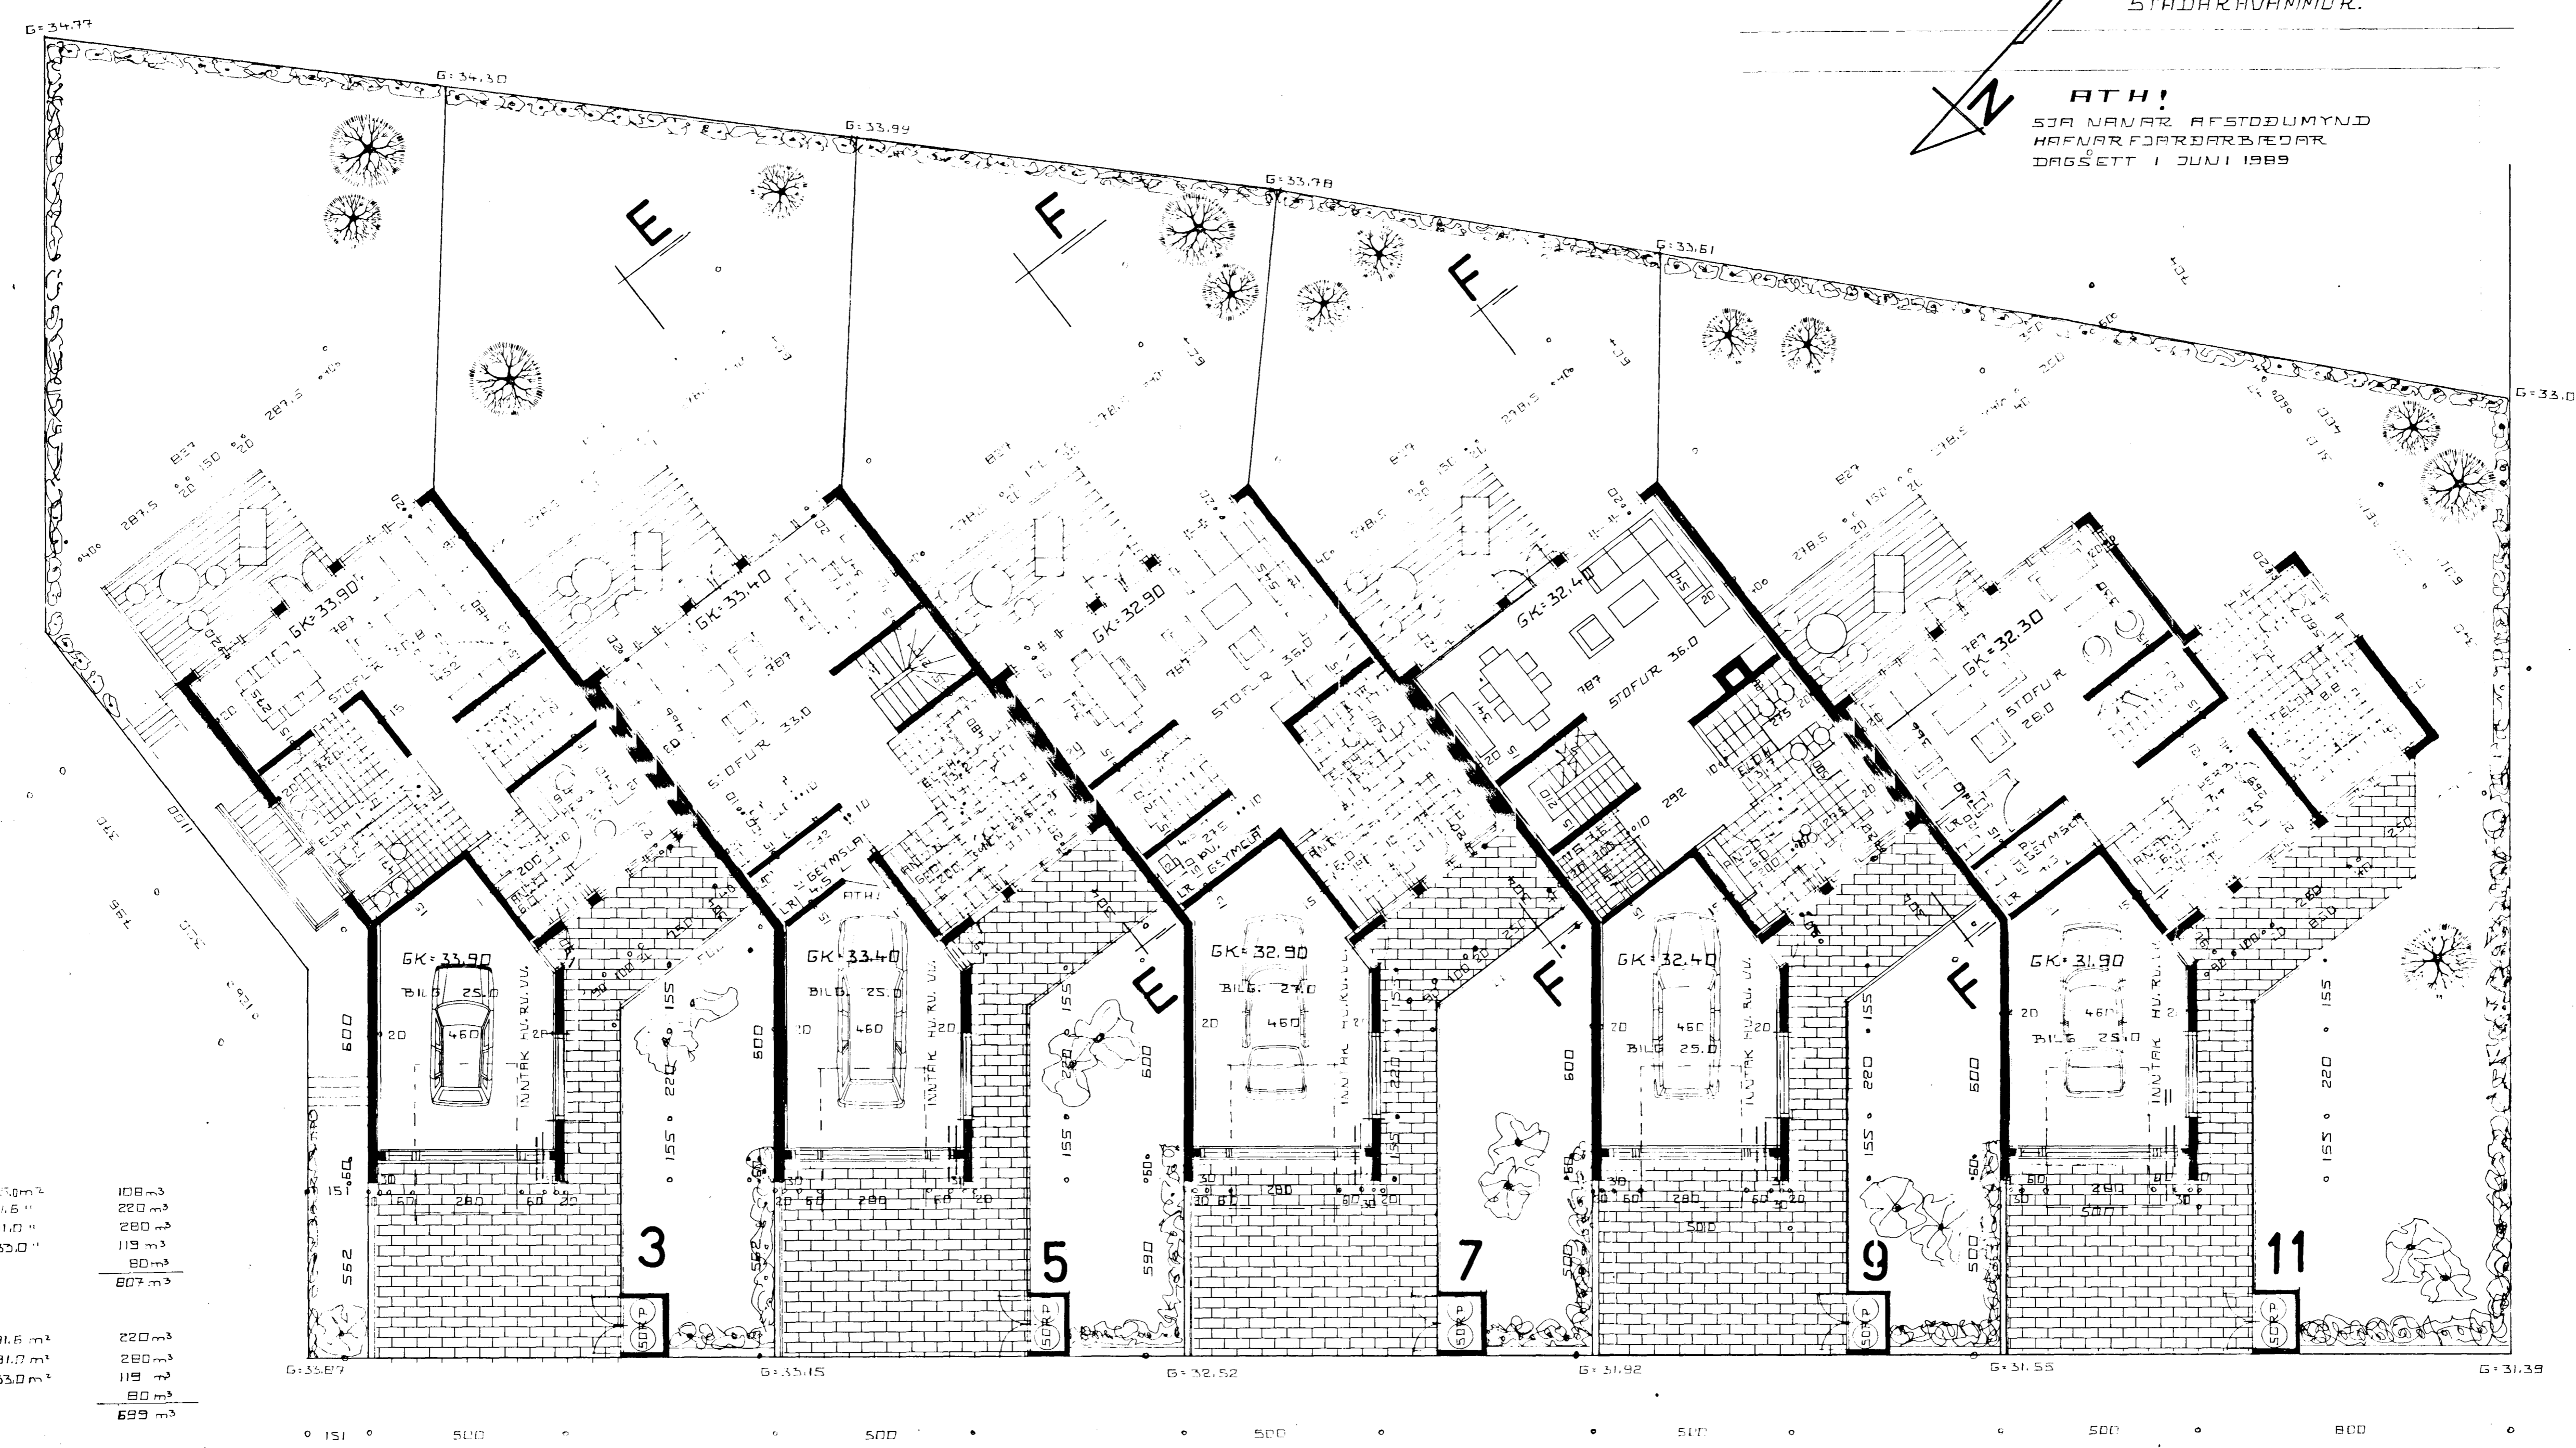

STÆRÐIR.

NR. 3.		
KJALLARI	43.0 m ²	108 m ³
1.H.	81.6 m ²	220 m ³
2.H.	91.0 m ²	280 m ³
BÍLG.	33.0 m ²	119 m ³
RIS		80 m ³
SAMTALS		607 m³
NR. 5. 7. 9. 8.		
1.H.	81.6 m ²	220 m ³
2.H.	91.0 m ²	280 m ³
BÍLG.	33.0 m ²	119 m ³
RIS		80 m ³
SAMTALS		699 m³
NR. 11		
1.H.	94.3 m ²	255 m ³
2.H.	103.7 m ²	294 m ³
BÍLG.	33.0 m ²	119 m ³
RIS		58 m ³
SAMTALS		726 m³

ATH! HURÐ MILLI BILGEYMSLU OG
LÖÐDAR Í NR. 5. SKAL VERA
SÖLFLOKANDI A-60 HURÐ

NR. 9. ÞR. Í ÁG. '88
ÞR. 1. NOV. '88
SVALIR, ÞAKLAUTI Á BÍLG
HAFNAR KOTI NR. 11
BILGEYMSLUR LENGDAR
OG AFSTODUMYND ÞR.
1. JUNI '89

KÖNNUNARTÖLUR SKV. BYGGINGAREGLUGERÐ
STADARHUAMMUR 3. S. 7. 9. OG 11
HAFNARFIRDI
JULI 1980 MKV 1:100 1:500 T. J.P. S.S. Þ.
GRUNNMÝND 4. HÍEÐ AFSTODUMYND OG SNÍÐ
DOHAN VEG PÉTURSSON FTFI
SIGURÐUR SIGURÐSSON