


VESTUR.

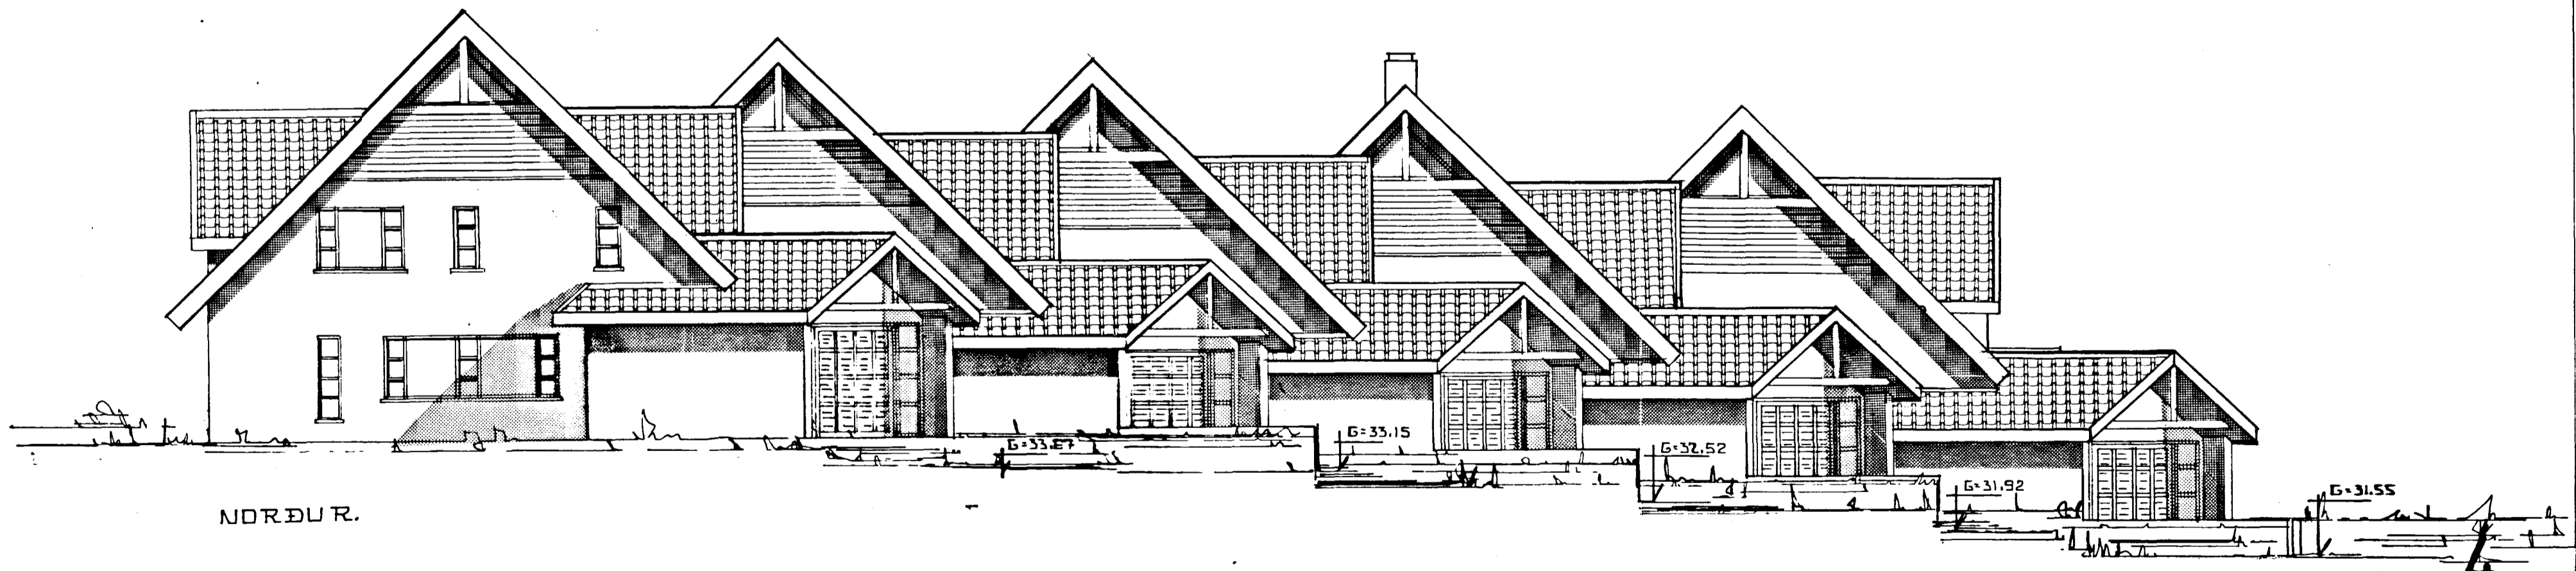

NORÐUR.

FR. SUGGAR NR. 5
 FEB. '89
fehto

NR 9 BR. 1 AG. '88
 BR 1 NOV '89
 SVARL. ÞAKHALLI BILG.
 HEDAR KOTI NR 11.

STADARHUAMMUR 3. 5. 7. 9 DG 11
 HAFNARFIRÐI
 JULI 1988 MKV 1:100 T. DP. 55. PI. 6LI.
 UTLIT
 JOHANNES PETURSSON FTFI
 SIGURÐUR SIGURSSON

3k

4