


Samþykkt á fundi byggingarvaldaráðs

19. 08. 1988
númer 28 / 7 1988

BYGGINGAVALTRÚINN

Í HAFNARFIRÐI

[Signature]

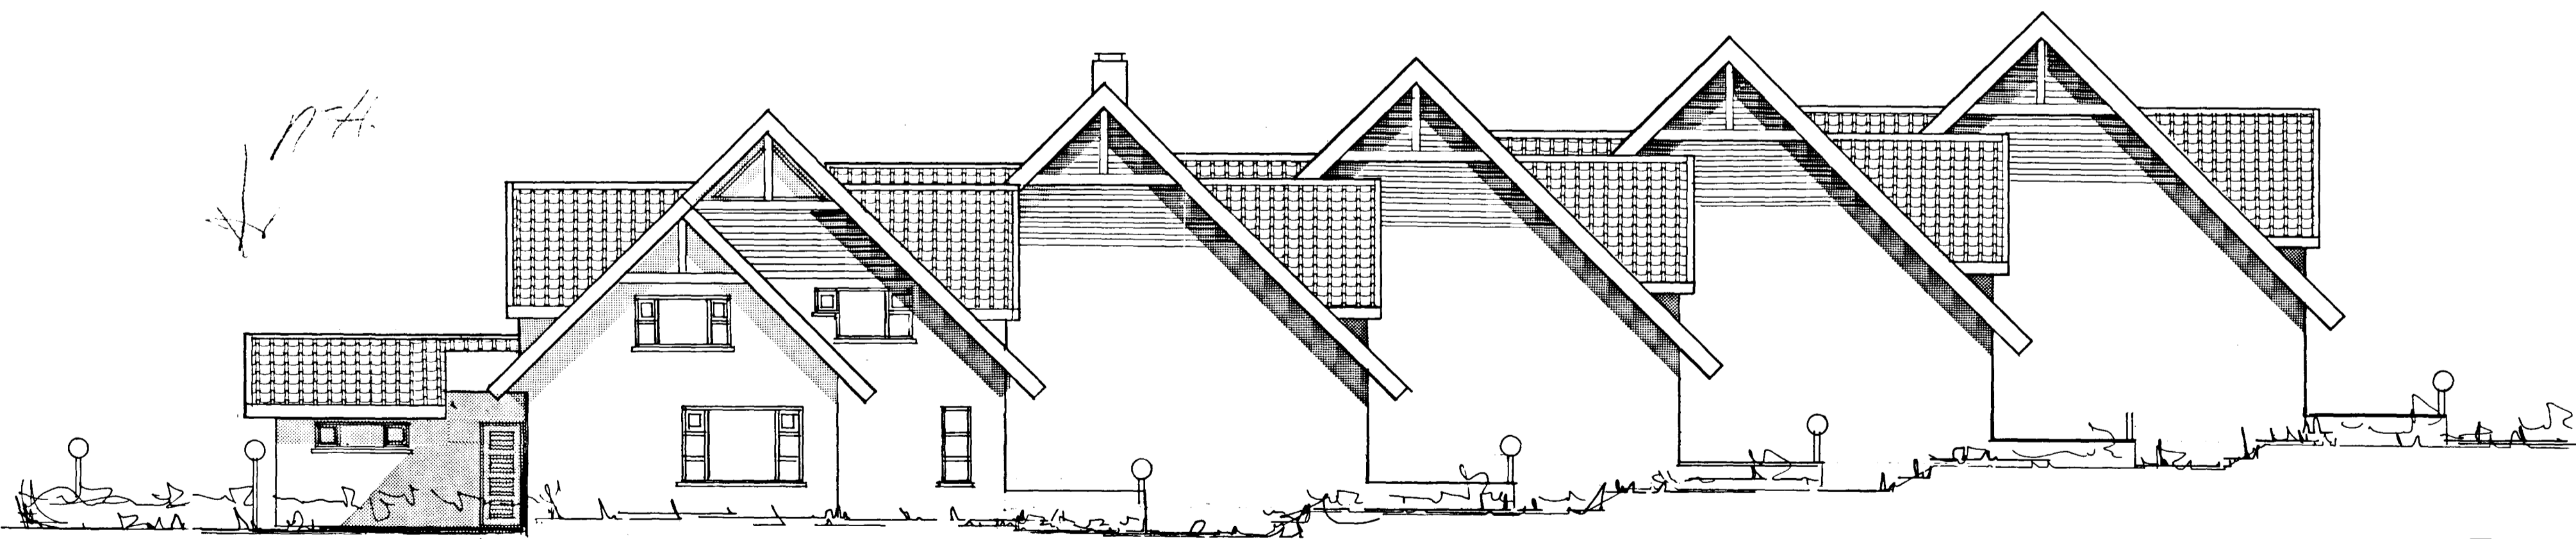

SUÐUR.

BR. GLUGGAR NR. 5
FEB '89

[Signature]

NR 9 BR. I AG. '88

BR. I NOV '88

SVALIR. PAKHALLI BILG.
HIEDAR KOTI NR 11

[Signature]

5

STADARHVAMMUR 3.5.7.9.0611

HAFNARFIRÐI

JULI 1988 MKV 1:100 T. DP. SS. PI. 61

UTLIT

JOHANNES PETURSSON FTFI

SIGURÐUR SIGURÐSSON

3K

[Signature]