


RÚMMYND-HITALAGNA x 1:50

Öfn nr	Staðsetn	Hitaþörf kcal/h	Lengd MM	m hæð tenging. MM	
101	STICAHÚS	030	2.200	600	AD
102	HJÓL VAGNAR	1.130	1.400	600	CD
103	HJÓN	1.220	1.600	600	AB
104	BAD	600	800	600	CD
105	STOFA	3.150	3.400	400	BC
106	ÞVOTTUR G	500	1.000	600	AB
107	BAKANDD	500	1.000	600	AB
108	ÞVOTTUR G	500	1.000	600	AB
109	STOFA	3.600	3.400	400	BC
110	BAD	600	800	600	CD
111	HOL	600	600	600	CD
112	HJÓN	1.310	1.600	600	CD
113	HERB	800	1.400	600	AB
114	ANDD	600	1.200	600	CD
201	STIGAH	1.600	2.200	600	AD
202	HERB	810	1.400	600	CD
203	HERB	810	1.400	600	CD
204	HJÓN	1.220	1.600	600	AB
205	BAD	600	800	600	CD
206	ÞVOTTUR G	400	1.000	600	AB
207	STOFA	2.100	3.400	400	BC
208	ELDH	1.300	1.600	400	AB
209	ELDH	1.300	1.600	400	CD
210	STOFA	2.400	3.400	400	BC
211	ÞVOTTUR	500	1.000	600	CD
212	HOL	600	700	600	AB
213	BAD	600	800	600	AB
214	HJÓN	1.300	1.600	600	CD
215	HERB	810	1.400	600	AB
216	HERB	810	1.400	600	AB
301	HERB	810	1.400	600	CD
302	HERB	810	1.400	600	CD
303	HJÓN	1.220	1.600	600	AB
304	BAD	600	800	600	CD
305	ÞVOTTUR G	400	1.000	600	AB
306	STOFA	2.100	3.400	400	BC
307	ELDH	1.300	1.600	400	AB
308	ELDH	1.300	1.600	400	CD
309	STOFA	2.400	3.400	400	BC
310	ÞVOTTUR G	500	1.000	600	BC
311	HOL	600	800	600	AB
312	BAD	600	800	600	AB
313	HJÓN	1.300	1.600	600	CD
314	HERB	810	1.400	600	AB
315	HERB	810	1.400	600	AB

SANTALE 4896

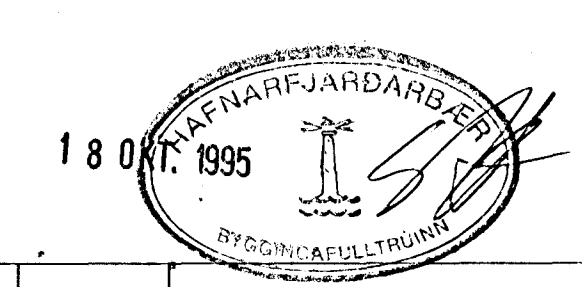

03	04.01.95	OFN NR 111 FREDUR	GH
02	OCT 94	OFNAR Á BACH FREDUR	GH
01	MARS 94	OFNAR 213 OG 312 HILUKKAR	GH
BR.	DAGS.	EDLI BR.	SIGN.

STECKJARBERG 2
HAFNARFIRÐI
RÚMMYND-HITALAGNA.

MÓJ x 1 50
DAGS SEPT '93
VERK NR. 9336
TEIKN NR. 2-06
HANNAD
TEIKNAD GH
YFIRFARIÐ