


GRUNNMYND 1 HÆÐAR 1:50

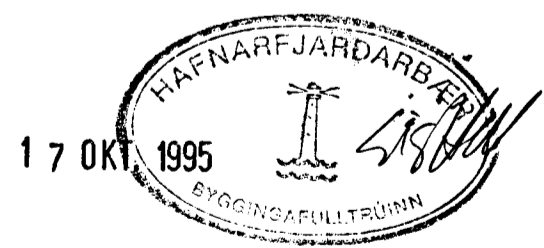

01	04.01.95	OFNAR NR 105 OG 112 FERIR	GK
BR.	DAGS.	EDLI BR.	SIGN.
		BADHERB. BREITT	

**STECKJARBERG 4
HAFNARFIRÐI**

HITA - VATNS - FRÆNNISLIS OG
LOFTRESTILAGNIR 1. HÆÐAR

MKV. x 1:50
DAGS. APRIL '94
VERK NR. 9403
TEIKN NR. 2-03
HANNAD
TEIKNAD GK
YFIRFARIÐ

GP TÆKNIJÓNUSTA
SIGURDAR ÞORLEIFSSONAR HF

STRANDGÖTU 11 - 220 HAFNARFJÖRÐUR - SÍMI 54255 - FAX 652875