


GRUNNMYND 1 HÆÐAR 1:50

01	OKT 95	ELDHÚSUM BR.	GH
BR.	DAGS.	EDLI BR.	SIGN.

STECKJARBERG 6
HAFNARFIREÐI

HITA - VATN - FRÆUNSLIS OG
LOFTRESTILAGLIP

14 NOV 1995

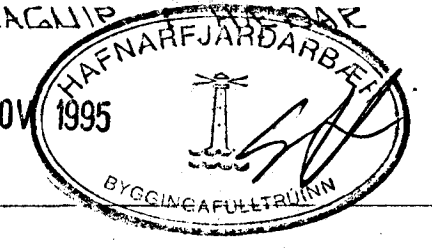

MKV. 1:50
DAGS. MAI 95
VERK NR. 9520
TEIKN NR. 2-03
HANNAD
TEIKNAD GH
YFIRFARIÐ

TÆKNIPJÓNUSTA
SIGURDAR ÞORLEIFSSONAR HF

STRANDGÖTU 11 - 220 HAFNARFJÖRDUR - Sími 54255 - FAX 662875