


GRUNNMYND 1 HÆÐAR 1:50

01	OCT '95	PIG. ELDHÚSLIM BR	GH
BR.	DAGS.	EDLI BR.	SIGN.

STECKJARBERG 8  
HAFNARFIRÐI

HITA - VATNIS - FRÆNNISLIS OG  
LOFTRÆSTILAGNINGAR

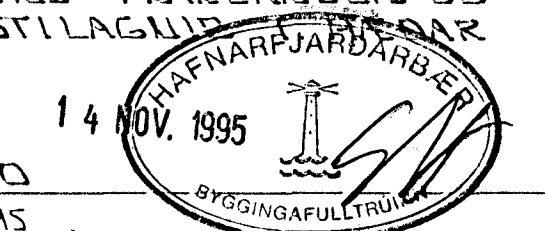

MKV. x 1:50
DAGS. MAI '95
VERK NR. 9521
TEIKN NR. 2-03
HANNAÐ
TEIKNAD GH 21
YFIRFARIÐ

**TEKNIÞJÓNUSTA**  
**SIGURÐAR ÞORLEIFSSONAR HF**  
STRANDGÖTU 11 - 220 HAFNARFJÓRÐUR - Sími 54255 - FAX 652875