


GRUNNMÝND 2 HÆÐAR 1:50

01	OKT '95	ELDHÚSUM BR.	GH
BR.	DAGS.	EDLI BR.	SIGN.

STECKJARBERG 8 HAFNARFIRÐI

HITA-VATNIS-FRÆRENNISLIS OG
LOFTKÆSTILAGNIR 2 HÆÐAR

MKV 1:50 14 NOV. 1995
DAGS. MAI '95
VERK NR. 9521
TEIKN NR. 2-04
HANNAD
TEIKNAD GH 20
YFIRFARIÐ

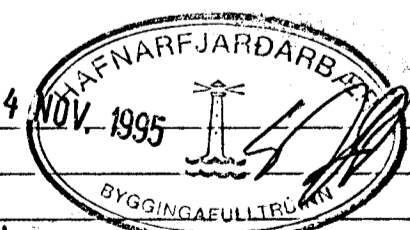

TEKNIÞJÓNUSTA
SIGURDAR ÞORLEIFSSONAR HF

STRANDGÖTU 11 • 220 HAFNARFJÖRDUR • SÍMI 54255 • FAX 652875