


GRUNNMYND 3 HÆÐAR 1:50

DI	OKT '95	ELDHÚSLIM ISR	GH
BR.	DAGS.	EDLI BR.	SIGN.

STECKJARBERG 8
HAFNARFIRÐI

HITA-VATNIS - FRÆMENNIS OG
LOFTKRÆSTILAGNIR 3 HÆÐAR

MKV 1:50 14
DAGS. MAÍ '95
VERK NR. 9521
TEIKN NR. 2-08
HANNAD
TEIKNAD GH Sig
YFIRFARIÐ

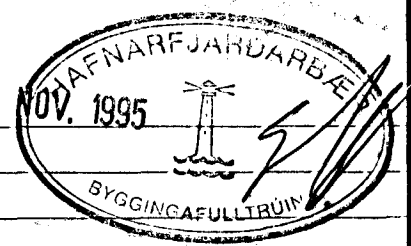

GF TÆKNIJÓNUSTA
SIGURDAR ÞORLEIFSSONAR HF