

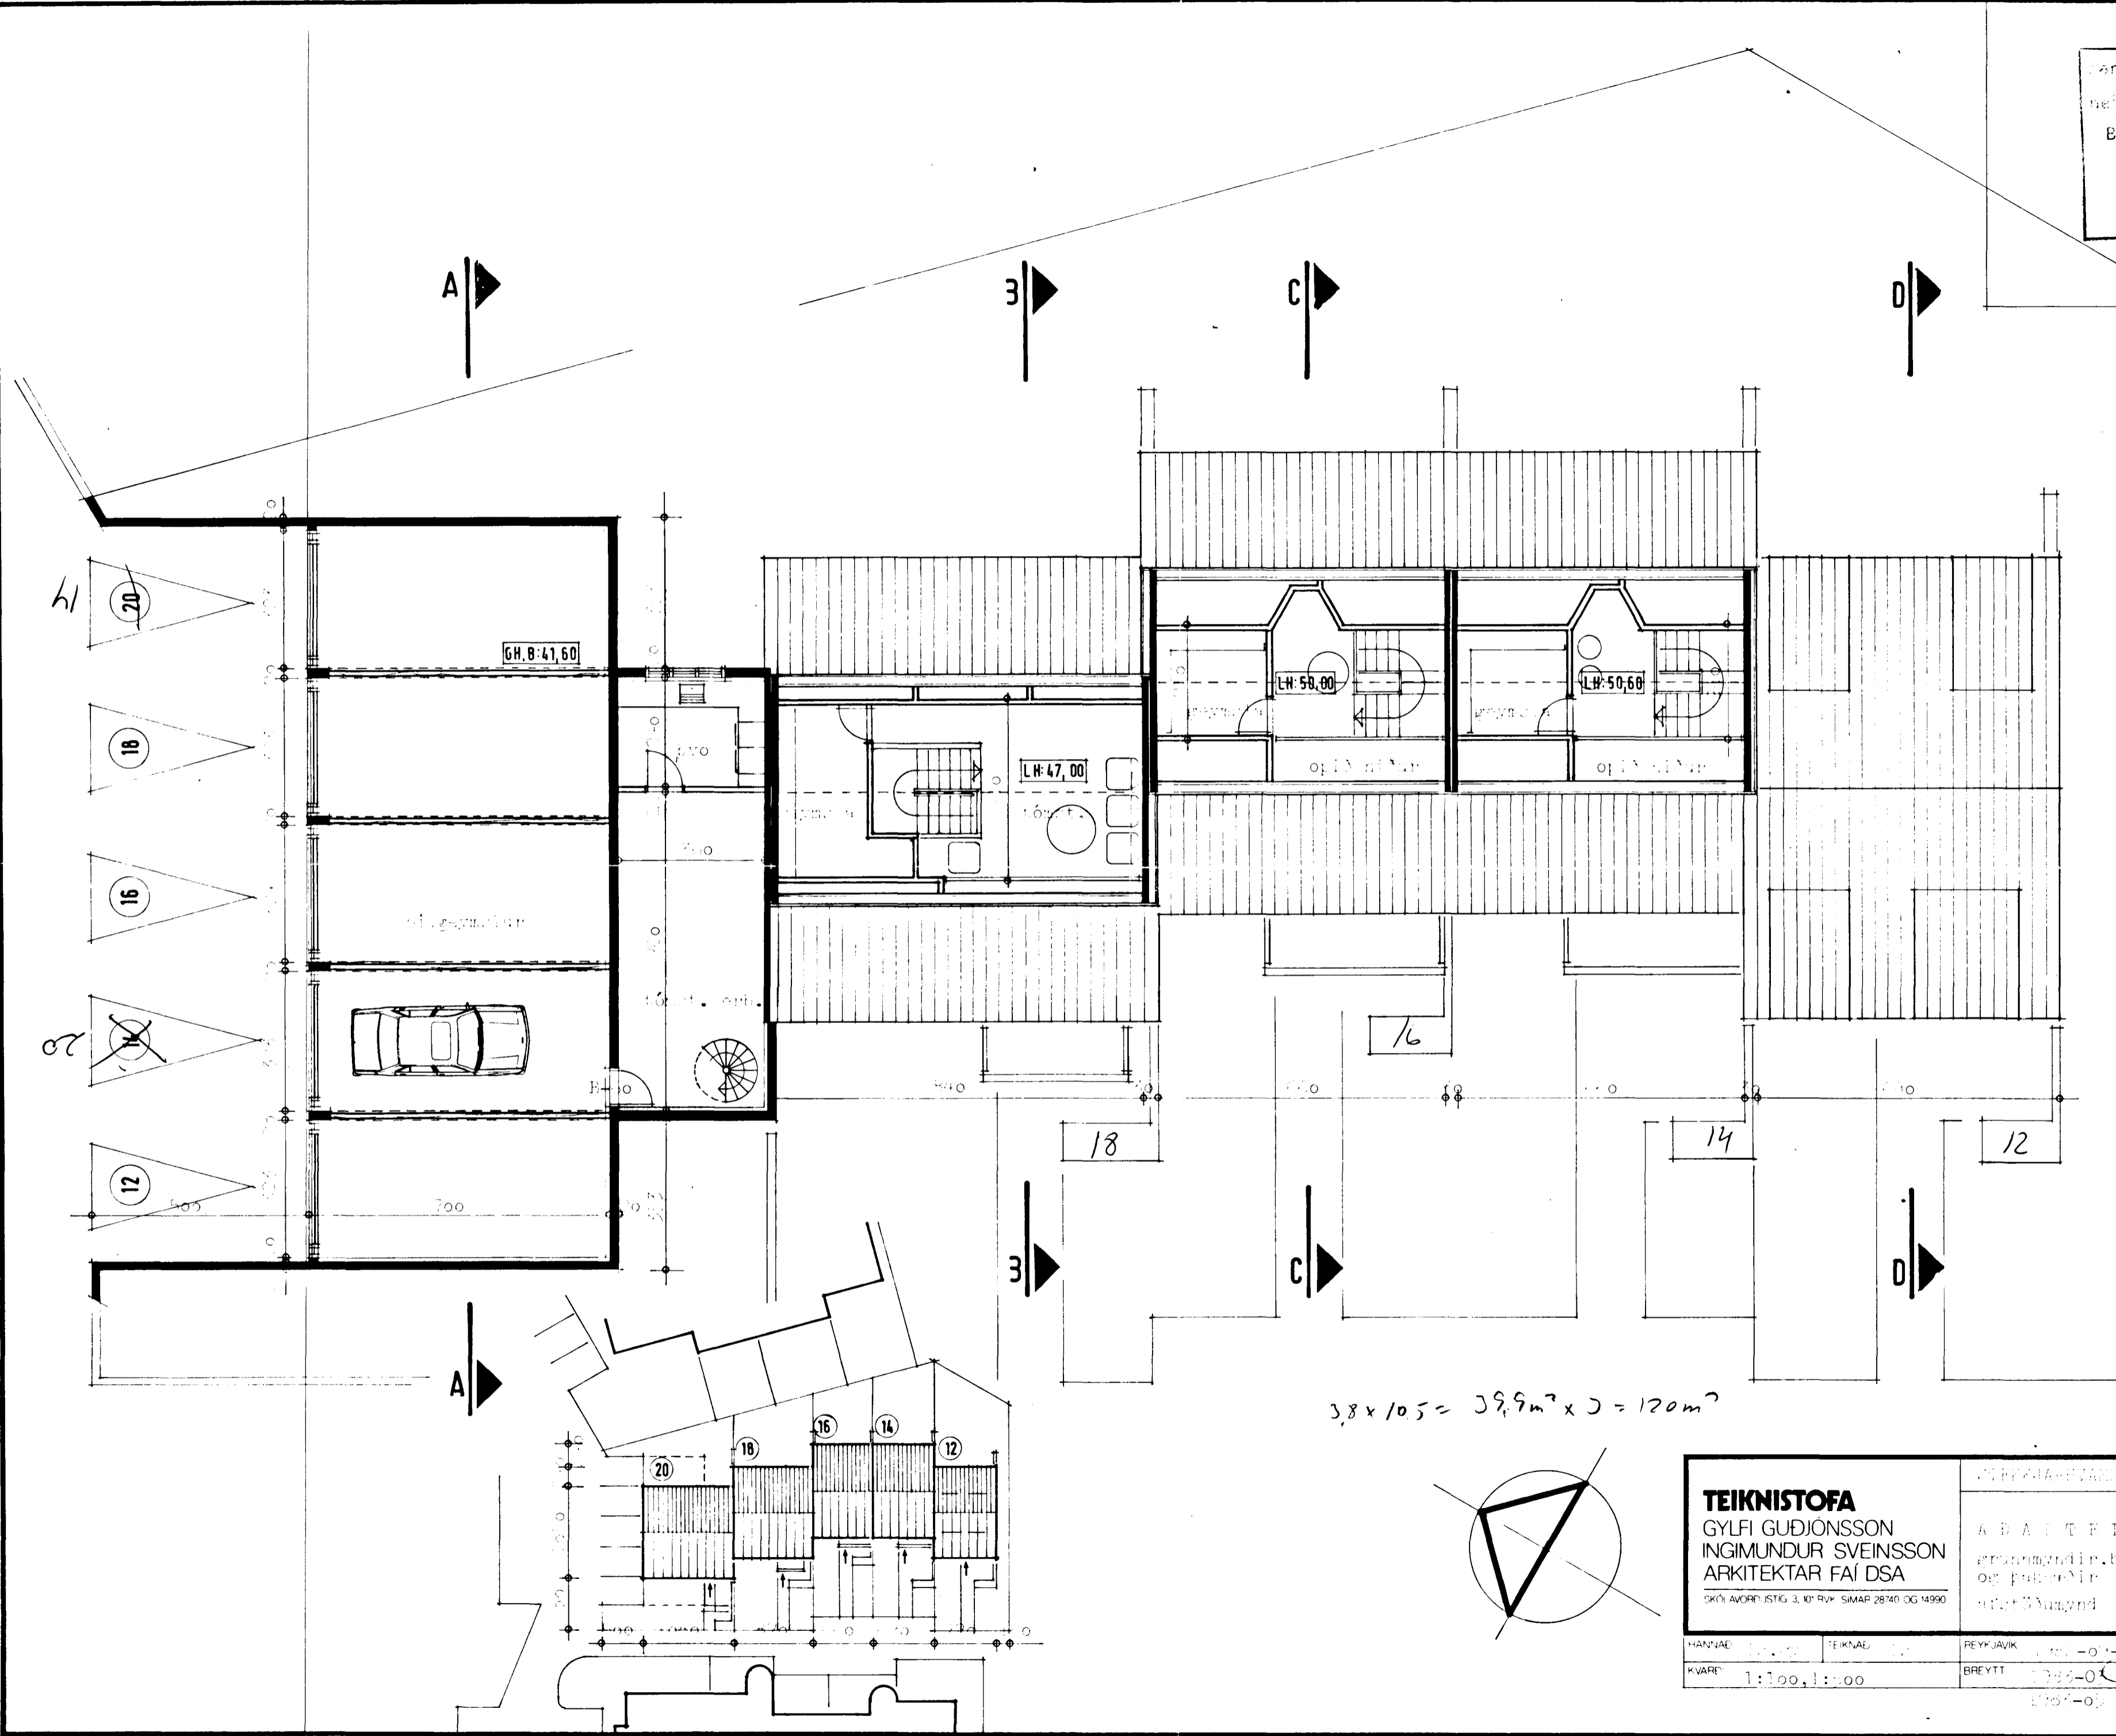


29/9 82  
 27/12 82  
 ark. Mt á fundi bygginga-  
 nefndar 415. 12. 82  
 BYGGINGA-  
 I HAFNAFIRÐI  
*[Signature]*

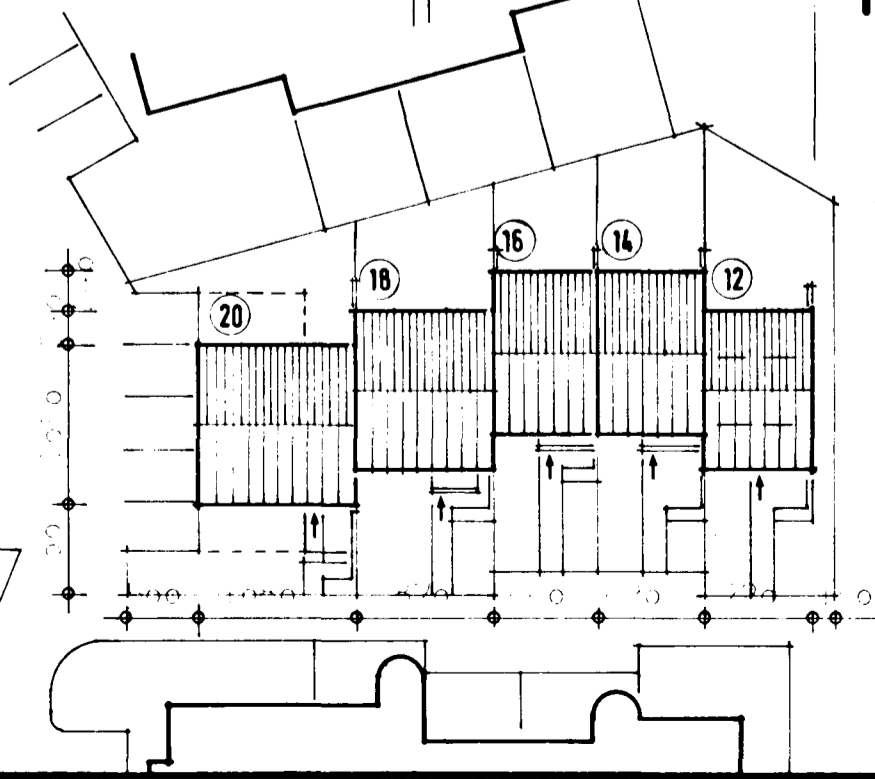

$3,8 \times 10,5 = 39,9m^2 \times 3 = 120m^2$

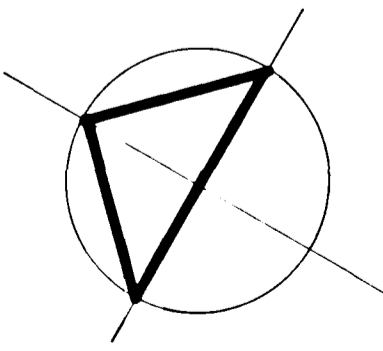

<b>TEIKNISTOFA</b> GYLFI GUÐJÓNSSON INGIMUNDUR SVEINSSON ARKITEKTAR FAÍ DSA <small>SKÓLAVORÐJÓSTIG 3, 101 RÚK SIMAR 28740 OG 14990</small>		BYGGINGA- NEFNDIN OG BYGGINGA- NEFNDIN	VERK BLAD <b>103</b>
